


VILLAGE OF MILLERSBURG
 PART OF LOT 218
 HOLMES COUNTY, OHIO

RESURVEY OF DEED VOL. 253 PAGE 244


SURVEYED FOR: CINDY MATHIE

REFERENCES:

- DEED VOL. 206 PAGE 633
- DEED VOL. 253 PAGE 244
- O.R. VOL. 83 PAGE 479
- PLAT VOL. 18 PAGE 33
- BEARINGS FROM PLAT VOL. 18 PAGE 33

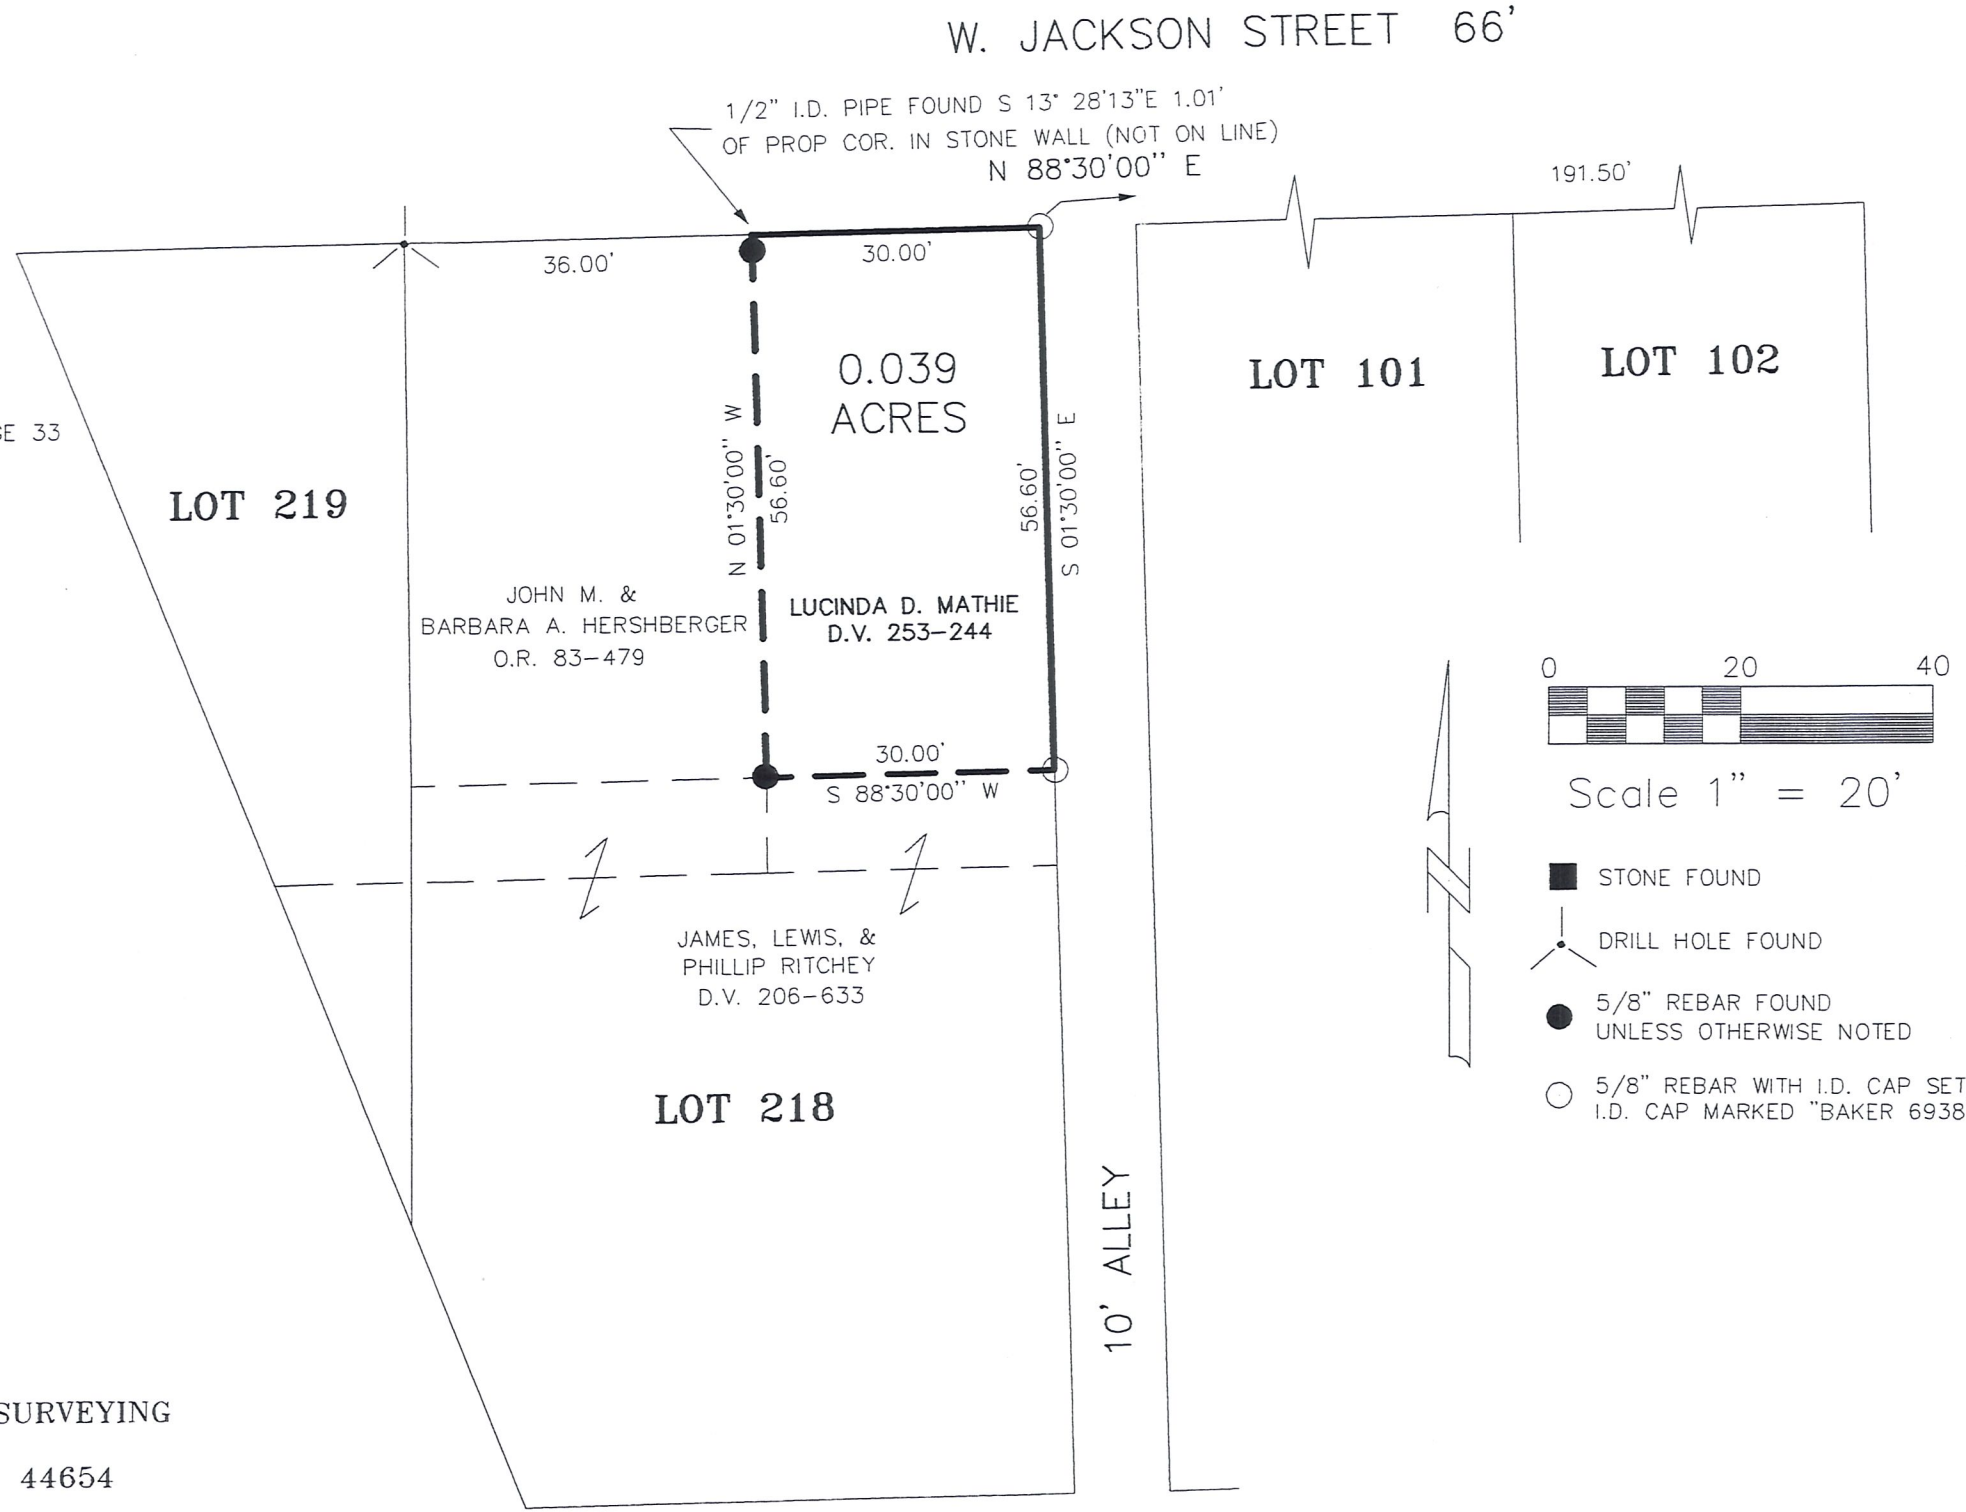

S. MAD ANTHONY STREET 49.5'

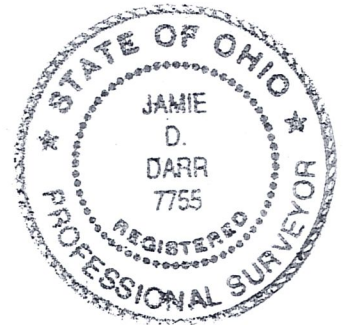

I CERTIFY THIS SURVEY TO BE CORRECT TO THE BEST OF MY KNOWLEDGE.

Jamie D. Darr
 JAMIE D. DARR P.S. 7755

APRIL 18, 2003 JDD/FCC

File Name: C:\JOBS1\S-191-03\ERZ

DONALD C. BAKER SURVEYING
 138 N. CLAY ST.
 MILLERSBURG, OHIO 44654
 PH. 330-674-4788
 FAX 330-674-6027