


VILLAGE OF MILLERSBURG  
 LOTS 266 & 267 AND  
 A VACATED ALLEY (ORD. 389)  
 HOLMES COUNTY, OHIO

SURVEYED FOR: JOE McMANAWAY

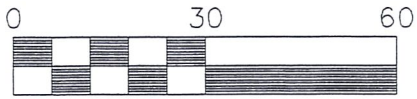



Scale 1" = 30'

- 5/8" REBAR FOUND  
UNLESS OTHERWISE NOTED
- 5/8" REBAR WITH ID CAP SET  
ID CAP MARKED "BAKER 6938"



NOTE: THIS PLAT IS FOR THE PURPOSE OF  
 SHOWING MONUMENTS SET AND FOUND

BEARINGS FROM  
 JIM SHAMP SURVEY JANUARY 1995

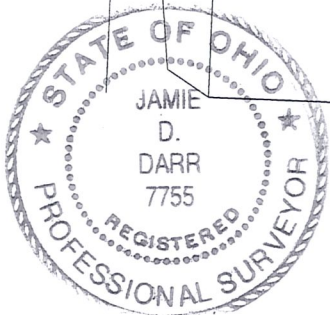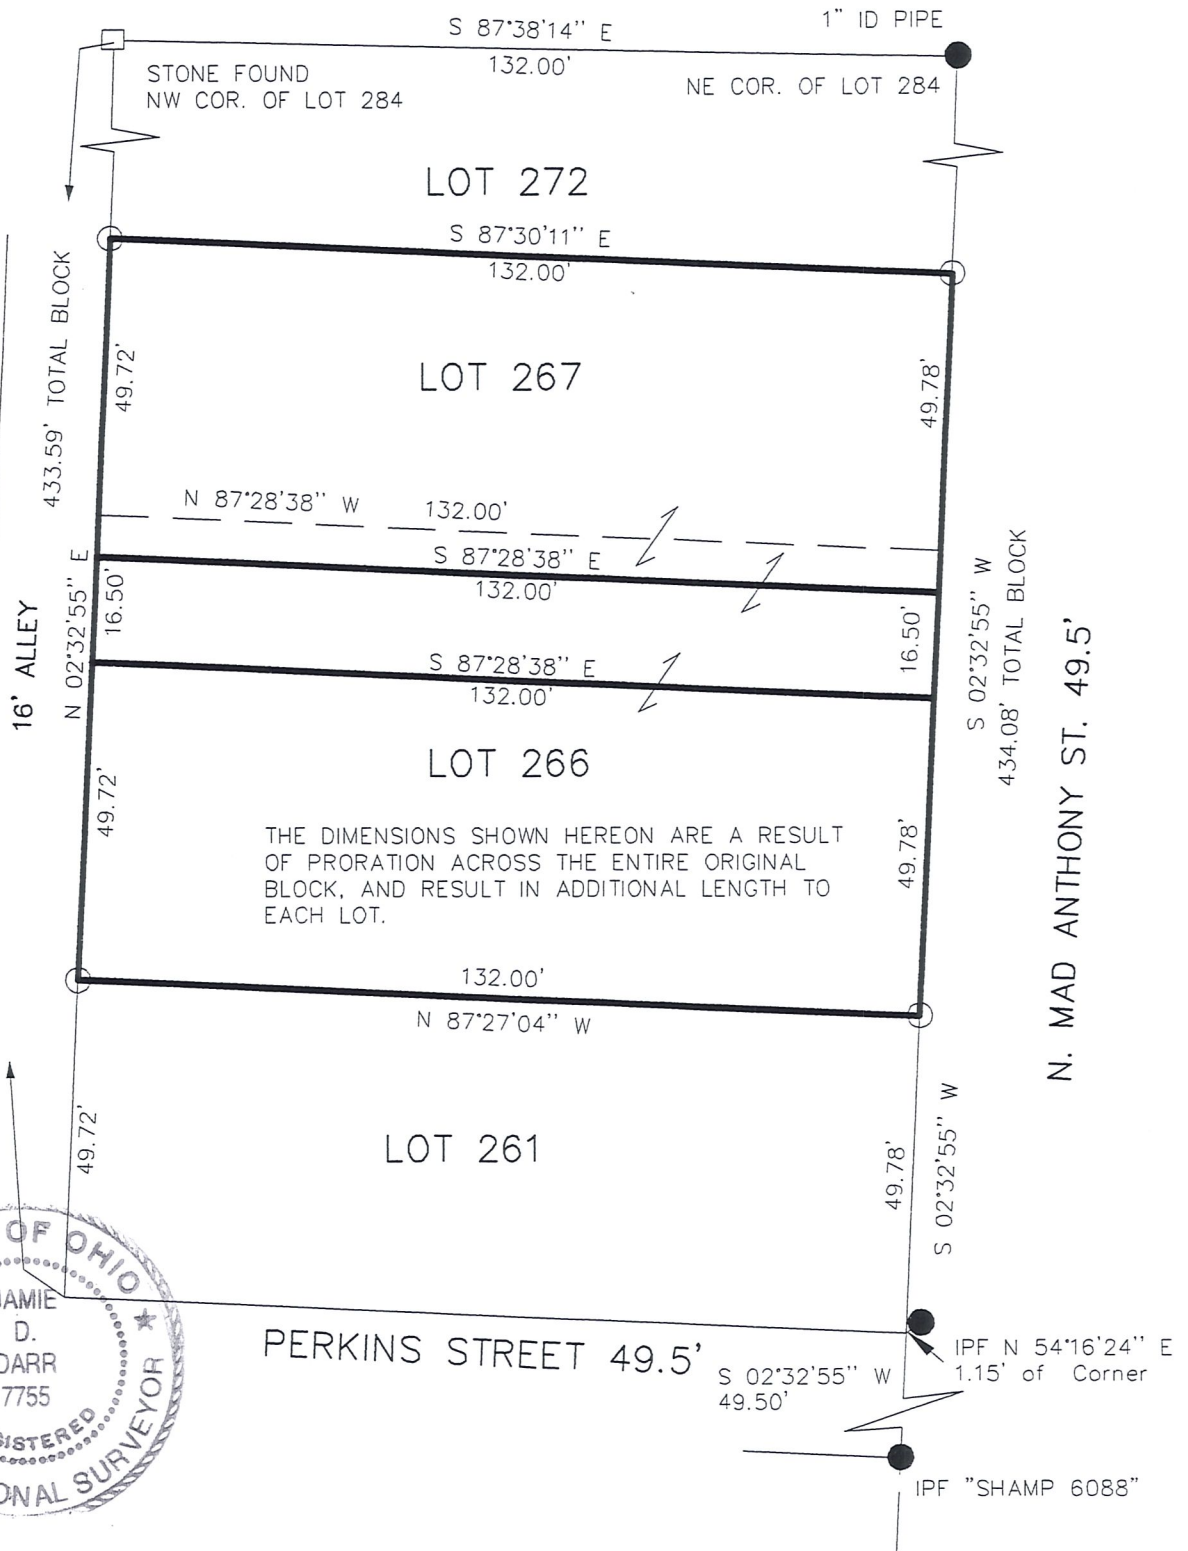

I CERTIFY THIS SURVEY TO BE CORRECT  
 TO THE BEST OF MY KNOWLEDGE.

*Jamie D. Darr*  
 JAMIE D. DARR P.S. 7755  
 DATE: SEPTEMBER 3, 2004

File Name: C:\JOBS1\S--590-04\ERZ\MLD



DONALD C. BAKER SURVEYING  
 138 N. CLAY ST.  
 MILLERSBURG, OHIO 44654  
 PH. 330-674-4788  
 FAX. 330-674-6027