


VILLAGE OF MILLERSBURG
 PART OF OUT LOT 7 (LOCATED IN S.W. QTR. SEC. 11)
 T-9 N ; R-7 W
 HOLMES COUNTY, OHIO

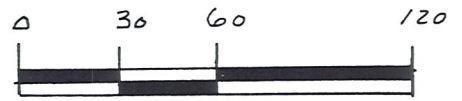


SCALE: 1" = 60'

- 1 IRON PIN FOUND
- 5/8" RE BAR WITH I.D. CAP SET
- I.D. CAP MARKED "BAKER 6938"

REFERENCES:

DEED Vol. 205 PAGE 978
 " " 190 " 64
 " " 271 " 512
 SURVEY RECORD 5 pg. 194

BEARINGS FROM PLAT Vol. 12
 PAGE 356

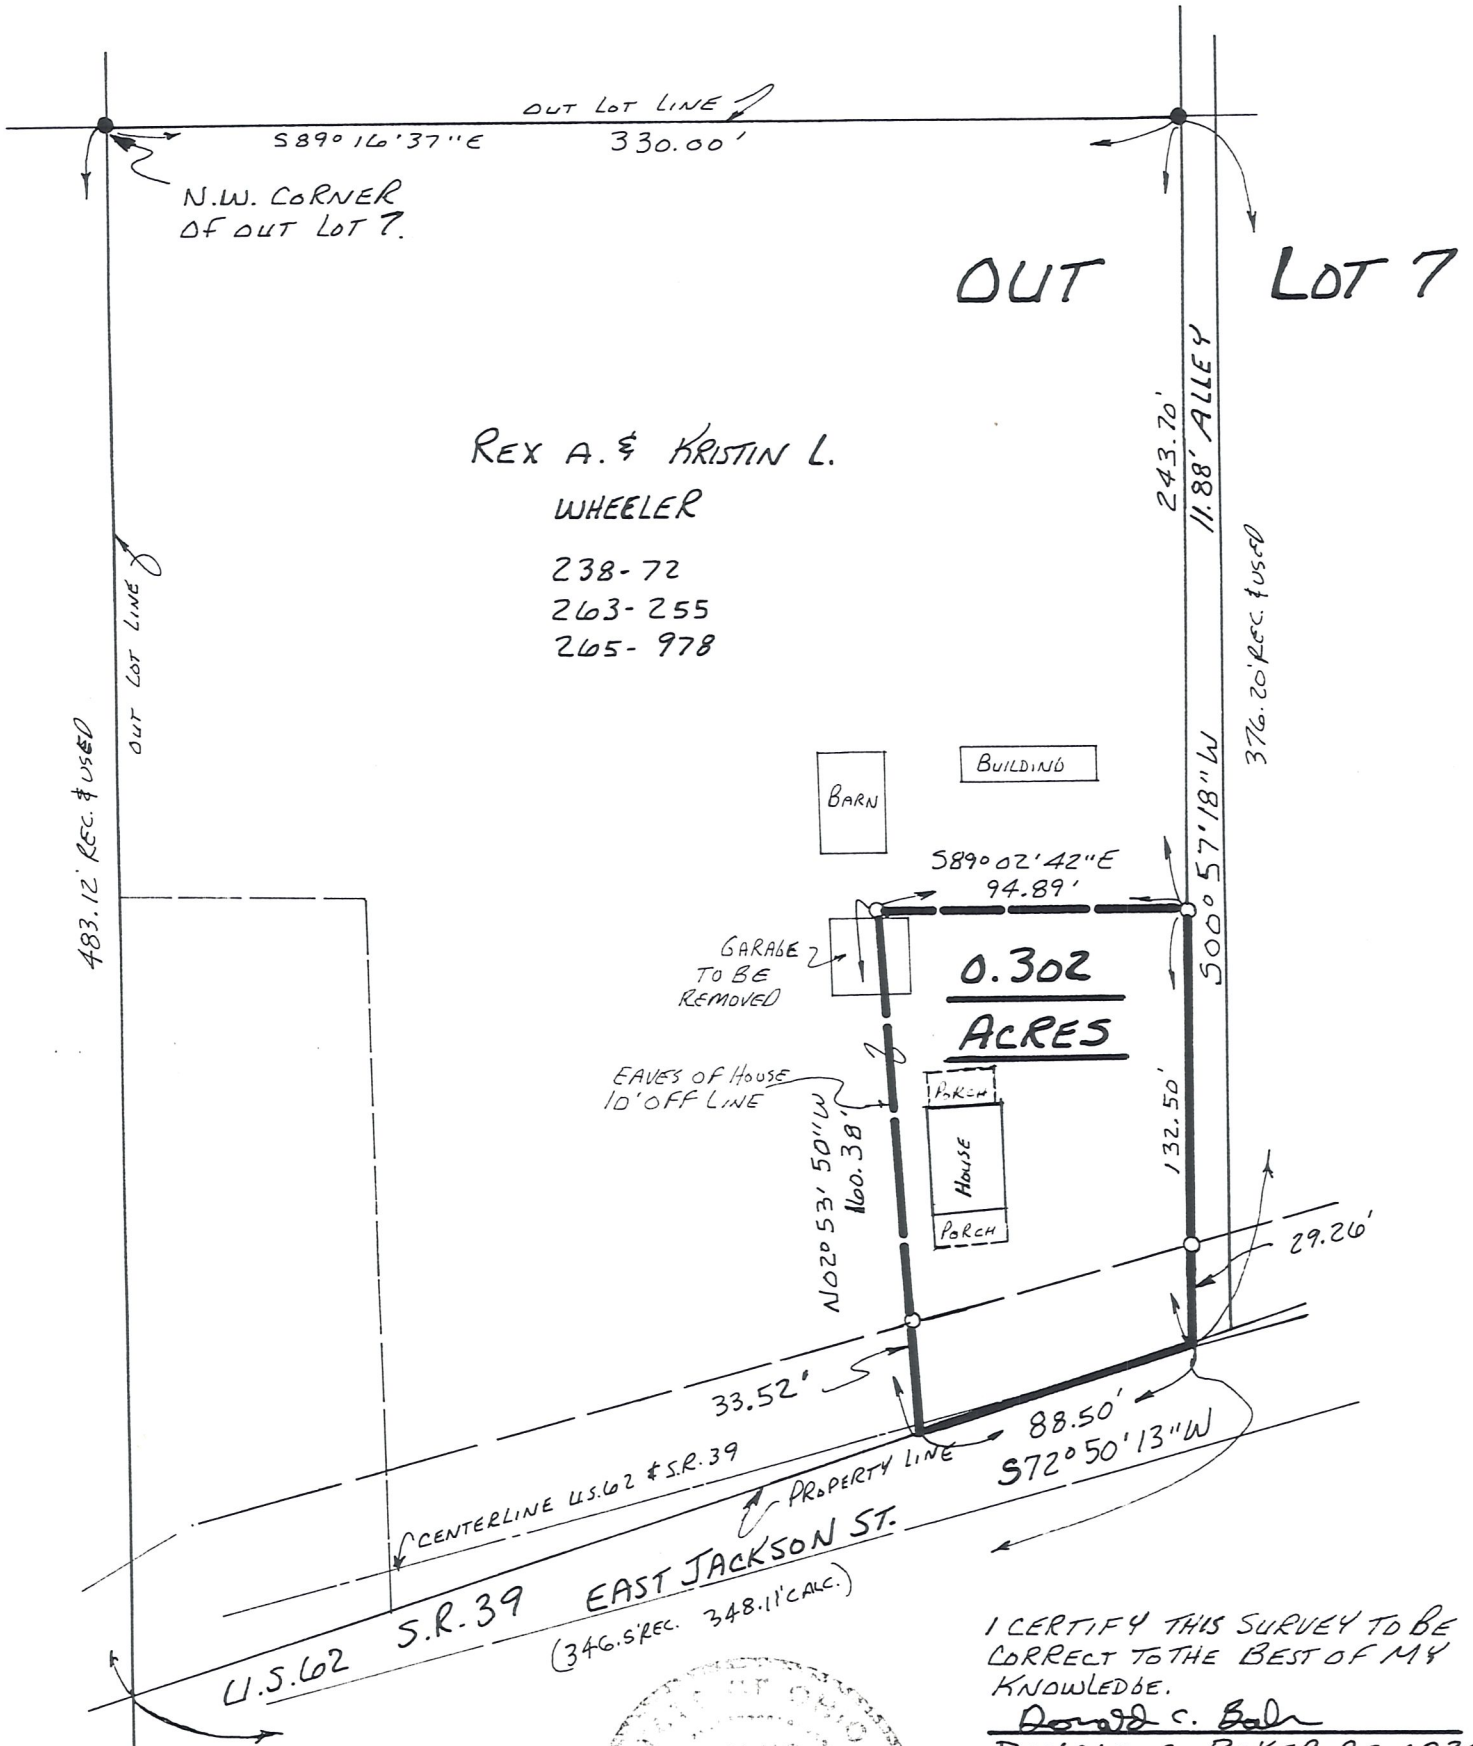

REX A. & KRISTIN L.
 WHEELER
 238-72
 263-255
 265-978



I CERTIFY THIS SURVEY TO BE CORRECT TO THE BEST OF MY KNOWLEDGE.

Donald C. Baker
 DONALD C. BAKER P.S. 6938
 5958 T.R. 322
 MILLERSBURG, OHIO 44654
 PH. (216) 674-4788
 FEBRUARY 5, 1996