


SITE PLAN:  
BRAMBLY HEDGE KNOLL  
CONDOMINIUMS

VILLAGE OF MILLERSBURG  
PART OF OUT LOT 7  
HOLMES COUNTY, OHIO

PREPARED FOR: REX WHEELER


PREPARED BY:  
DONALD C. BAKER SURVEYING

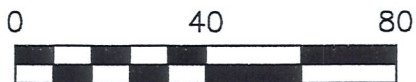


SCALE: 1"=40'

● 5/8" REBAR FOUND  
UNLESS OTHERWISE NOTED

ALL BEARINGS AND DATA ARE TAKEN FROM  
ORIGINAL SURVEY RECORDED IN  
PLAT VOL. 16 PAGE 270.

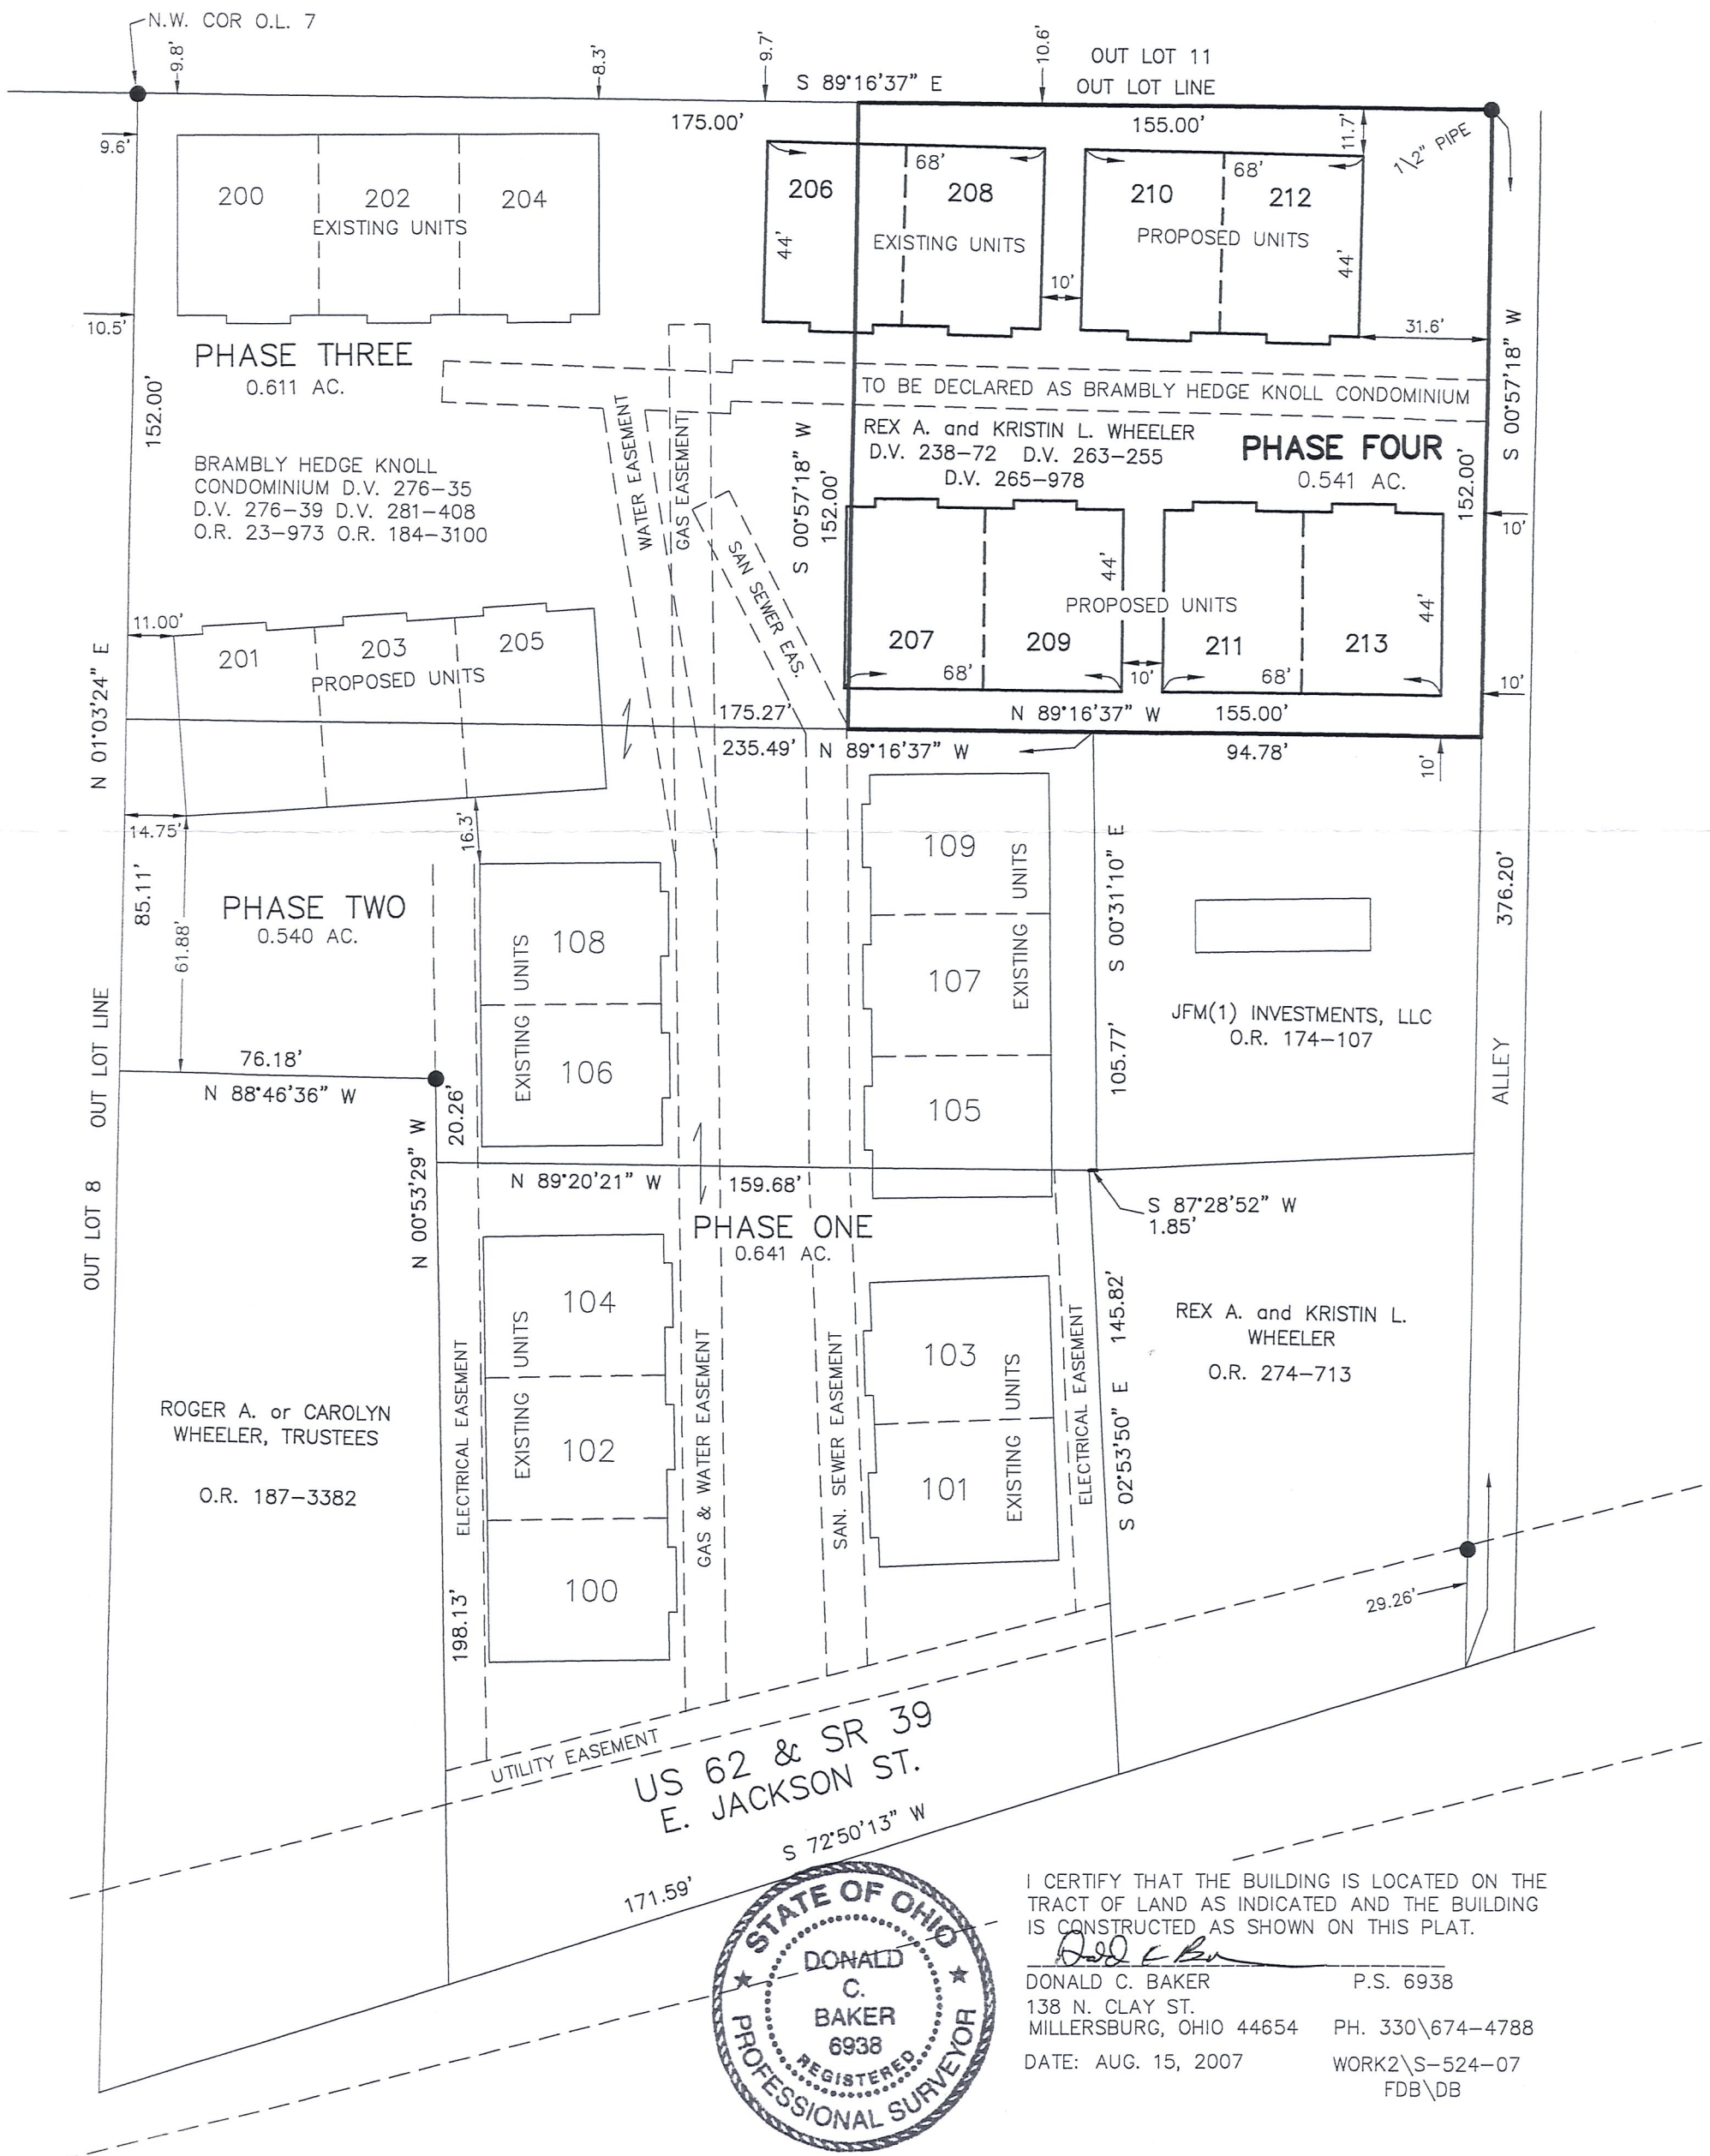

US 62 & SR 39  
E. JACKSON ST.  
S 72°50'13" W

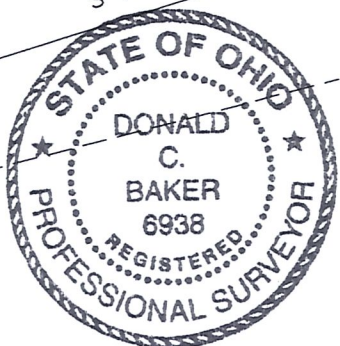

I CERTIFY THAT THE BUILDING IS LOCATED ON THE  
TRACT OF LAND AS INDICATED AND THE BUILDING  
IS CONSTRUCTED AS SHOWN ON THIS PLAT.  
*Donald C. Baker*  
DONALD C. BAKER P.S. 6938  
138 N. CLAY ST.  
MILLERSBURG, OHIO 44654 PH. 330\674-4788  
DATE: AUG. 15, 2007 WORK2\S-524-07  
FDB\DB