


Does Not Match

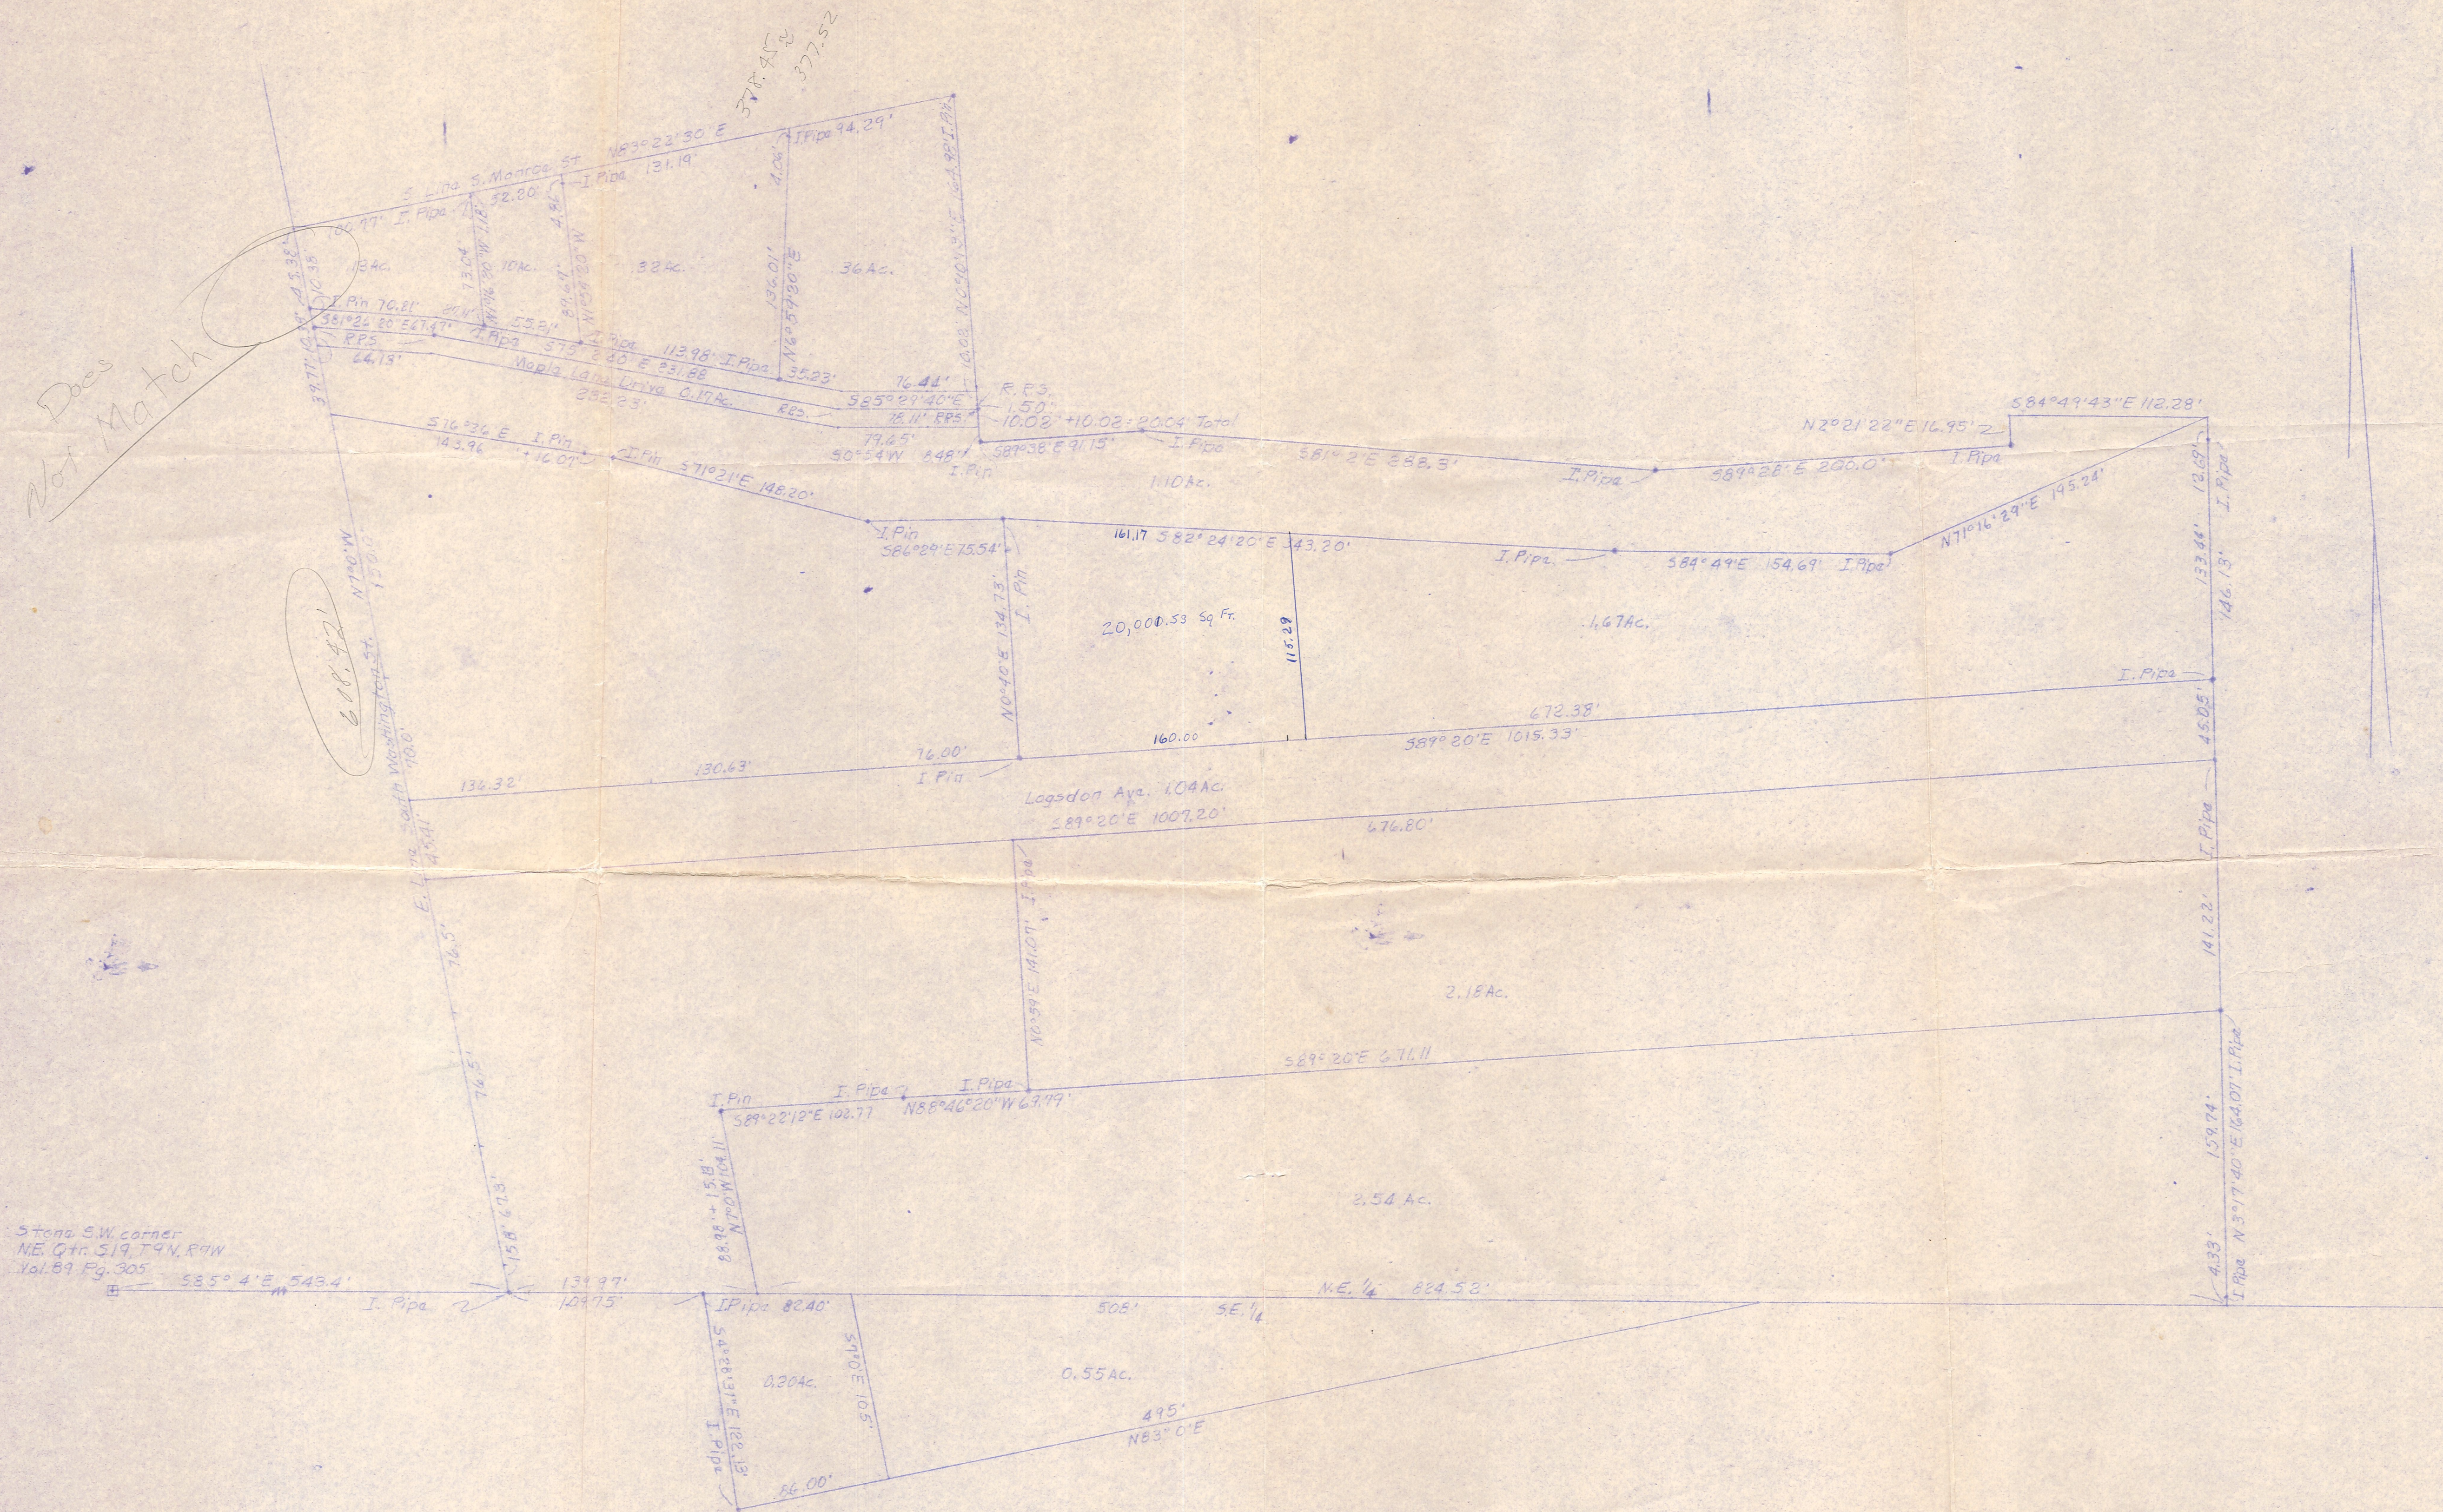

MAP OFFICE COPY

PLAT OF A SURVEY OF LANDS OF
 HARRY C. LOGSDON (Deed)
 Known as part of N.E. + S.E. 1/4 519 T41N E
 R7W, of Hardy Twp, Holmes Co., Ohio
 Robert L. Kosnar, Registered Surveyor #5143 1972