

- IRON PIN FOUND
- ⊗ P.K. NAIL SET
- 5/8" REBAR WITH I.D. CAP SET
- I.D. CAP MARKED "BAKER 6938"



REFERENCES:

DEED Vol. 277 PAGE 351
 PLAT Vol. 8 PAGE 76
 " " 14 " 346
 " " 1 " 31


RESURVEY OF LOT 328

BEARINGS FROM PLAT Vol. 1 Pg. 31

VILLAGE OF MILLERSBURG
 LOT 328
 HARDY TOWNSHIP
 HOLMES COUNTY, OHIO

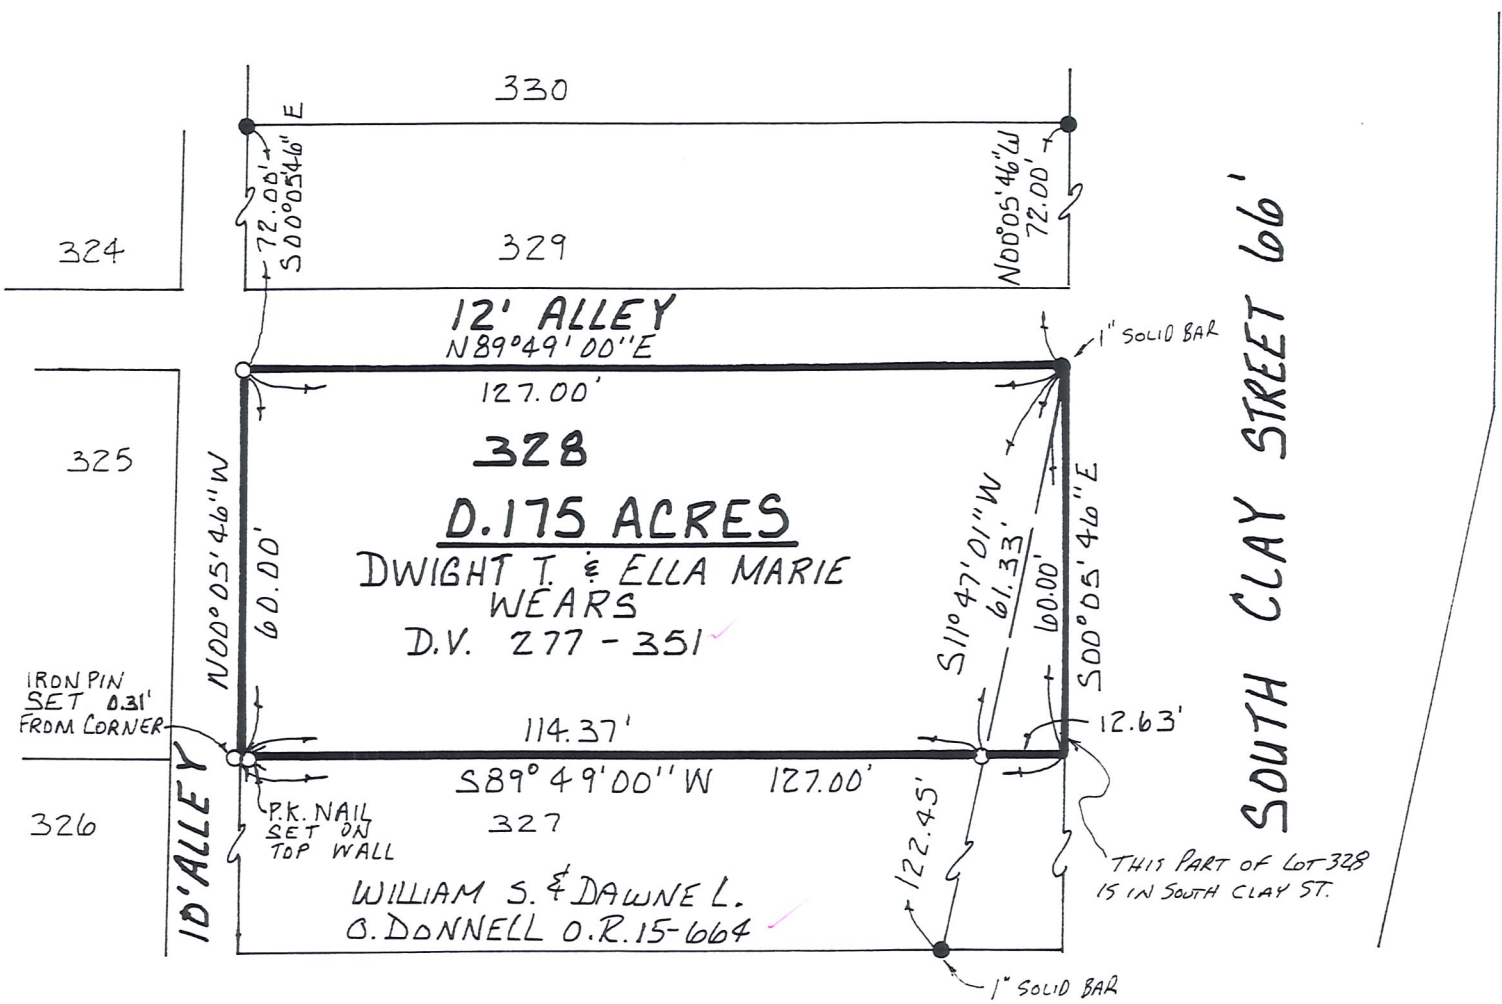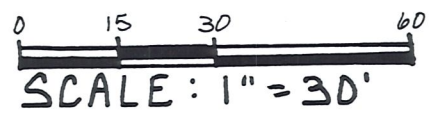

RECEIVED
 APR 26 1999
 Hol. Co. Tax Map Office

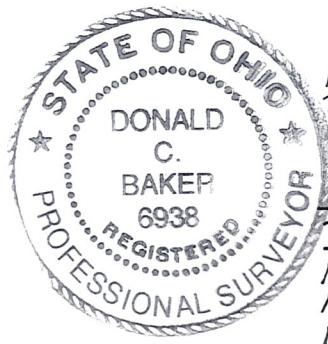

I CERTIFY THIS SURVEY TO BE CORRECT TO THE BEST OF MY KNOWLEDGE.

Donald C. Baker

DONALD C. BAKER P.S. 6938
 138 N. CLAY ST.
 MILLERSBURG, OHIO 44654
 PH: (330) 674-4788

APRIL 21, 1999

71698-FJM
 F.C.C. - J.D. DARR