

BEARINGS ARE TO AN ASSUMED MERIDIAN AND ARE USED TO DENOTE ANGULAR MEAS. ONLY.

OUT LOT 88

S. CLAY ST. 66'

NO NAME ST. 33' REC.*

RICHARD C. BRUNN, TRUSTEE
D.X. 236/89

S. WASHINGTON ST.

IN LOT 556
0.443 ACRE

IN LOT 533

IN LOT 534

IN LOT 555

MARCUS MILLER
O.R. 52/127

IN LOT 554

* NOTE: THE RECORDED WIDTH OF NO NAME ST. AS RECORDED IN PLAT VOL. 1, PAGE 92 IS 33' HOWEVER BUILDING OUT LOT 88 FROM THE NORTH AND IN LOT 556 FROM THE SOUTH LEAVES 43.18' AS THE WIDTH OF NO NAME ST.


REFERENCE DOCUMENTS:

- TAX MAPS
- DEEDS AS SHOWN
- SURVEY PLATS: S.R. 4/206, S.R. 4/208, 3/28, 3/41, 3/54B, 5/155, 8/76, 10/263, 14/17

I CERTIFY THIS PLAT & SURVEY TO BE CORRECT TO THE BEST OF MY KNOWLEDGE:

Jim Shamp
JIM SHAMP, REG. SUR. NO. S-6088

MAY 13, 2002
DATE

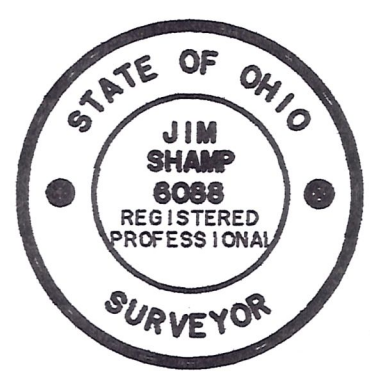

- LEGEND:
- = STONE FD.
 - = 5/8" RE-BAR FD. UNLESS NOTED
 - = POINT-OF-DEPARTURE
 - = 5/8" X 30" RE-BAR W/PLASTIC I.D. CAP SET
 - ⊗ = R/R SPIKE SET
 - △ = R/R SPIKE FD.
 - ⊗ = CROW'S FOOT IN CONC. SIDEWALK

HEARTLAND SURVEYING, INC
Jim Shamp
5210 T.R. 257 MILLERSBURG, OH 44654
PH: 330-674-4698 FAX: 330-674-0897

SURVEY		STATE	
RICHARD C. BRUNN, TRUSTEE		OHIO	
COUNTY	TWP.	RNG.	TWP.
HOLMES	HARDY	7 W	9 N
VILLAGE OF MILLERSBURG IN LOT 556		010328.CRD 020505.PL1	

33' ALLEY

IN LOT-553

3/4" RE-BAR FD.
N 77°48'48"E
8.35' FROM CALC.
PROP. COR.

50'

N 69°13'58"E 166.83' CALC.
174.9' REC.
80.62'

104.47' PRO RATED
102.3' REC.
N 12°16'31"W

84.25' PRO RATED
82.5' REC.

165.00' TOTAL
S 77°48'48"W

82.5'

41.25'

1/2" PIPE USED

N 12°16'31"W
1026.41'

USED

ALLEY
129.36' PRO RATED
118.8' REC.

S 12°16'31"E
84.25' PRO RATED
82.5' REC.

USED

1" BENT PIPE USED

16.43'