


HARDY TOWNSHIP  
 S.W. QTR. SECTION 4  
 T-9N; R-6W  
 HOLMES COUNTY, OHIO

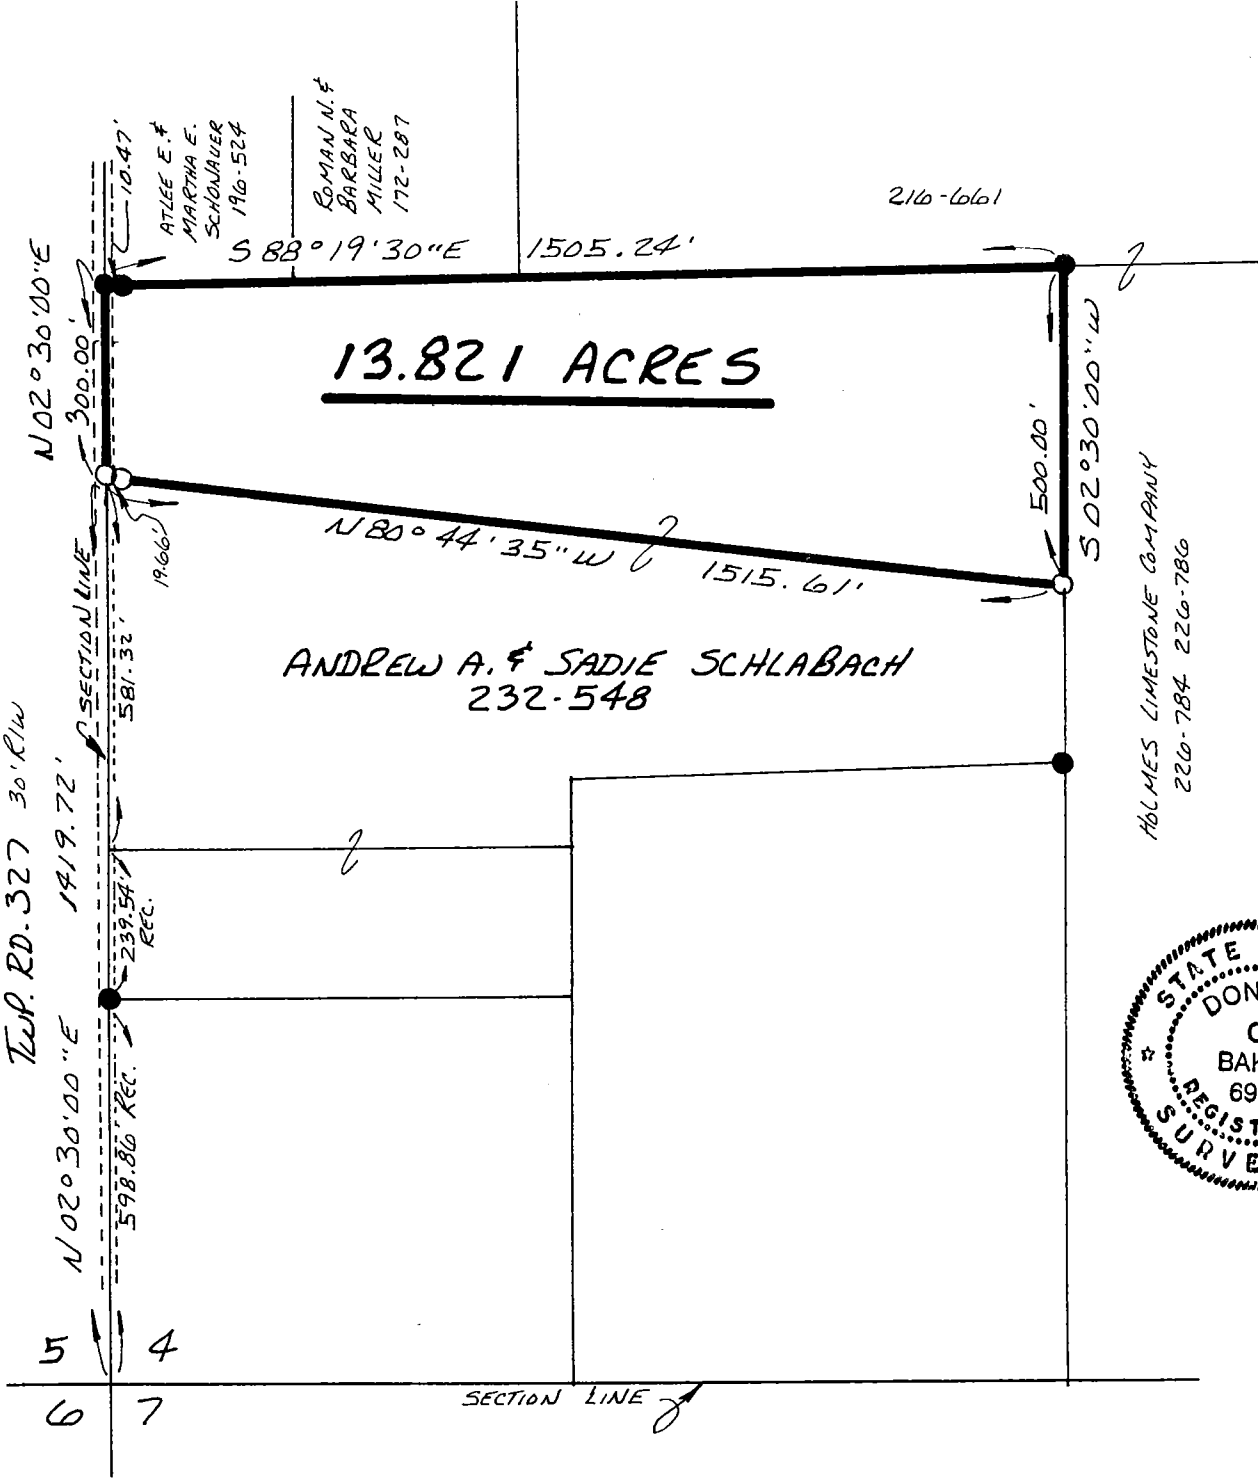

SCALE: 1" = 300'

- IRON PIN FOUND
- 5/8" RE BAR WITH WD. CAP SET  
I.D. CAP MARKED "BAKER 6938"

REFERENCES:

- PLAT VOL. 10 PAGE 618
- PLAT VOL. 10 PAGE 446
- PLAT VOL. 8 PAGE 873
- PLAT VOL. 7 PAGE 736
- DEED VOL. 232 PAGE 548
- DEED VOL. 226 PAGE 786

BEARINGS FROM PLAT VOL. 10 PAGE 617



I CERTIFY THIS SURVEY TO BE CORRECT TO THE BEST OF MY KNOWLEDGE.

Donald C. Baker  
 DONALD C. BAKER P.S. 6938  
 5958 T.R. 322  
 MILLERSBURG, OHIO 44654  
 PH. (216) 674-4788  
 NOVEMBER 13, 1992