



- IRON PIN FOUND
- ▲ R.R. SPIKE FOUND
- P.K. NAIL SET
- 5/8" R₆ BAR WITH I.D. CAP SET
- I.D. CAP MARKED "BAKER 6938"

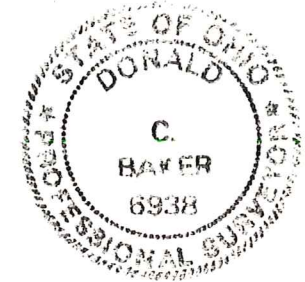

HARDY TOWNSHIP
 1ST. QTR. LOT 3
 T- 9N; R- 7W
 HOLMES COUNTY, OHIO

REFERENCES:
 DEED VOL. 209 PAGE 536
 DEED VOL. 235 PAGE 116
 DEED VOL. 165 PAGE 561
 SURVEY RECORD 5 PAGE 182
 PLAT VOL. 10 PAGE 262
 BEARINGS FROM PLAT VOL. 13 PAGE 170

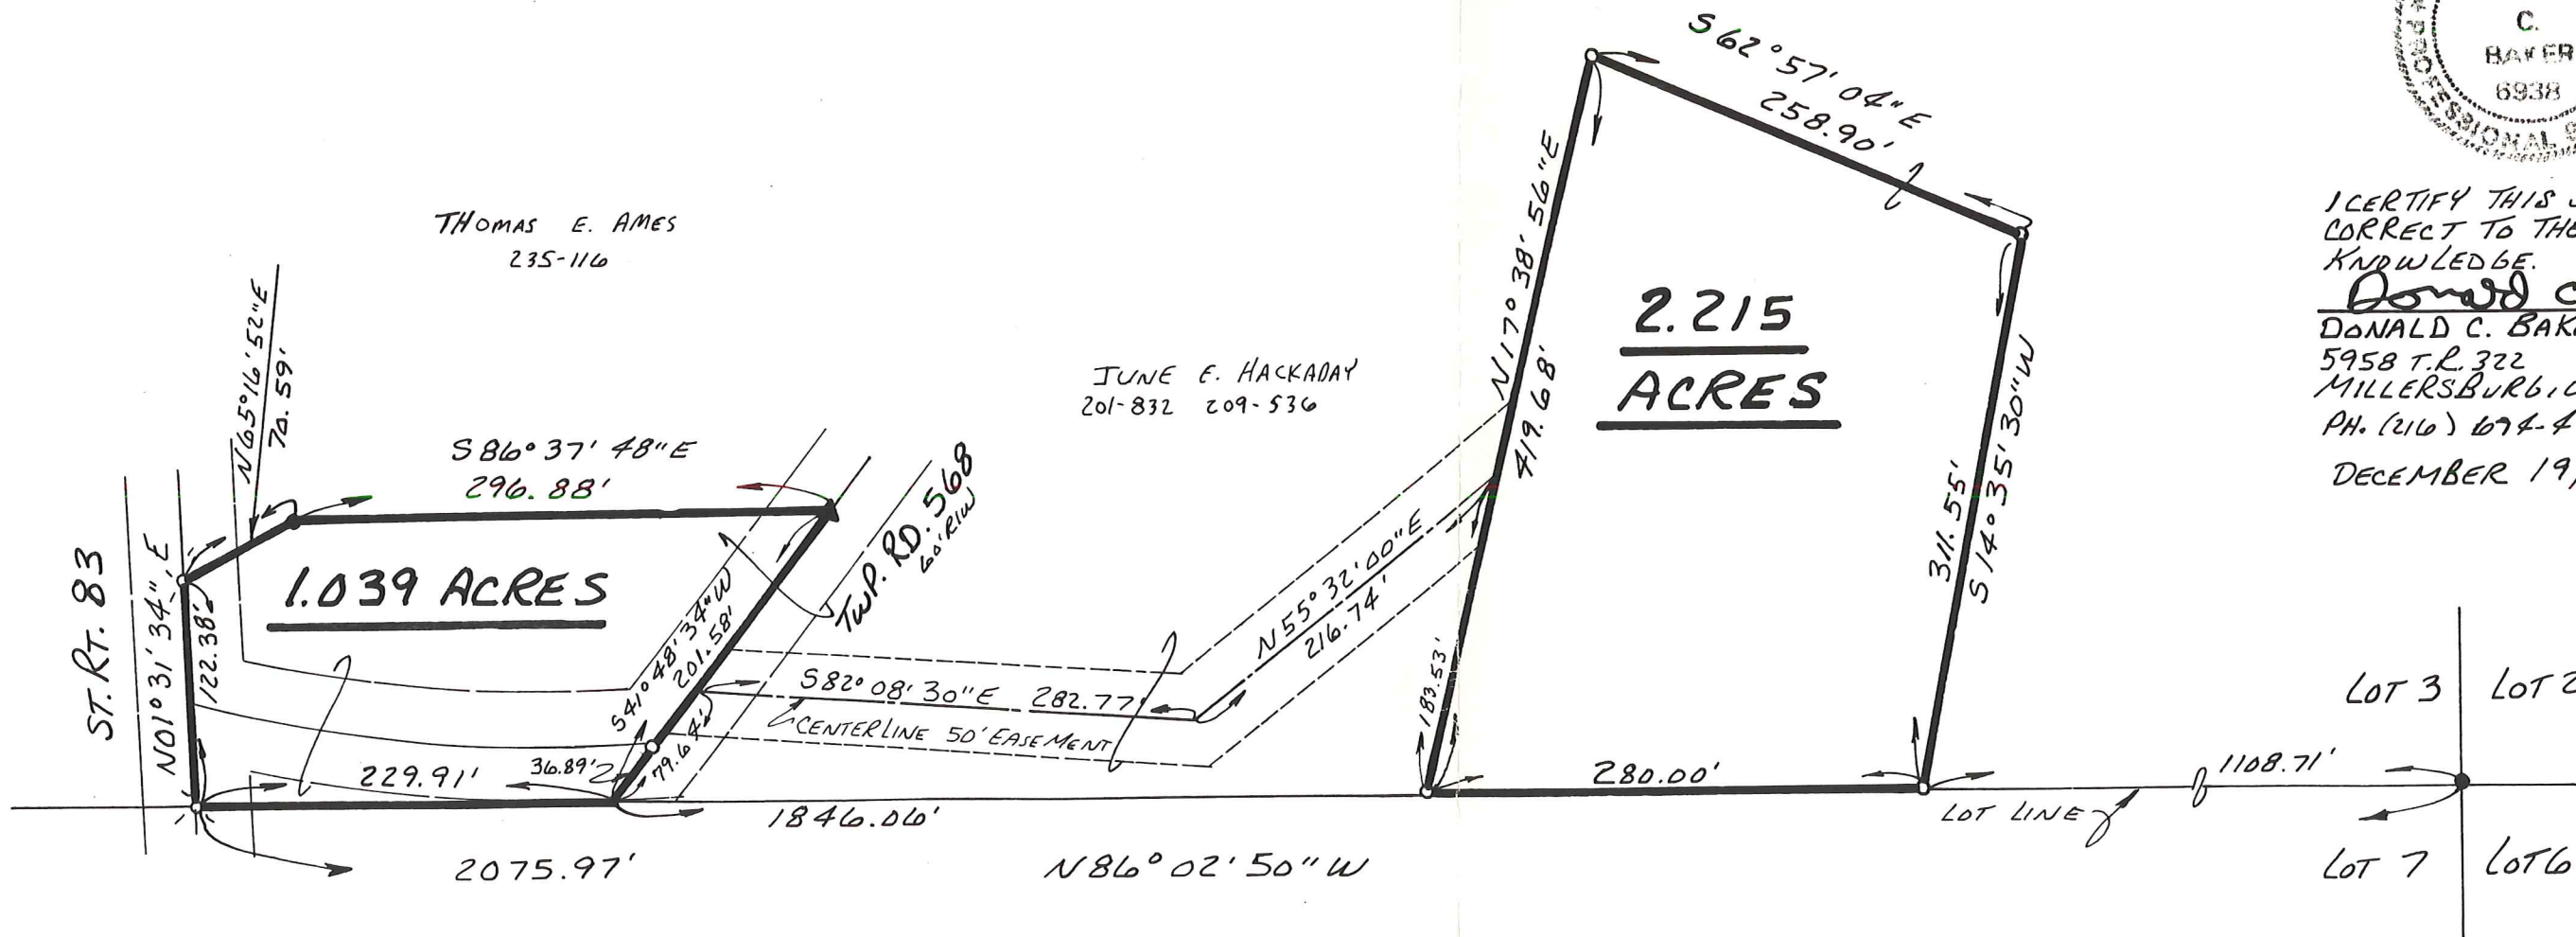

I CERTIFY THIS SURVEY TO BE
 CORRECT TO THE BEST OF MY
 KNOWLEDGE.
Donald C. Baker
 DONALD C. BAKER P.S. 6938
 5958 T.R. 322
 MILLERSBURG, OHIO 44654
 PH. (216) 674-4788
 DECEMBER 19, 1994