


HARDY TOWNSHIP  
1ST. QTR., LOT 7  
T-9 N; R-7 W  
HOLMES COUNTY OHIO

SURVEYED FOR: LONNIE CUTLIP

REFERENCES


- DEED VOL. 205 PAGE 819
- DEED VOL. 223 PAGE 918
- DEED VOL. 243 PAGE 268
- O.R. VOL. 163 PAGE 248
- PLAT VOL. 10 PAGE 262
- PLAT VOL. 18 PAGE 627

BEARINGS FROM PLAT VOL. 18 PAGE 627

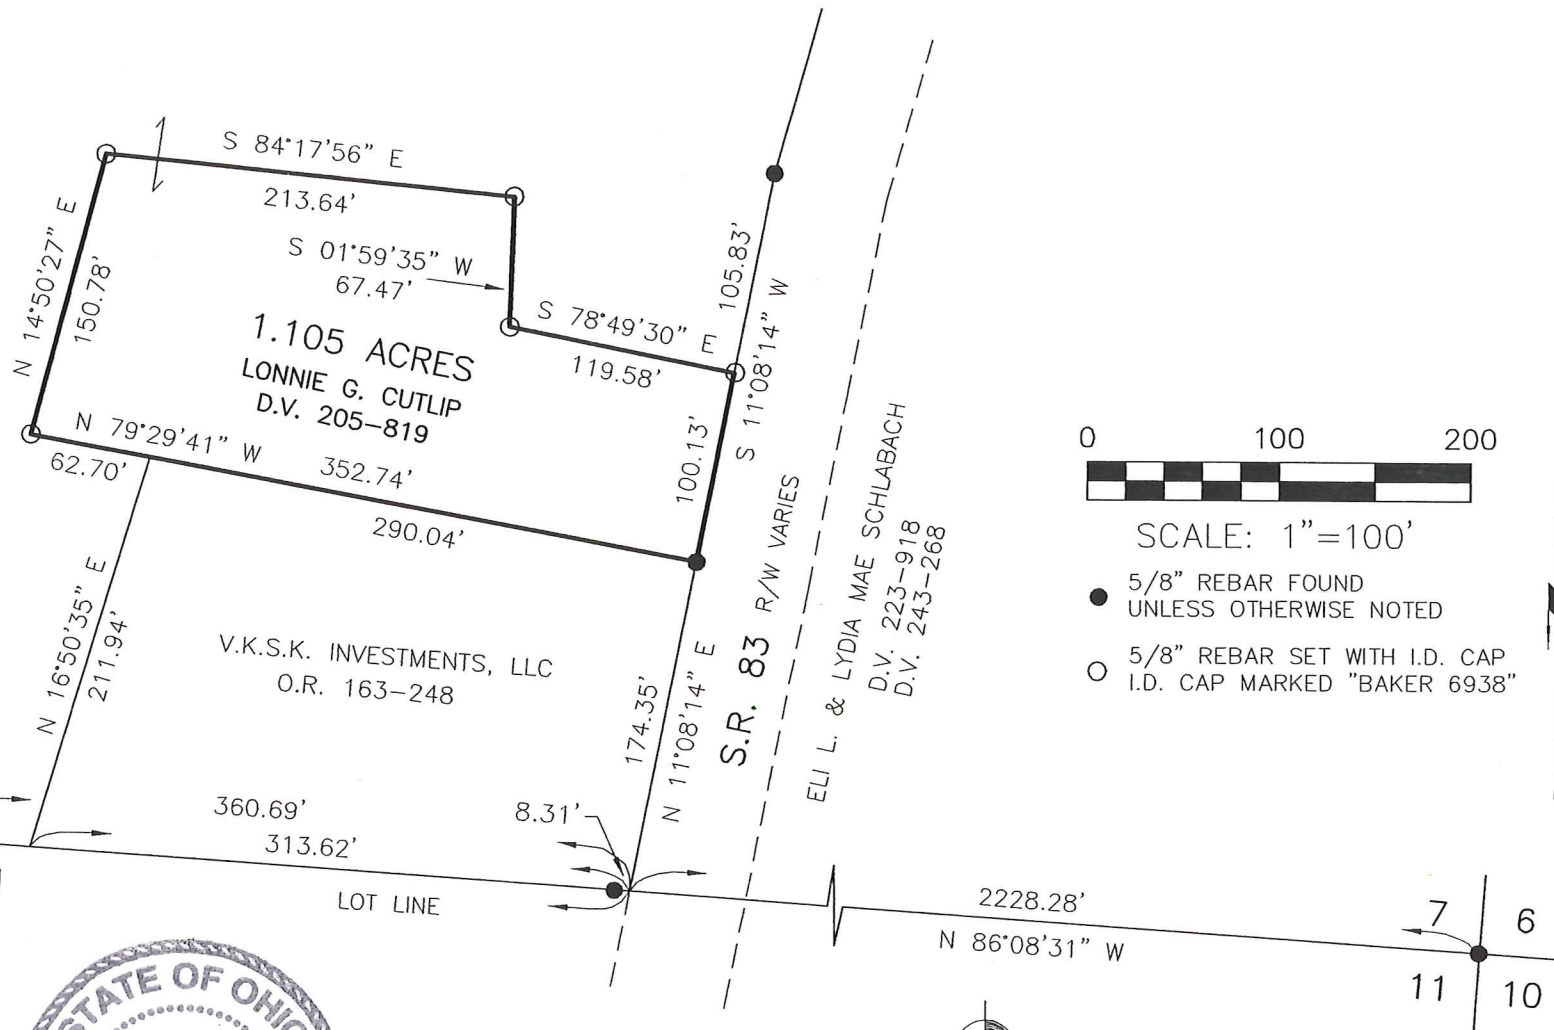

SCALE: 1"=100'

- 5/8" REBAR FOUND UNLESS OTHERWISE NOTED
- 5/8" REBAR SET WITH I.D. CAP I.D. CAP MARKED "BAKER 6938"

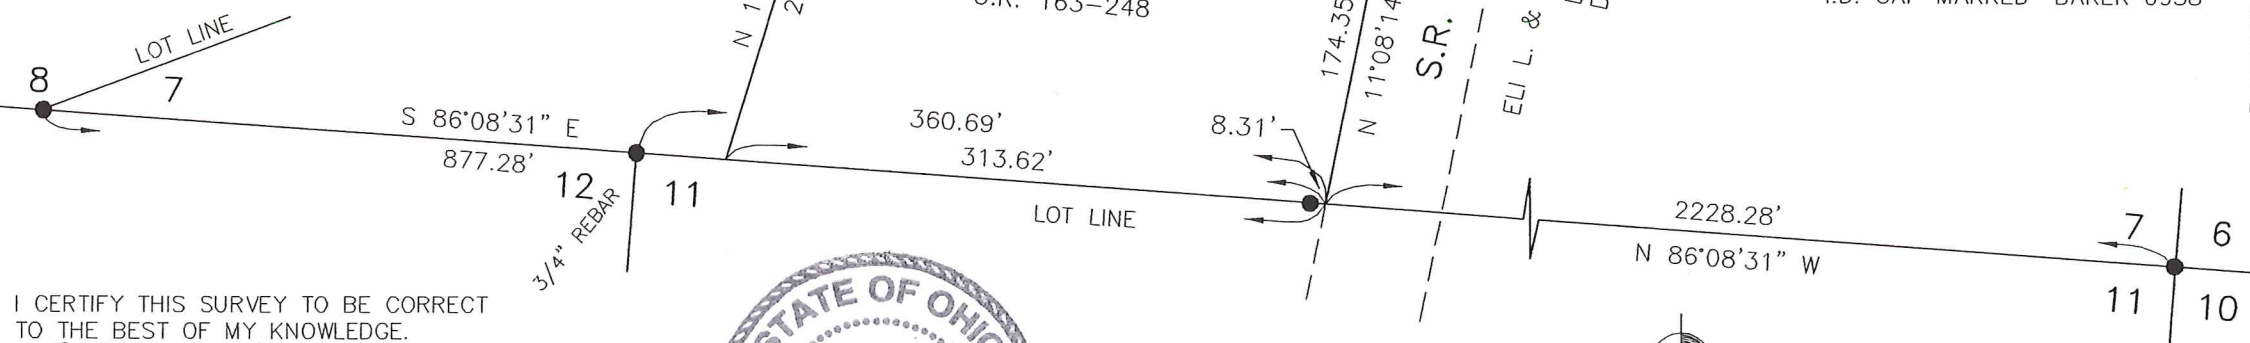

I CERTIFY THIS SURVEY TO BE CORRECT TO THE BEST OF MY KNOWLEDGE.


*Donald C. Baker*  
DONALD C. BAKER

P.S. 6938

DATE: MARCH 16, 2006

KES\AEG

FILE NAME: WORK3\S-169-06\ERZ

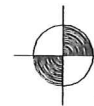

DONALD C. BAKER SURVEYING  
138 N. CLAY STREET  
MILLERSBURG, OHIO 44654  
PH. 330-674-4788  
FAX 330-674-6027