


NOTE: RECORD DISTANCE FROM POINT A TO POINT B = 1062.67'
 MEASURED DISTANCE = 1059.54'
 RECORD DISTANCE FROM POINT B TO POINT C = 247.86'
 MEASURED DISTANCE = 149.62'



LEGEND:
 ○ = I.P. FD.
 □ = RAILROAD SPIKE FD.
 ○ = I.P. SET (5/8" X 30" REBAR W/PLASTIC CAP MARKED "JIM SHAMP 6088")

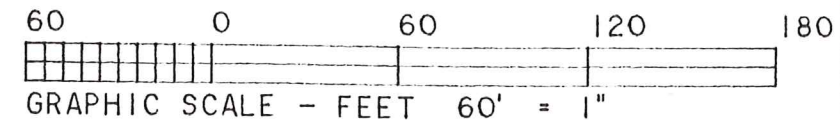

* BEARINGS ESTABLISHED FROM PLAT VOL. 10, PG. 896


ADEN H. YODER
 V.246, P.386

MONROE M. & PHYLLIS WEAVER
 V.245, P.655

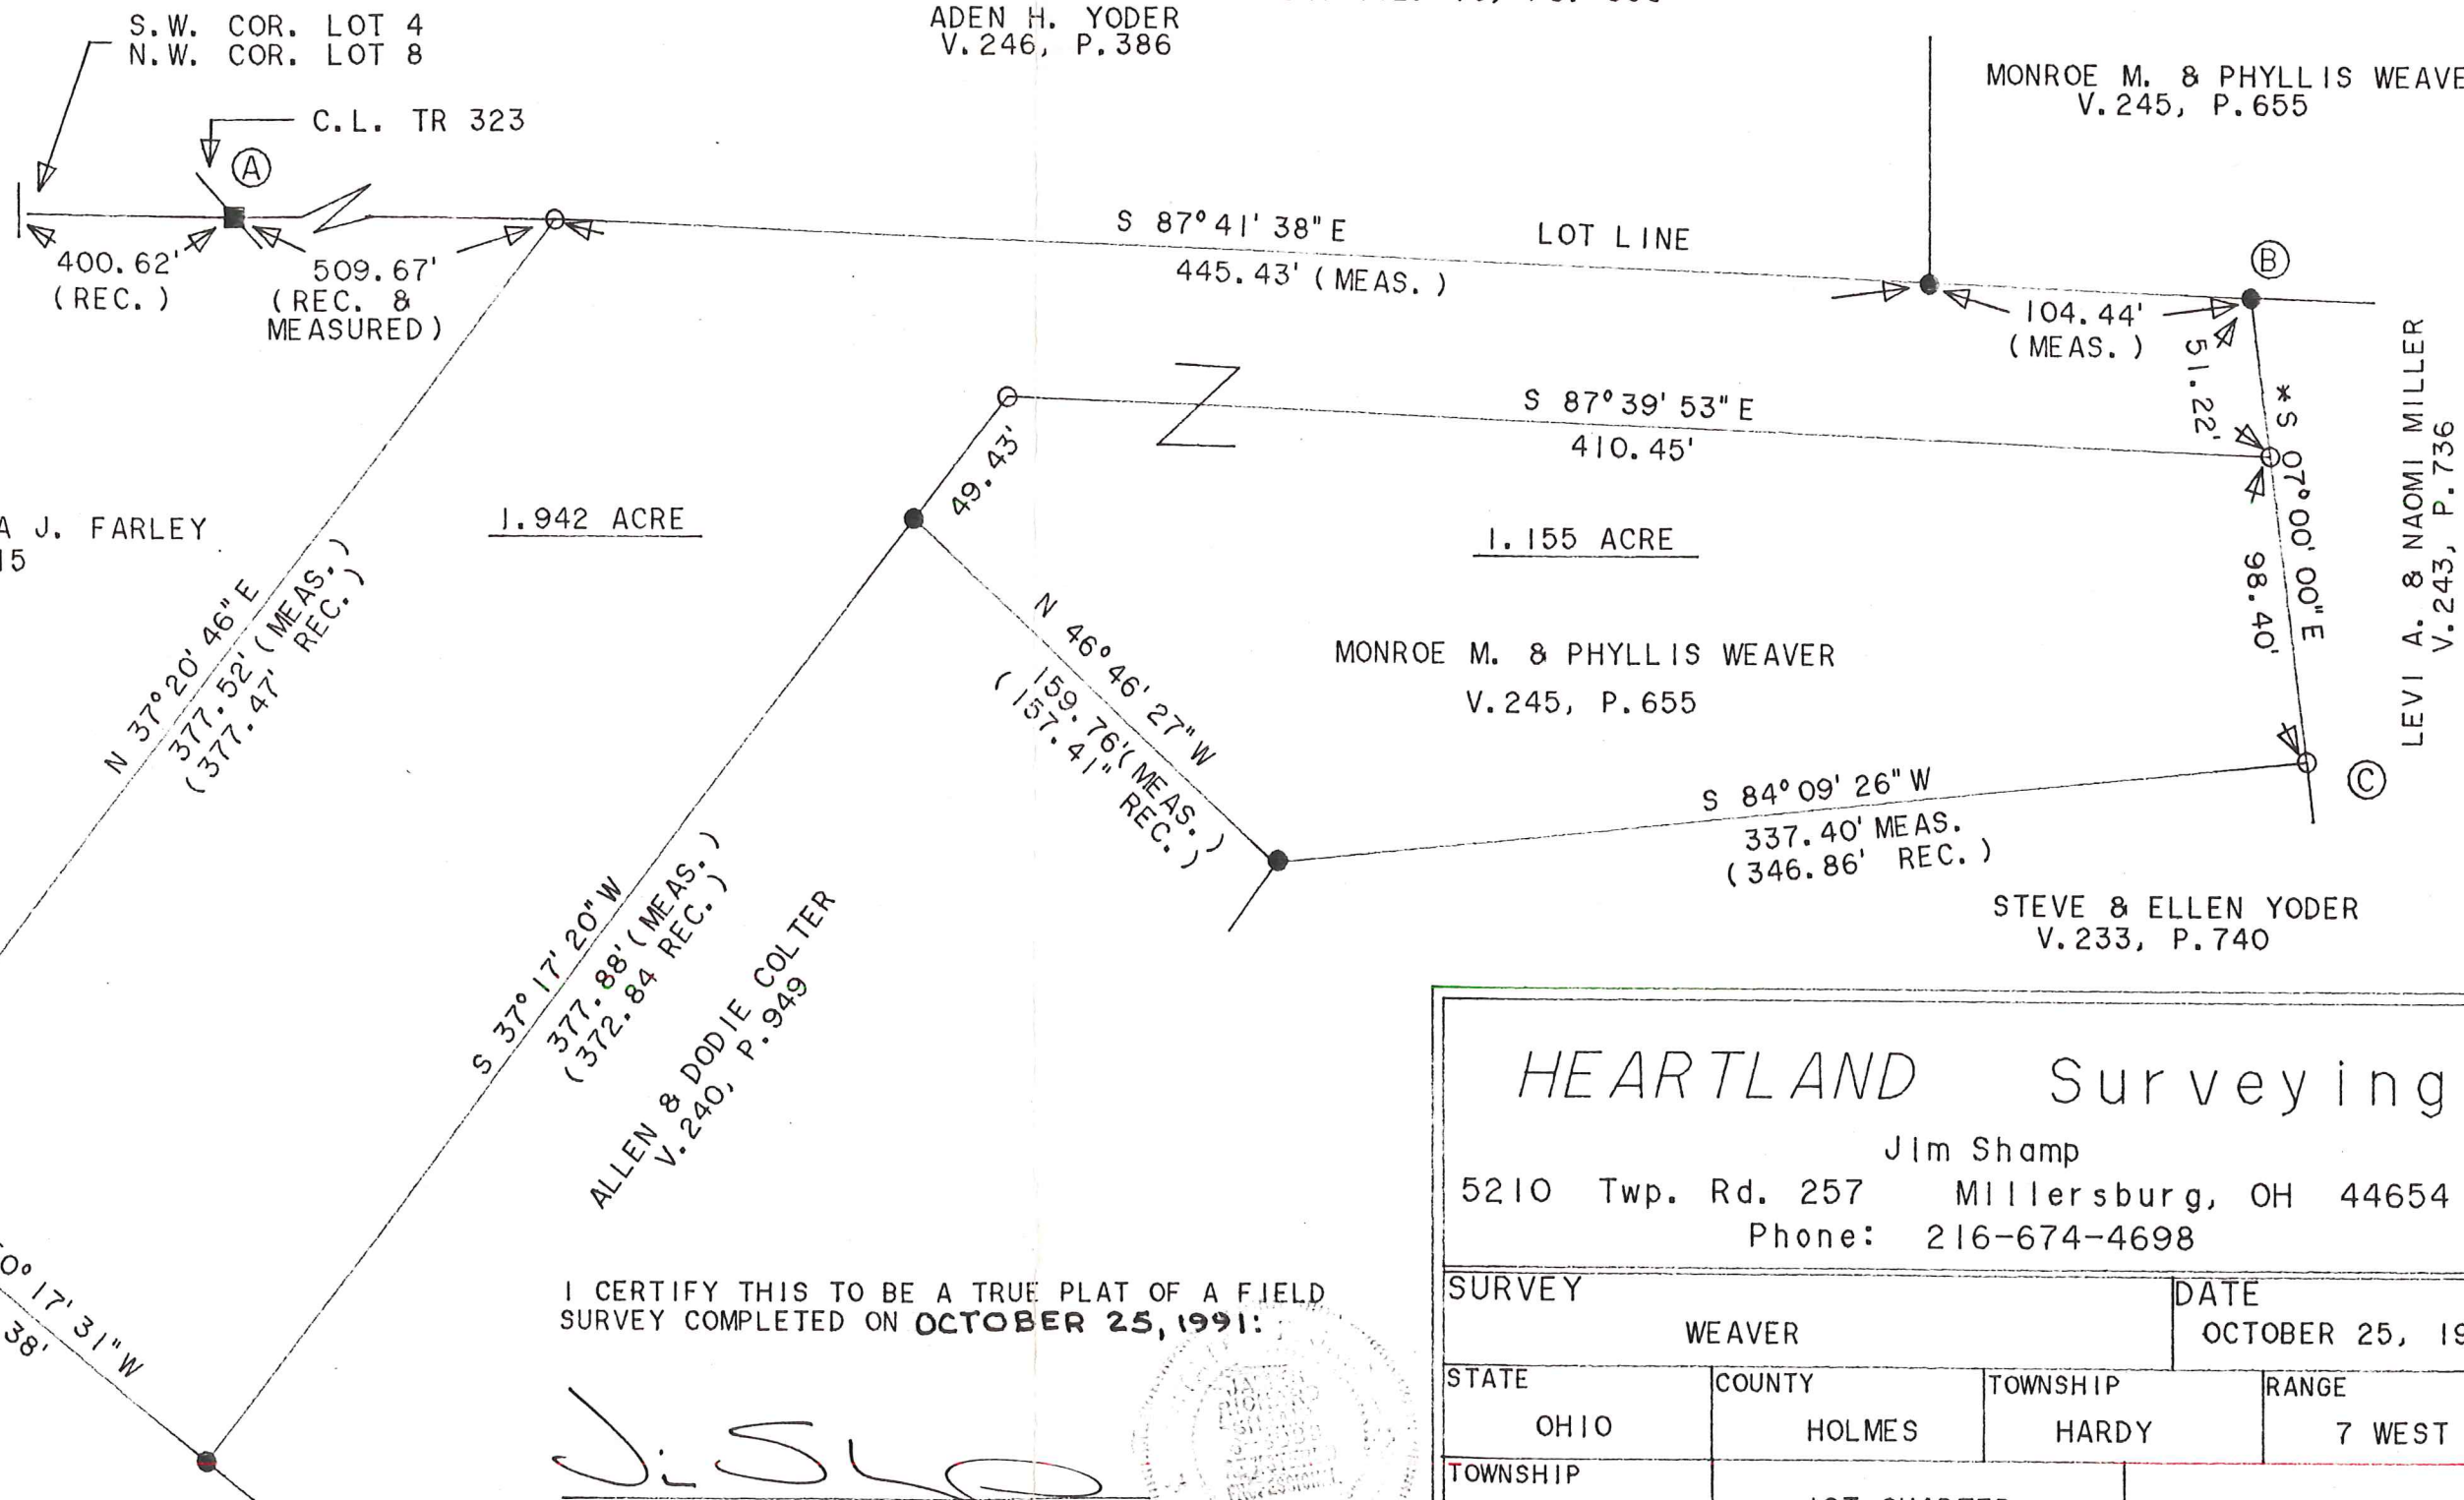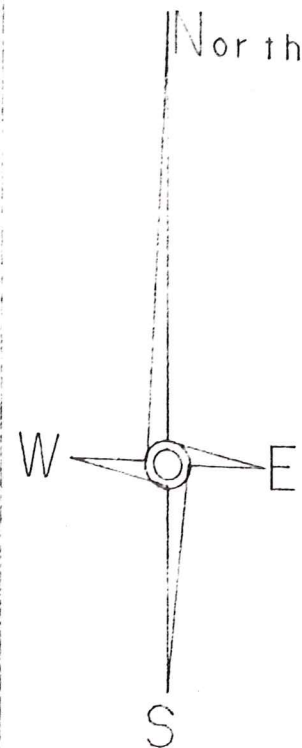

I CERTIFY THIS TO BE A TRUE PLAT OF A FIELD SURVEY COMPLETED ON **OCTOBER 25, 1991:**

J. Shamp
 JIM SHAMP, REG. SUR. NO. S-6088

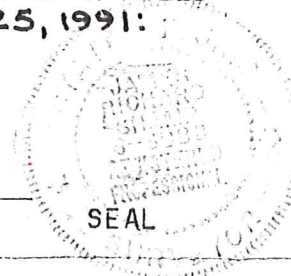

HEARTLAND Surveying

Jim Shamp
 5210 Twp. Rd. 257 Millersburg, OH 44654
 Phone: 216-674-4698

SURVEY		DATE	
WEAVER		OCTOBER 25, 1991	
STATE	COUNTY	TOWNSHIP	RANGE
OHIO	HOLMES	HARDY	7 WEST
TOWNSHIP			
9 NORTH	1ST QUARTER	LOT 8	