


0 150 300 600

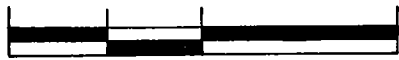

SCALE: 1" = 300'


- ▲ R.R. SPIKE FOUND
- IRON PIN FOUND
- 5/8" REBAR WITH I.D. CAPSET  
I.D. CAP MARKED "BAKER 6938"
- STONE FOUND

REFERENCES:

DEED VOL. 230 PAGE 365  
 " " 235 " 166  
 " " 213 " 390

PLAT VOL. 7 PAGE 778  
 " " 10 " 378  
 " " 10 " 441  
 " " 5 " 44  
 " " 7 " 779

BEARINGS FROM S.R. 5 PAGE 183

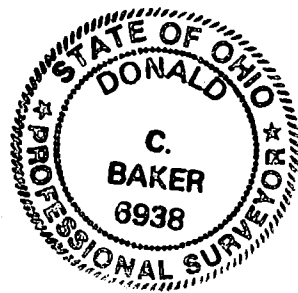

I CERTIFY THIS SURVEY TO BE CORRECT TO THE BEST OF MY KNOWLEDGE.

*Donald C. Baker*  
 DONALD C. BAKER P.S. 6938  
 5958 T.R. 322  
 MILLERSBURG, OHIO 44654  
 PH. (216) 674-4788

20295.MLS  
FSM

HARDY TOWNSHIP  
 1ST. QTR. LOT 19  
 T-9N / R-7W  
 HOLMES COUNTY, OHIO

PROPERTY LINE SURVEY

