



N
 HARDY TOWNSHIP
 1ST. QTR. LOT 41
 T-9N R-7W
 HOLMES COUNTY, OHIO

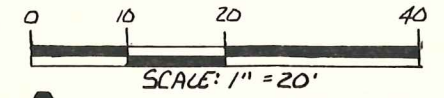

- CONCRETE MONUMENT FOUND
- IRON PIN FOUND
- 5/8" REBAR WITH I.D. CAP SET I.D. CAP MARKED "BAKER 6938"

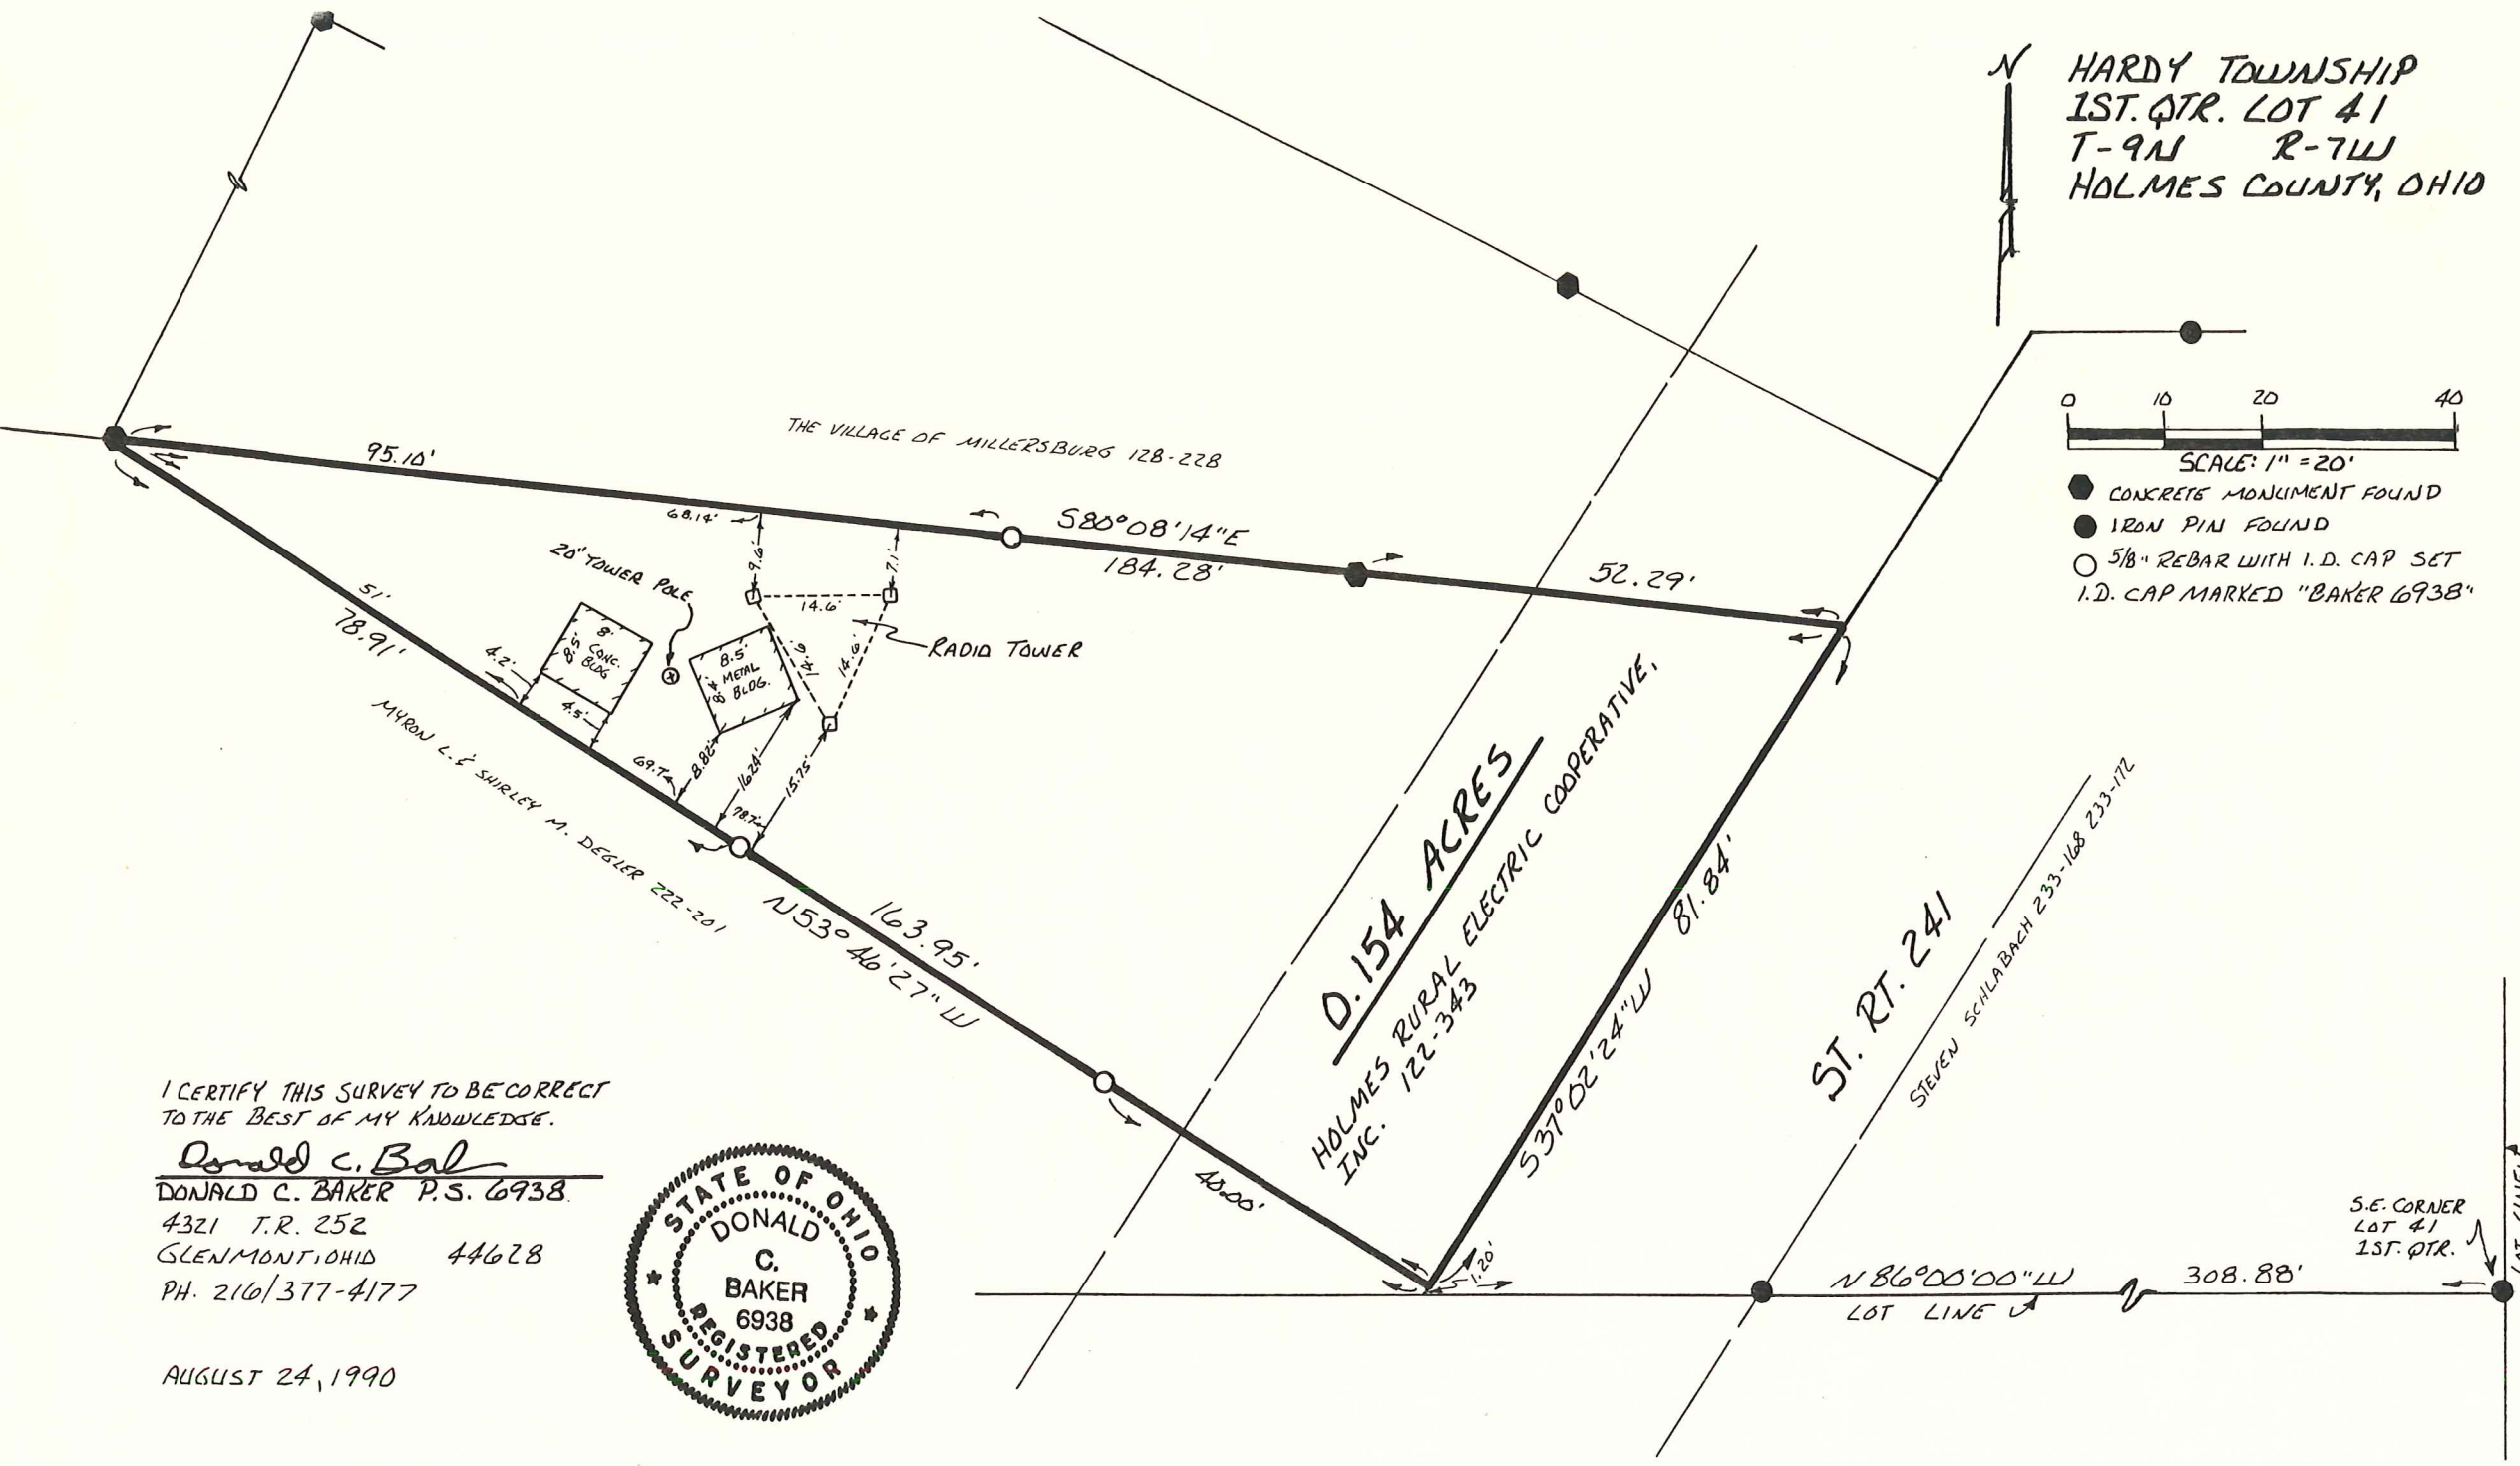

I CERTIFY THIS SURVEY TO BE CORRECT TO THE BEST OF MY KNOWLEDGE.

Donald C. Baker
 DONALD C. BAKER P.S. 6938
 4321 T.R. 252
 GLENMONT, OHIO 44628
 PH. 216/377-4177



AUGUST 24, 1990

S.E. CORNER
 LOT 41
 1ST. QTR.

LOT LINE