


REFERENCES:
 DEED VOL. 267 PAGE 460
 " " 247 " 418
 " " 219 " 277
 " " 166 " 45
 " " 262 " 22
 (A) VIRGIL E. & RUTH SHREINER 145-347

BEARINGS FROM STATE HIGHWAY PLANS

HARDY TOWNSHIP
 3RD. QTR. LOT 1
 T-9N; R-7W
 HOLMES COUNTY, OHIO

SURVEYED FOR JAYNE LE

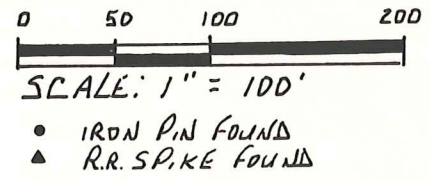

RESURVEY OF DEED VOL. 267 PAGE 460



I CERTIFY THIS SURVEY TO BE CORRECT TO THE BEST OF MY KNOWLEDGE.

Donald C. Baker
 DONALD C. BAKER P.S. 6938
 138 N. CLAY ST.
 MILLERSBURG, OHIO 44654
 PH. (330) 674-4788
 AUGUST 29, 1997
 4997-SRU
 F.C.C. - J. D. DARR