

HARDY TOWNSHIP
 3RD QTR., LOT 5
 T-9 N; R-7 W
 HOLMES COUNTY, OHIO

SURVEYED FOR: WOLF MIGGIANI

0 200 400



SCALE: 1"=200'

- ▲ R.R. SPIKE FOUND
- 5/8" REBAR FOUND
UNLESS OTHERWISE NOTED
- 5/8" REBAR SET WITH I.D. CAP
- I.D. CAP MARKED "BAKER SURVEYING LLC"




I CERTIFY THIS SURVEY TO BE CORRECT
 TO THE BEST OF MY KNOWLEDGE.

AARON L. GERBER P.S. 8379

DATE: JULY 11, 2024

ALG\GRB

FILE NAME: WORK5\S-268-24\CNK

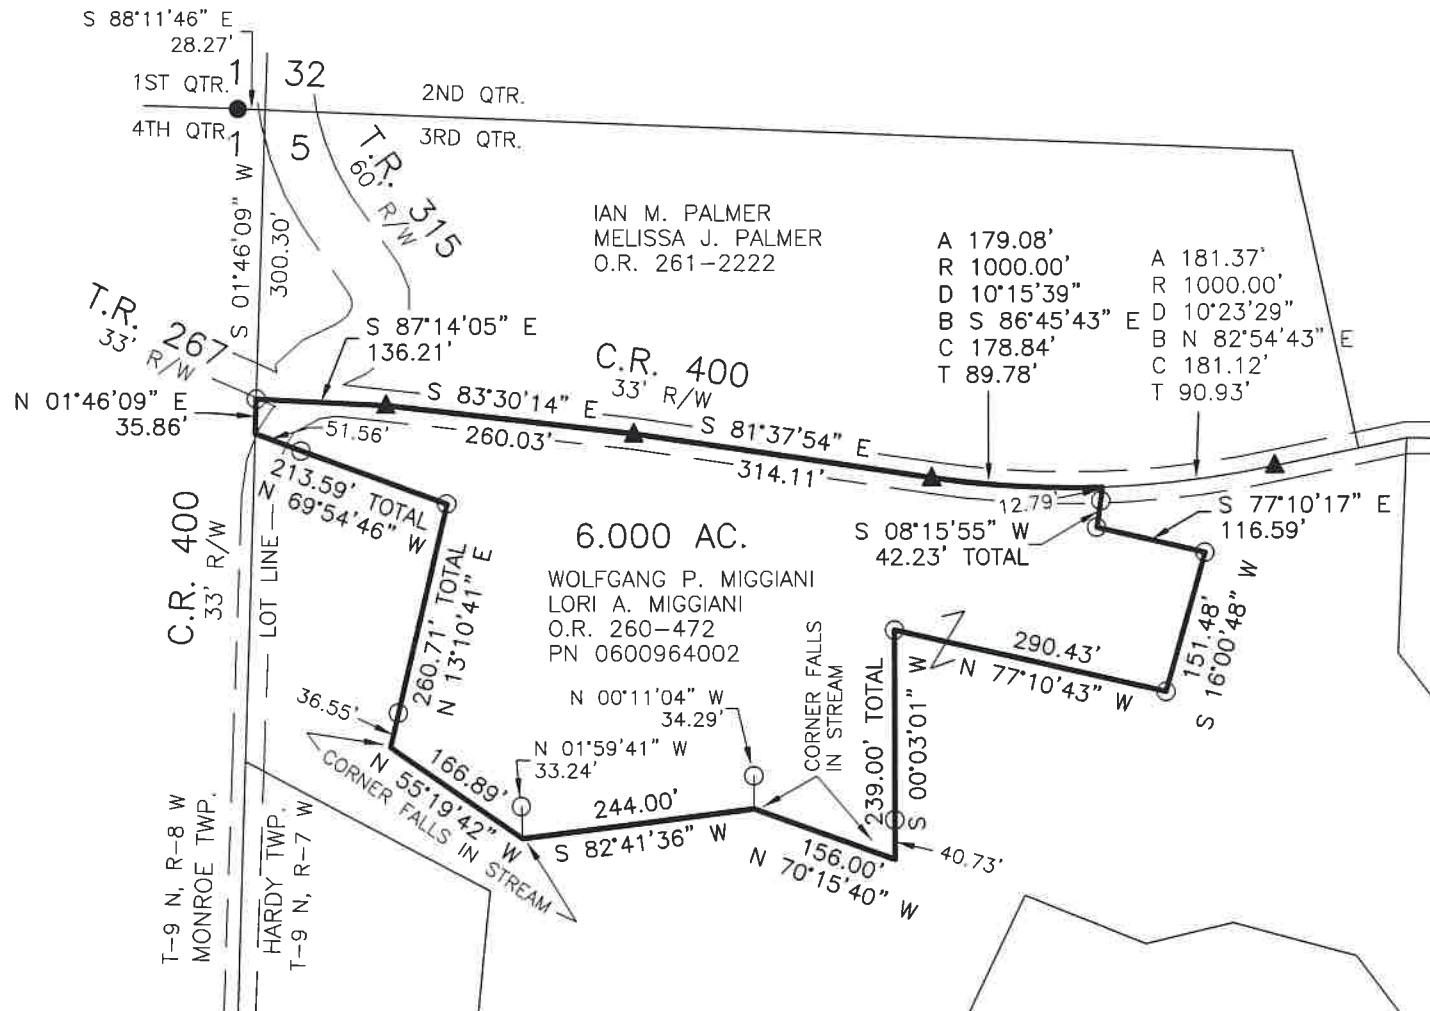

REFERENCES

- O.R. VOL. 260 PAGE 472
- PLAT VOL. 17 PAGE 166
- PLAT VOL. 19 PAGE 3202
- PLAT VOL. 19 PAGE 4287

BASIS OF BEARINGS FROM OHIO STATE PLANE
 COORDINATE SYSTEM, NORTH ZONE,
 N.A.D. 83, 2011 ADJUSTMENT



BAKER SURVEYING, LLC
 138 N. CLAY STREET
 MILLERSBURG, OHIO 44654
 PH. 330-674-4788

EMAIL: bakersurveying@gmail.com