



HARDY TOWNSHIP  
 3RD. QTR., LOT 6  
 T-9 N R-7 W  
 HOLMES COUNTY, OHIO

SURVEYED FOR SARAH PROPER

REFERENCES:

- DEED VOL. 209 PAGE 739
- DEED VOL. 248 PAGES 390 & 394
- DEED VOL. 266 PAGE 296
- DEED VOL. 275 PAGE 254
- O.R. VOL. 9 PAGE 508
- O.R. VOL. 94 PAGE 756
- PLAT VOL. 7 PAGE 631
- PLAT VOL. 11 PAGE 108
- PLAT VOL. 12 PAGE 504
- PLAT VOL. 14 PAGE 24


BEARINGS FROM PLAT VOL. 12 PAGE 504

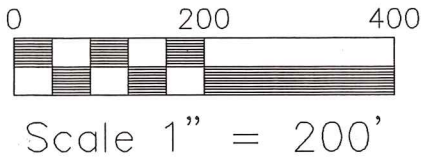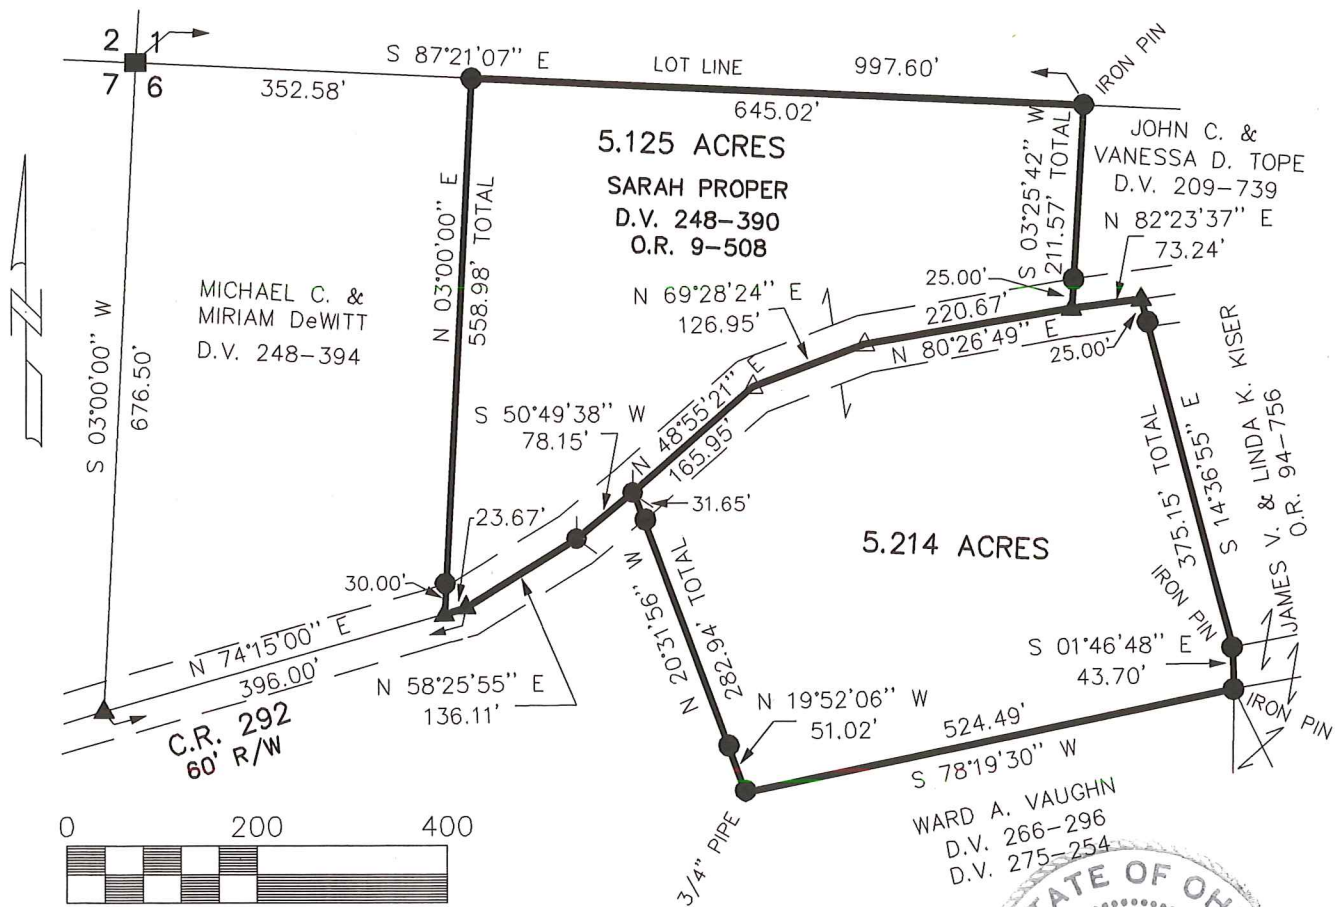

- STONE FOUND
- 5/8" REBAR FOUND  
UNLESS OTHERWISE NOTED
- P.K. NAIL FOUND
- ▲ R.R. SPIKE FOUND
- △ R.R. SPIKE SET



DONALD C. BAKER SURVEYING  
 138 N. CLAY ST.  
 MILLERSBURG, OHIO 44654  
 PH. 330-674-4788  
 FAX 330-674-6027

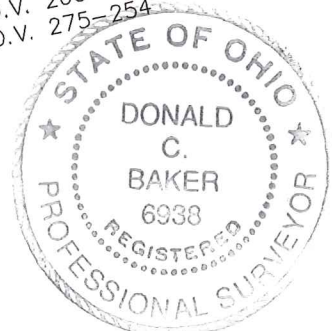

I CERTIFY THIS SURVEY TO BE CORRECT  
 TO THE BEST OF MY KNOWLEDGE.

*Donald C. Baker*  
 DONALD C. BAKER P.S. 6938

KES/ FCC DATE: APRIL 30, 2002  
 File name: C:\JOBS1\S-309-02\ERZ