


From Vol. 175, Stone at N.W. corner  
Pg. 359 5 Lot 6, 3rd 1/4 T9N R7W



Resurvey of Vol. 175  
Pg. 359, all 3 tracts  
3.322 Ac.

Resurvey of tract deeded by  
Robert & Nellie Horner to  
Roger McDowell.

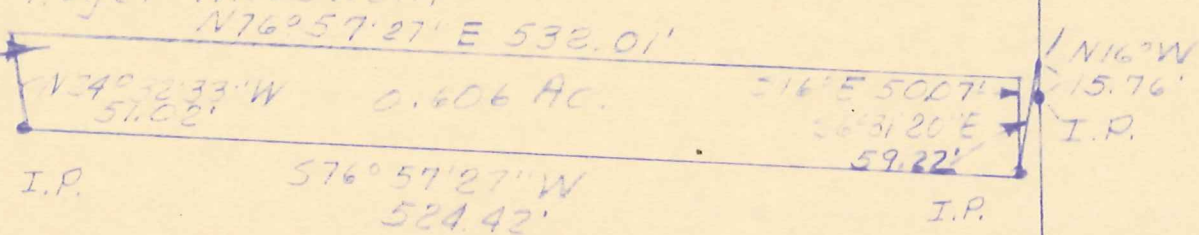


Scale: 1" = 100'

Lot 6, 3rd 1/4, T9N, R7W

Haray Twp., Ho. Co., Ohio

Robert L. Kasner, PS 5193, PE 28820

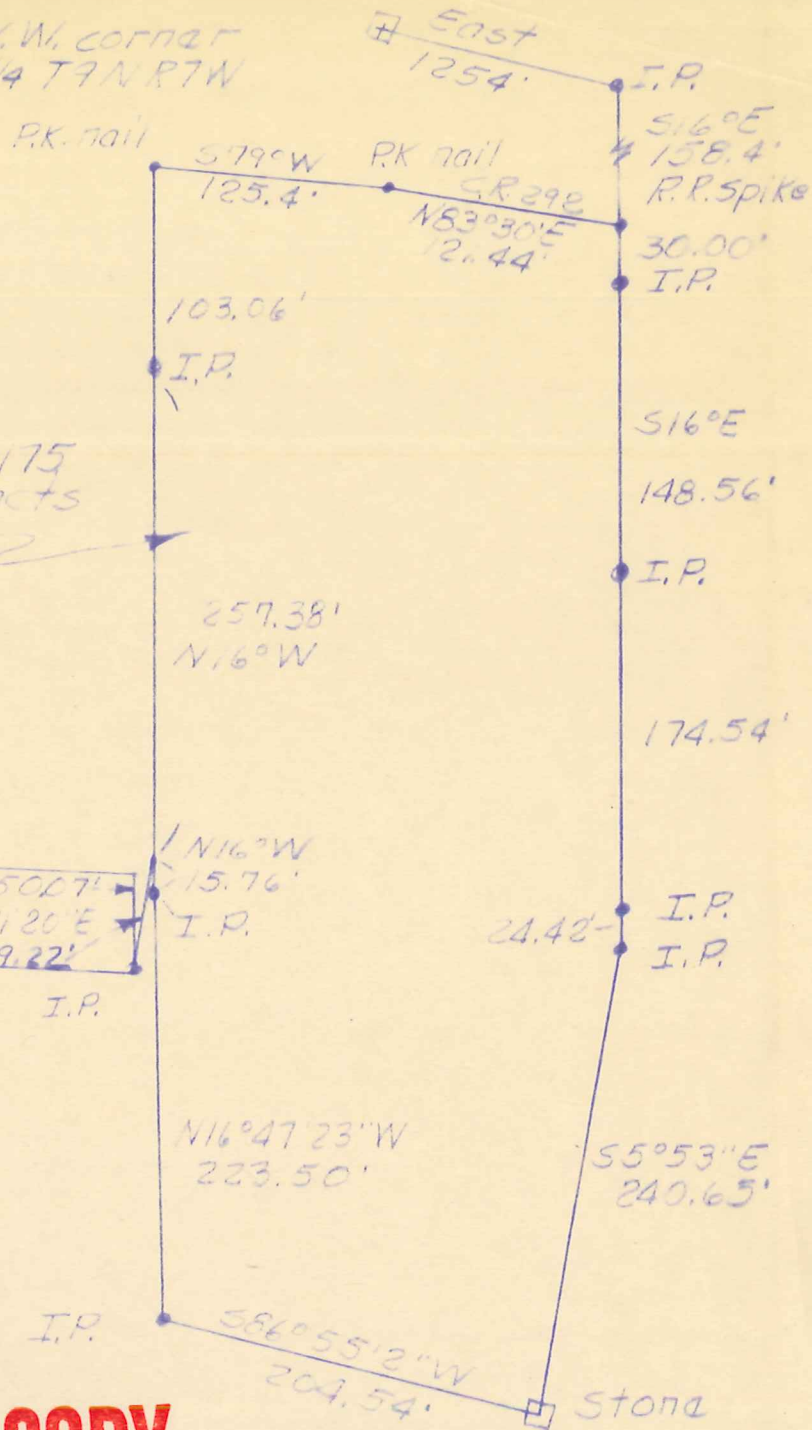

**MAP OFFICE COPY**