
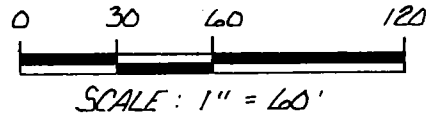



HARDY TOWNSHIP
 3RD. QTR. LOT 12
 TWP-9N RANGE-7W
 HOLMES COUNTY, OHIO

RESURVEY OF 1 ACRE PARCEL
 AS DESCRIBED BY DEED
 VOL. 238 PAGE 531.

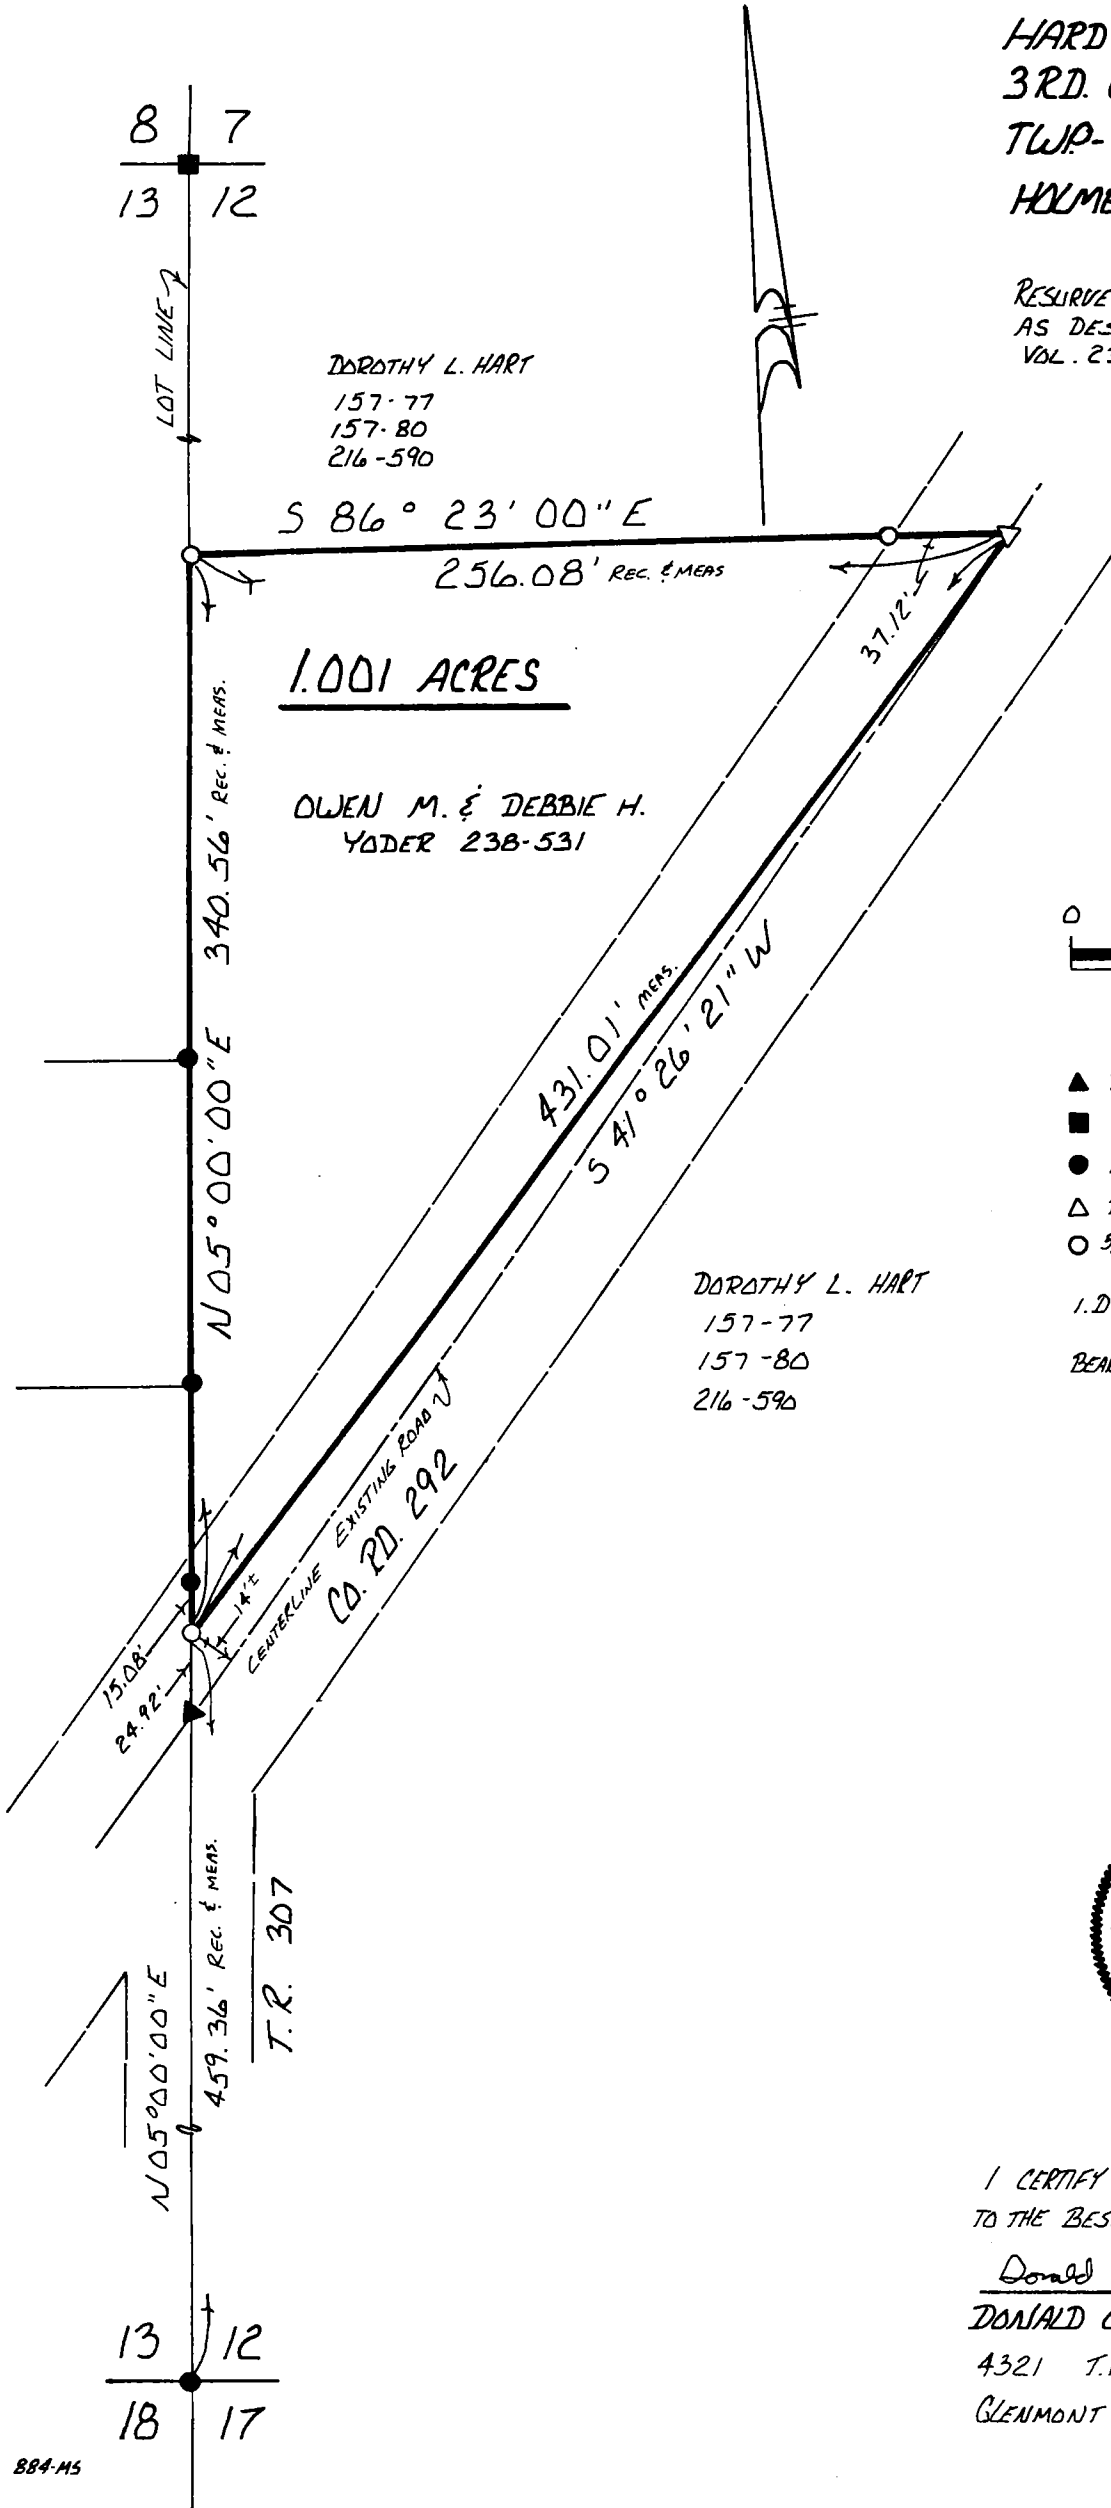

- ▲ R.R. SPIKE FOUND
 - STONE FOUND
 - IRON PIN FOUND
 - △ R.R. SPIKE SET
 - 5/8" REBAR WITH I.D. CAP SET
- I.D. CAP MARKED "BAKER 6938"
- BEARINGS ASSUMED

REFERENCES:
 PLAT VOL. 7 PAGE 545
 DEED VOL. 238 PAGE 531

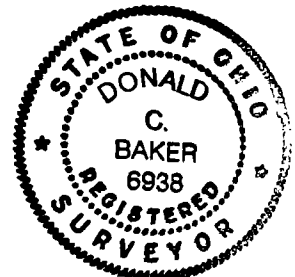

I CERTIFY THIS SURVEY TO BE CORRECT
 TO THE BEST OF MY KNOWLEDGE.

Donald C. Baker
 DONALD C. BAKER P.S. 6938
 4321 T.R. 252
 GLENMONT, OHIO