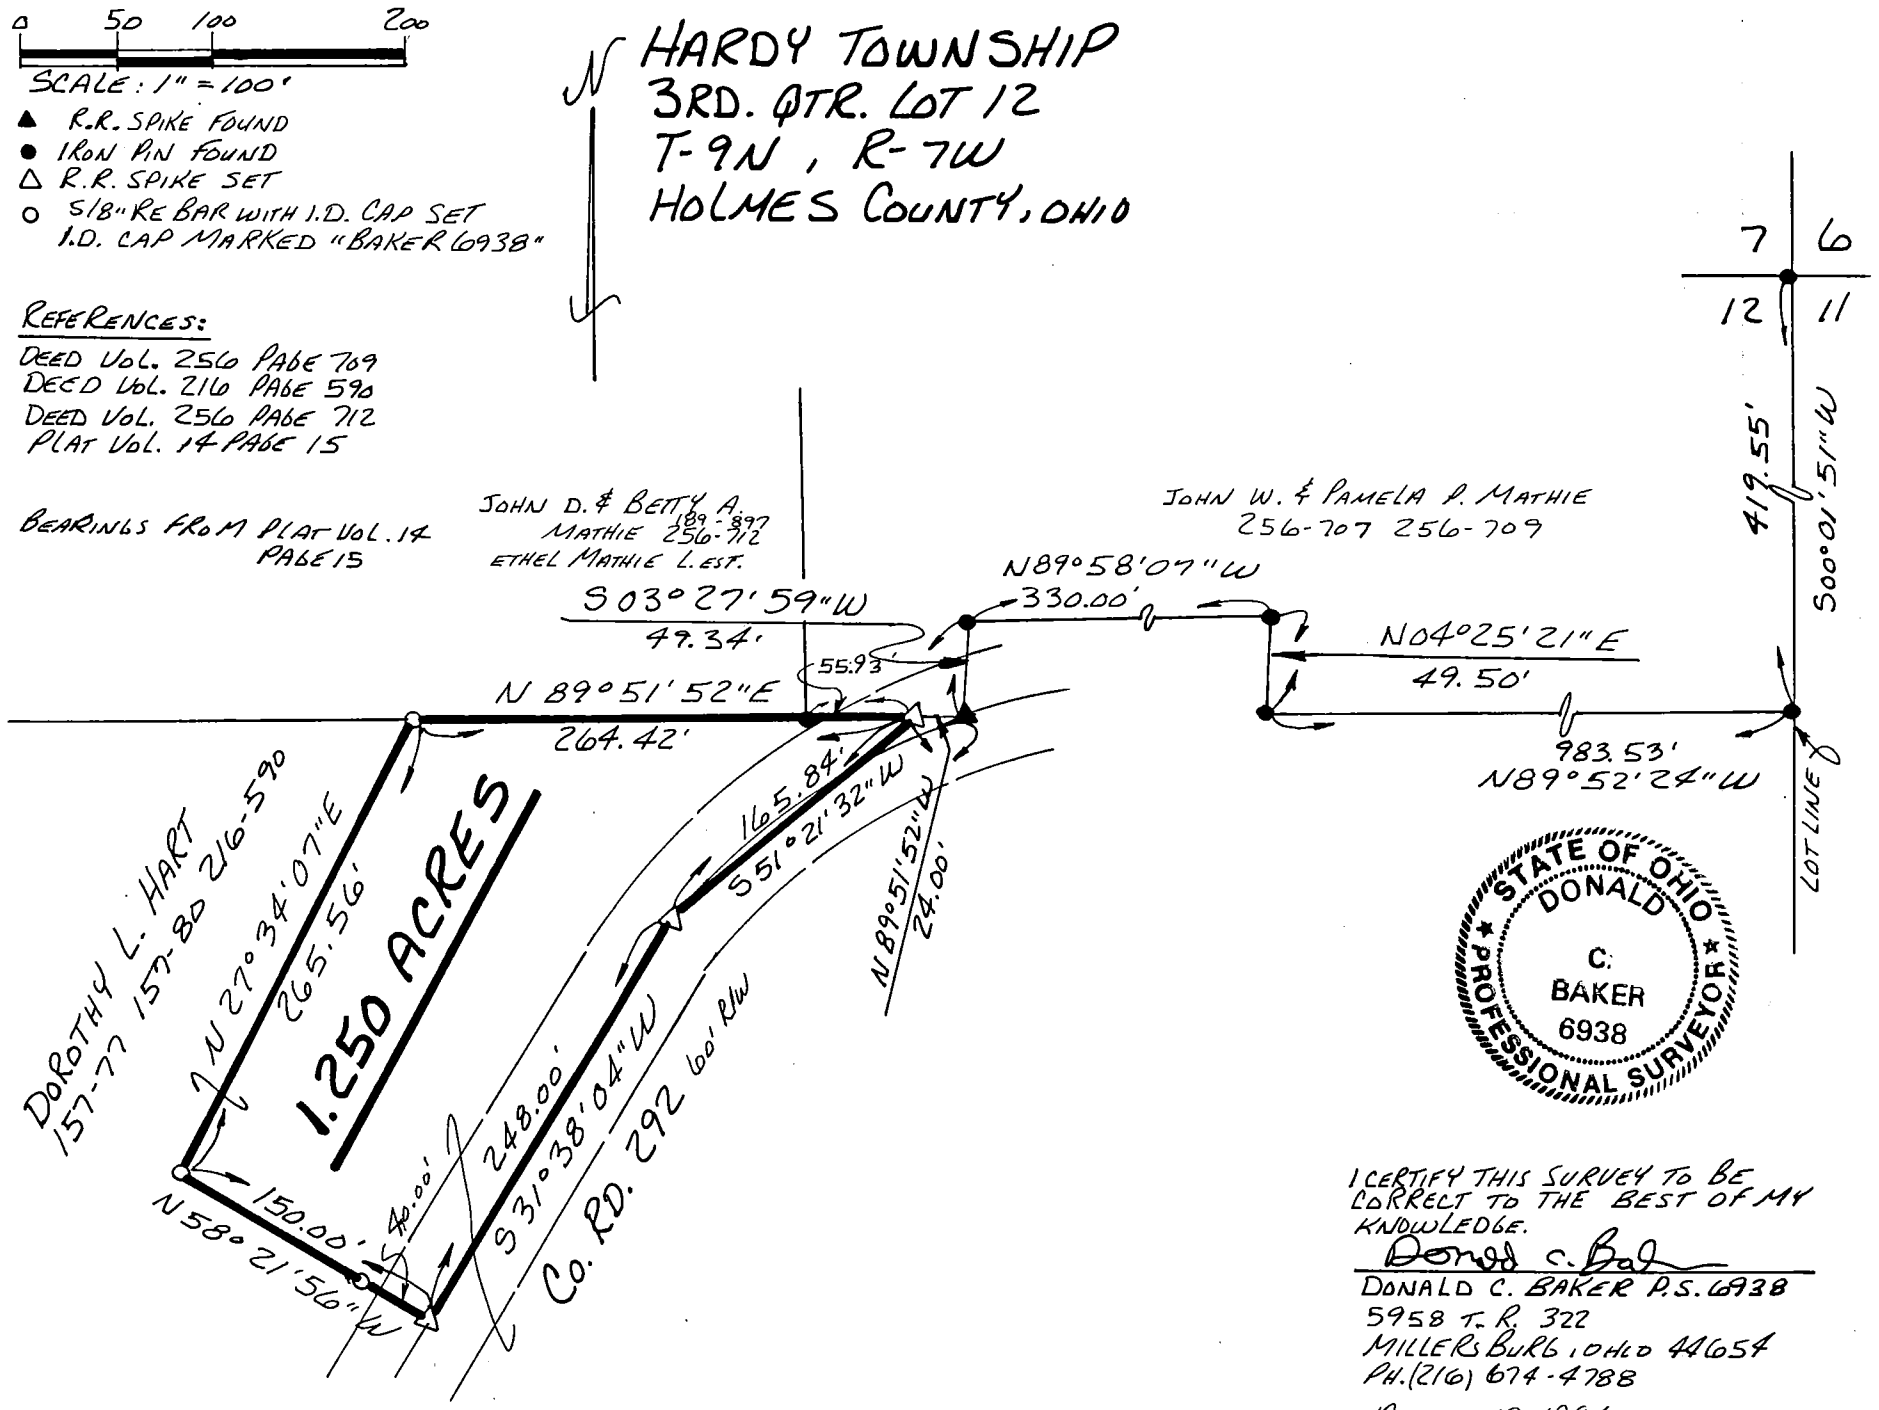

I CERTIFY THIS SURVEY TO BE CORRECT TO THE BEST OF MY KNOWLEDGE.

Donald C. Baker

DONALD C. BAKER P.S. 6938
5958 T.R 322
MILLERSBURG, OHIO 44654
PH. (216) 674-4788

AUGUST 18, 1994

44494-MLS