


HARDY TOWNSHIP
3RD. QTR. LOTS 13 & 18
T-9N; R-7W
HOLMES COUNTY, OHIO

SURVEYED FOR JANET EICHER


REFERENCES:

DEED VOL. 266 PAGE 883
 DEED VOL. 268 PAGE 268
 DEED VOL. 272 PAGE 173

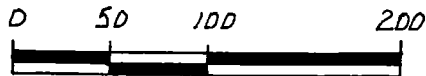


SCALE: 1" = 100'

- IRON PIN FOUND
- ▲ R.R. SPIKE FOUND
- △ R.R. SPIKE SET
- 5/8" REBAR WITH ID. CAP SET
- ID. CAP MARKED "BAKER 6938"

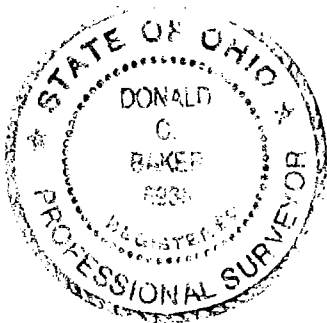

BEARINGS FROM DEED VOL. 256 PAGE 729

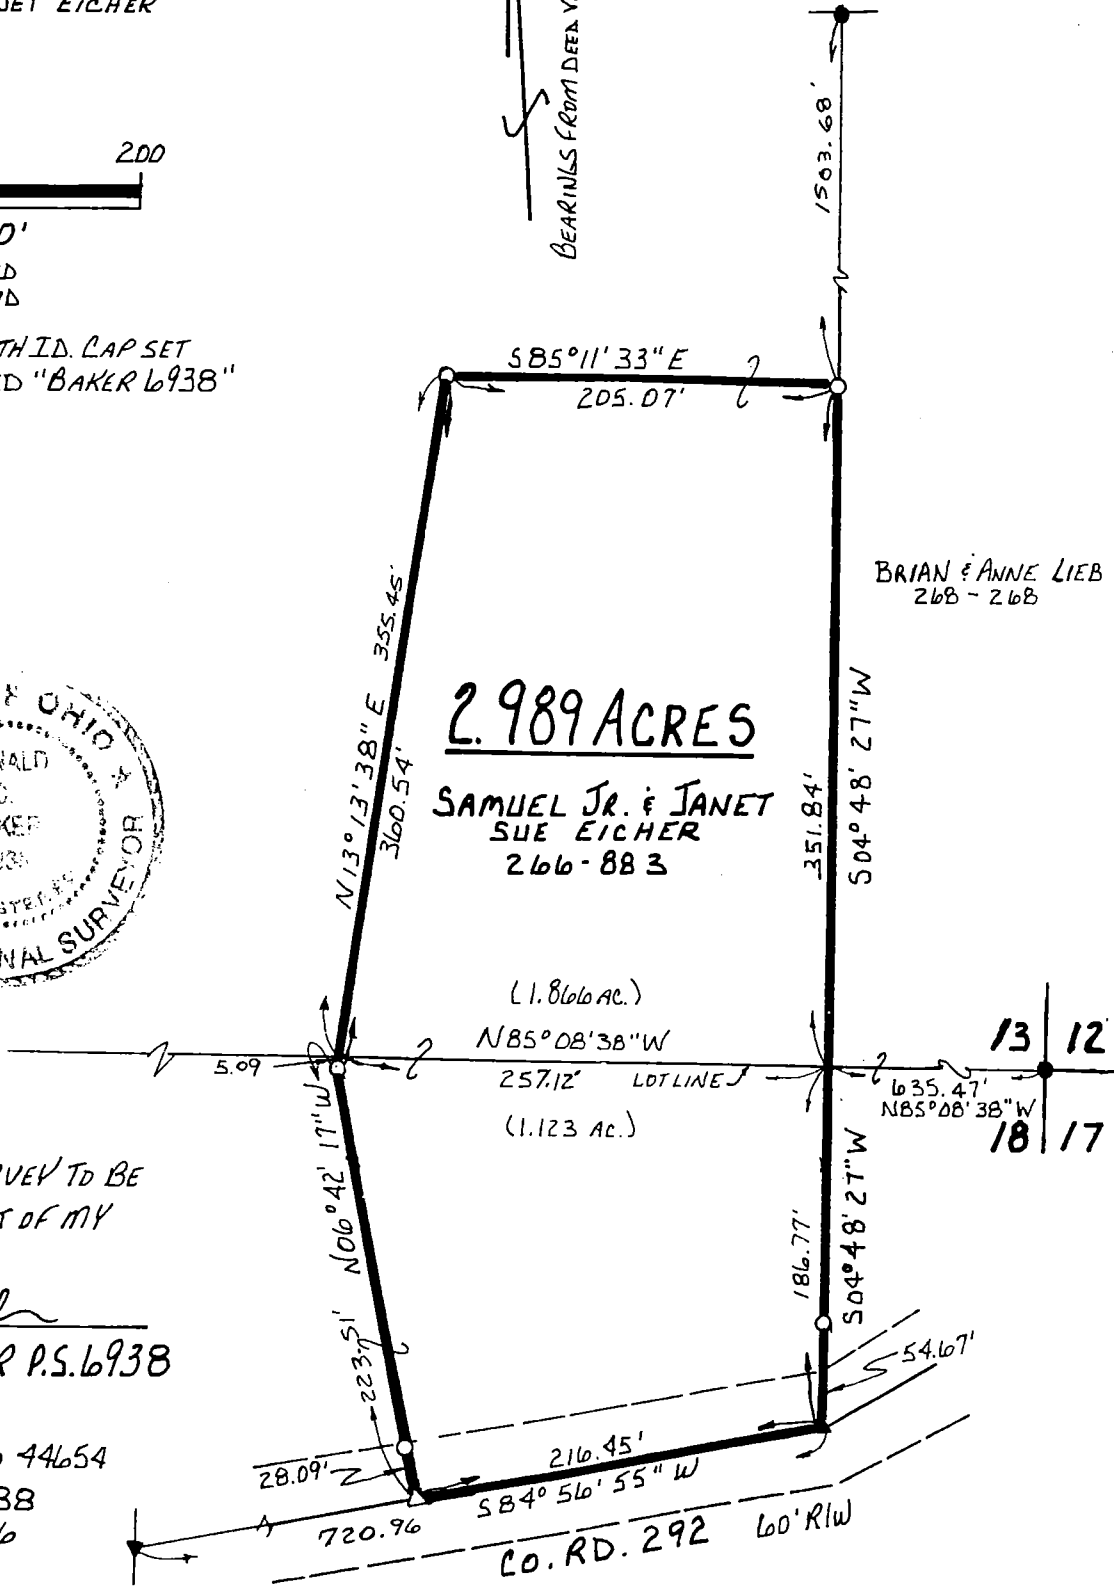

BRIAN & ANNE LIEB
 268-268

2.989 ACRES

SAMUEL JR. & JANET
SUE EICHER
 266-883

(1.866 AC.)

N85°08'38"W

(1.123 AC.)

I CERTIFY THIS SURVEY TO BE
 CORRECT TO THE BEST OF MY
 KNOWLEDGE.

Donald C. Baker
 DONALD C. BAKER P.S. 6938
 595B TR. 322
 MILLERSBURG, OHIO 44654
 PH. (330) 674-4788
 DECEMBER 27, 1996
 73496-SRU
 FCC.-J.D. DARR