


PATRICIA ROUSH
 RICHARD M. COXTERMAN
 KIRK F. COXTERMAN
 250-6

TAMMY S.
 MORRIS
 263-271

5.000
ACRES
 MICHAEL D.
 SMITH
 263-139

Co. RD. 292 60' R/W

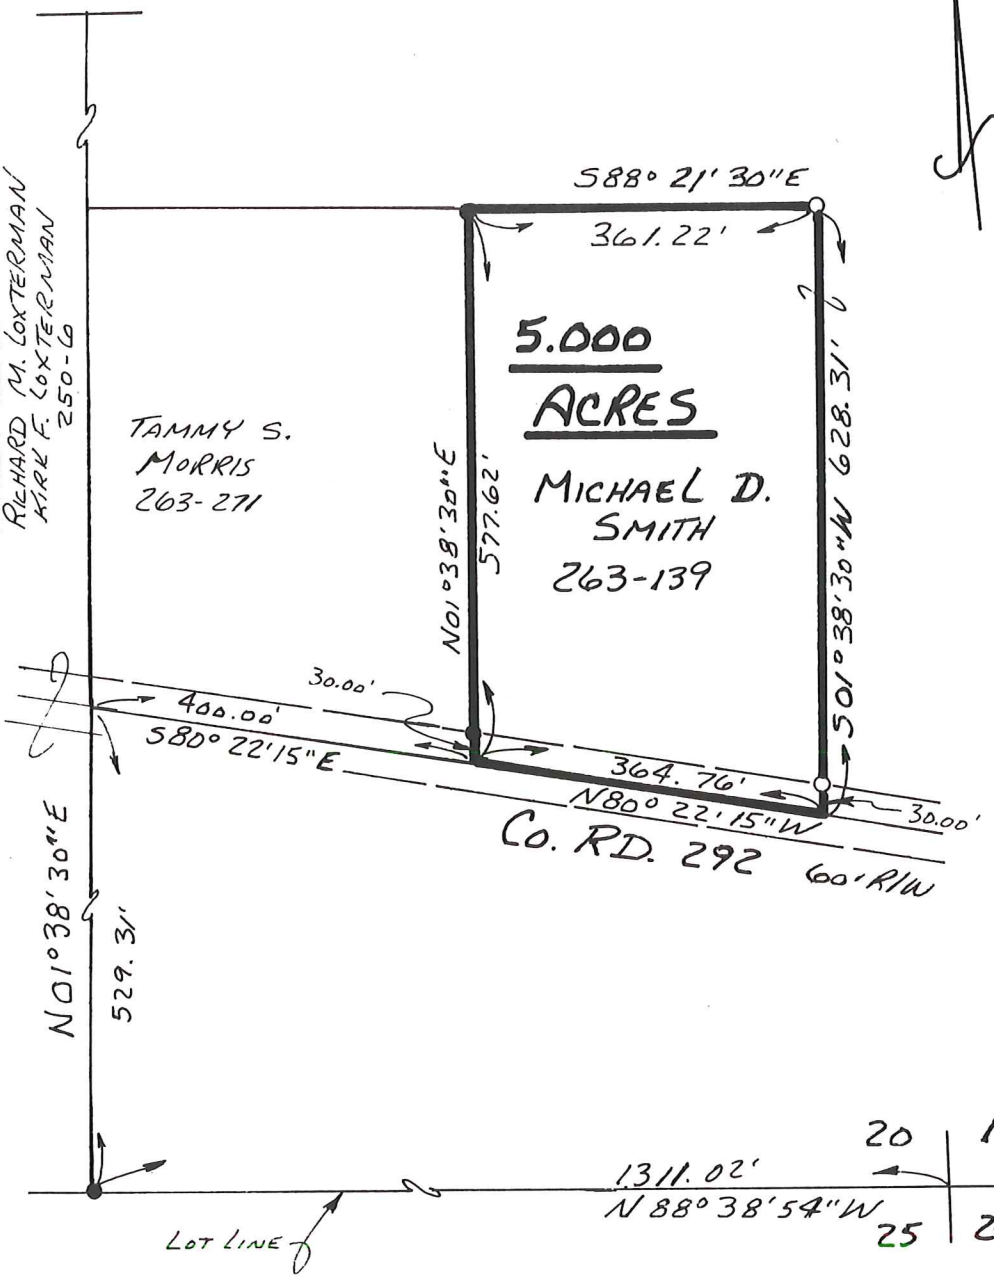

HARDY TOWNSHIP
 3 RD. QTR. LOT 20
 T. 9N; R-7W
 HOLMES COUNTY, OHIO



SCALE: 1" = 200'
 ● IRON PIN FOUND
 ○ 5/8" RE BAR WITH I.D. CAP SET
 I.D. CAP MARKED "BAKER 6938"

REFERENCES:
 DEED VOL. 177 PAGE 243
 " " 244 " 57
 " " 246 " 692
 " " 262 " 217
 " " 263 " 139
 PLAT VOL. 12 PAGE 396



20	19
25	24

I CERTIFY THIS SURVEY TO BE CORRECT TO THE BEST OF MY KNOWLEDGE.

Donald C. Baker
 DONALD C. BAKER P.S. 6938
 138 N. CLAY STREET
 MILLERSBURG, OHIO 44654
 PH. (336) 674-4788

MARCH 25, 1997

18097-McDAVIS