

HEARTLAND Surveying

Jim Shamp



5210 Twp. Rd. 257 Millersburg, OH 44654

Phone: 216-674-4698


SURVEY		DATE	
RANDY JONES		JULY 25, 1994	
STATE	COUNTY	TOWNSHIP	RANGE
OHIO	HOLMES	HARDY	7 WEST/ 6 WEST
TOWNSHIP	SECTION 11 &		HILLTOP ACRES
9 NORTH	SECTION 15		ALLOTMENT LOT 13

940715

NOTE: THIS IS A RETRACEMENT SURVEY AND IS FOR INFORMATION ONLY.

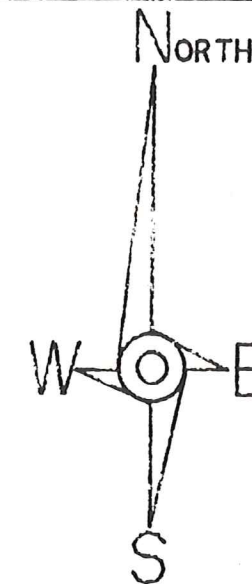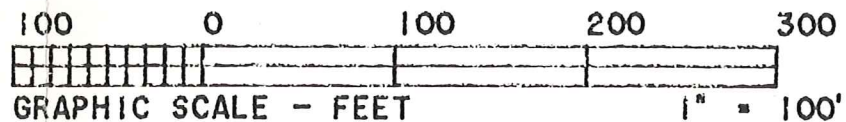

* BEARINGS ESTABLISHED FROM PLAT V. 2, P. 133

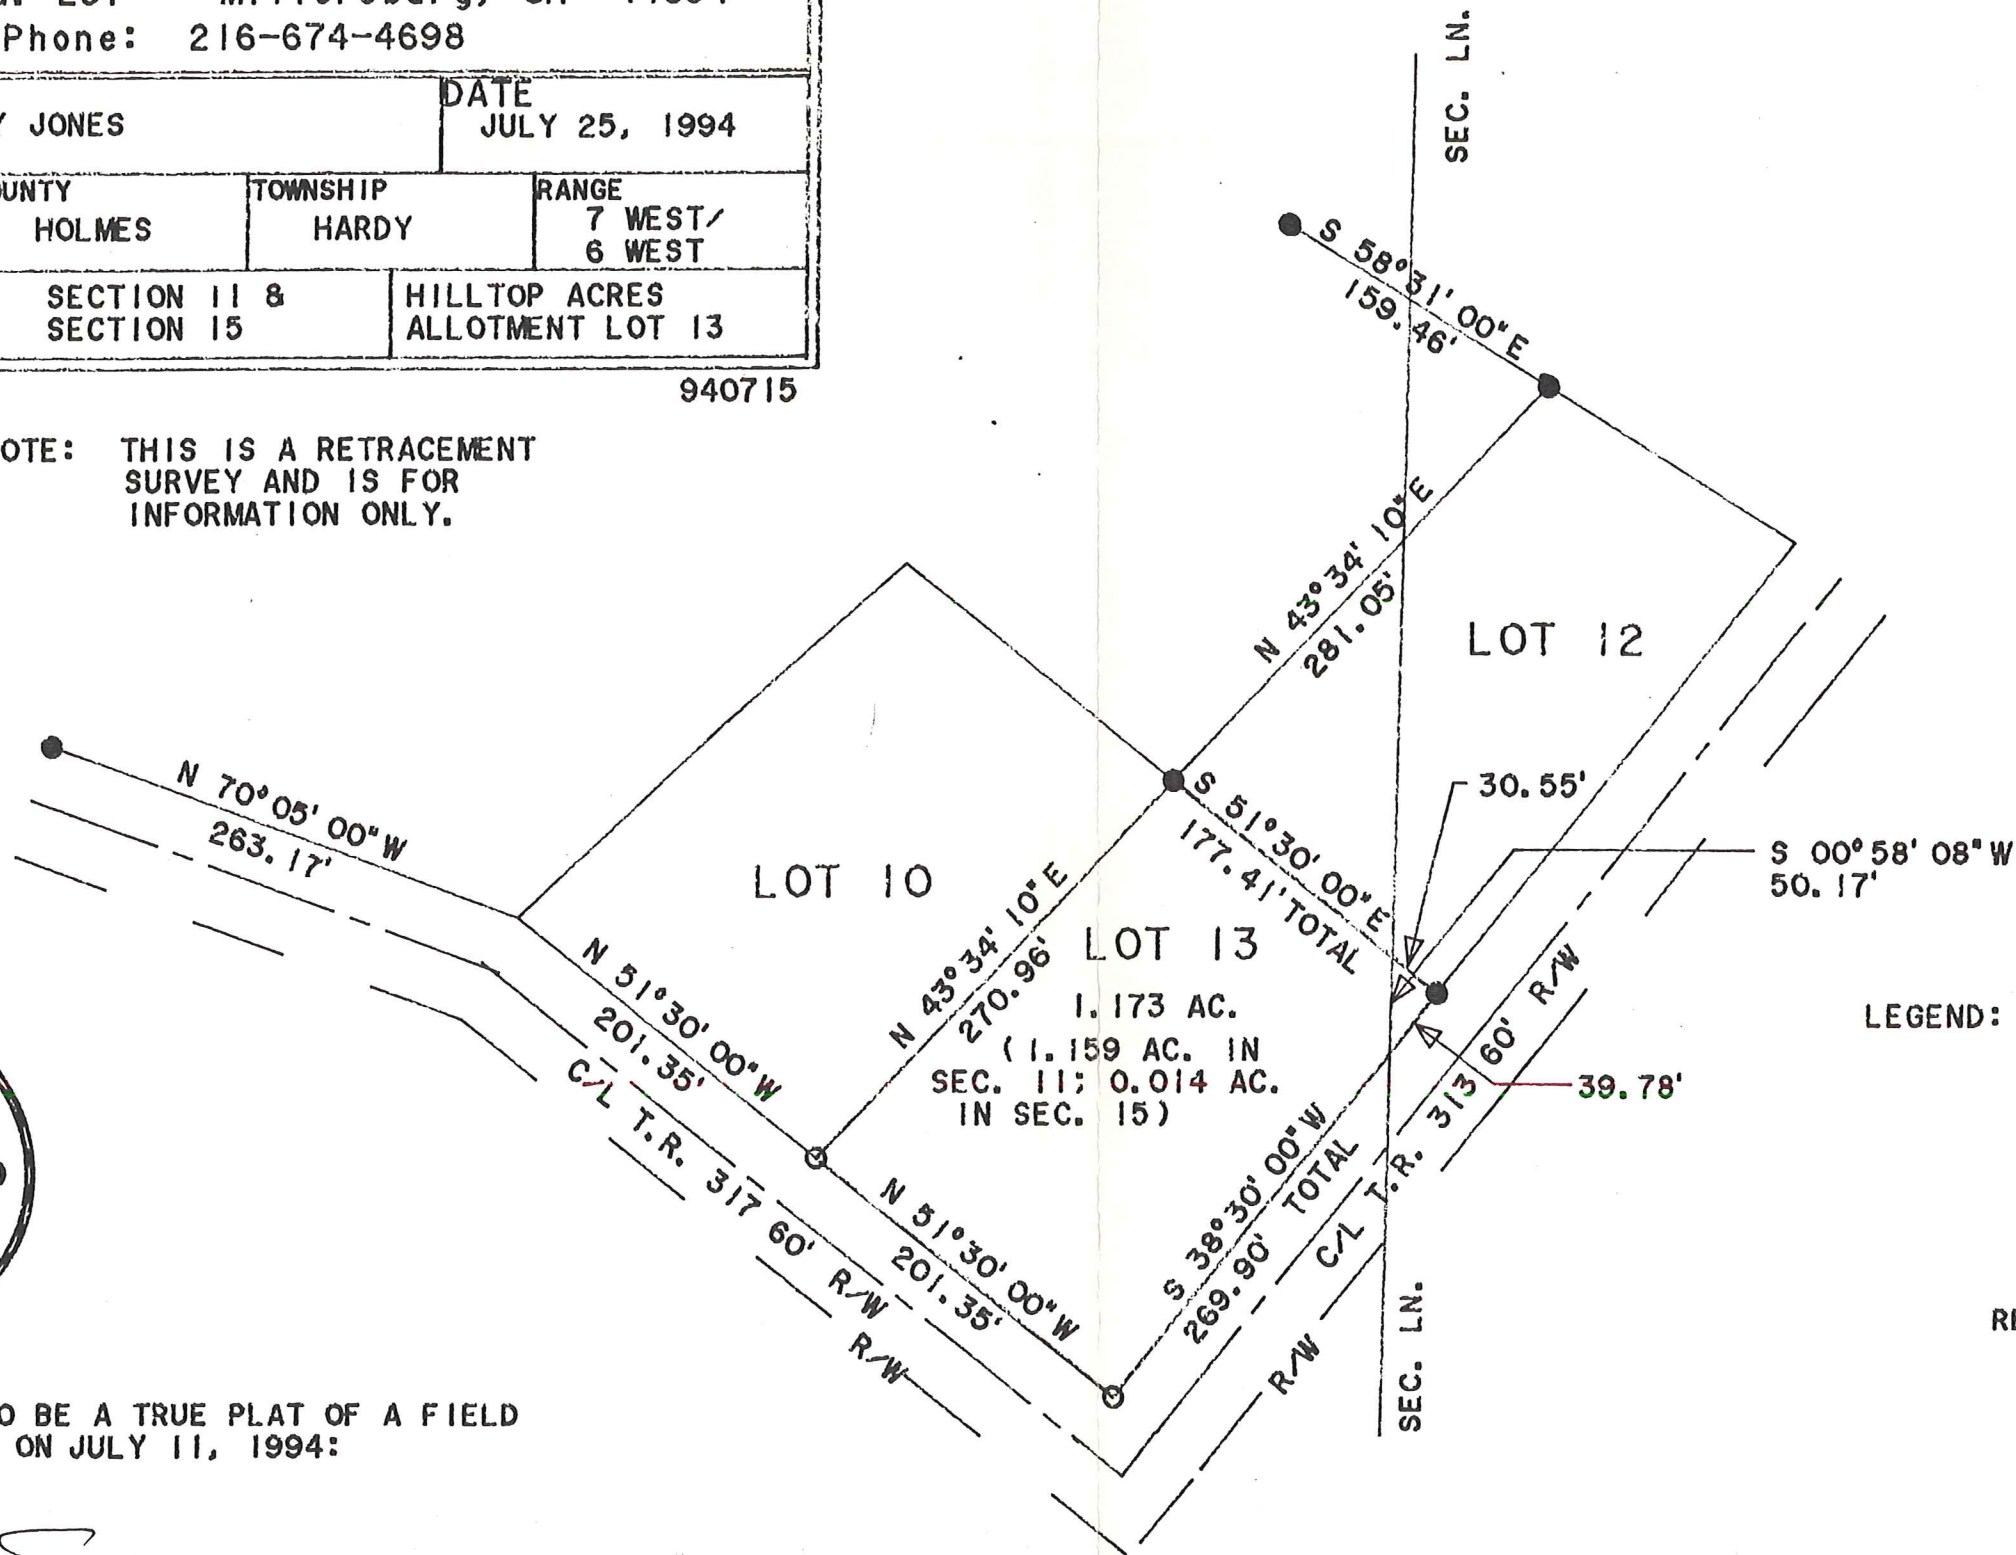

- LEGEND:
- = STONE FOUND
 - = IRON PIN/PIPE FOUND
 - = POINT-OF-DEPARTURE
 - = 5/8" X 30" RE-BAR W/I.D. CAP SET
 - ⊗ = RAILROAD SPIKE SET
 - △ = R/R SPIKE FOUND

REFERENCE DOCUMENTS:

TAX MAP
DEEDS AS SHOWN
SURVEY PLATS:

- P. 2/133
- P. 4/118
- P. 4/193
- P. 7/436
- P. 7/132
- P. 5/148
- P. 5/5
- P. 5/32
- P. 4/154



I CERTIFY THIS TO BE A TRUE PLAT OF A FIELD SURVEY COMPLETED ON JULY 11, 1994:

Jim Shamp

JIM SHAMP, REG. SUR. NO. S-6088