

HARDY TOWNSHIP  
 N.W. QTR. SECTION 21  
 T-9N; R-7W  
 HOLMES COUNTY, OHIO

589°00'54"W 20 20  
 1401.48' REC. 21 21




SCALE: 1" = 100'

- IRON PIN FOUND
- 5/8" REBAR WITH I.D. CAP SET
- I.D. CAP MARKED "BAKER 6938"

REFERENCES:

DEED VOL. 259 PAGE 235  
 DEED VOL. 226 PAGE 470  
 DEED VOL. 168 PAGE 371

BEARINGS FROM PLAT VOL. 10 PAGE 343

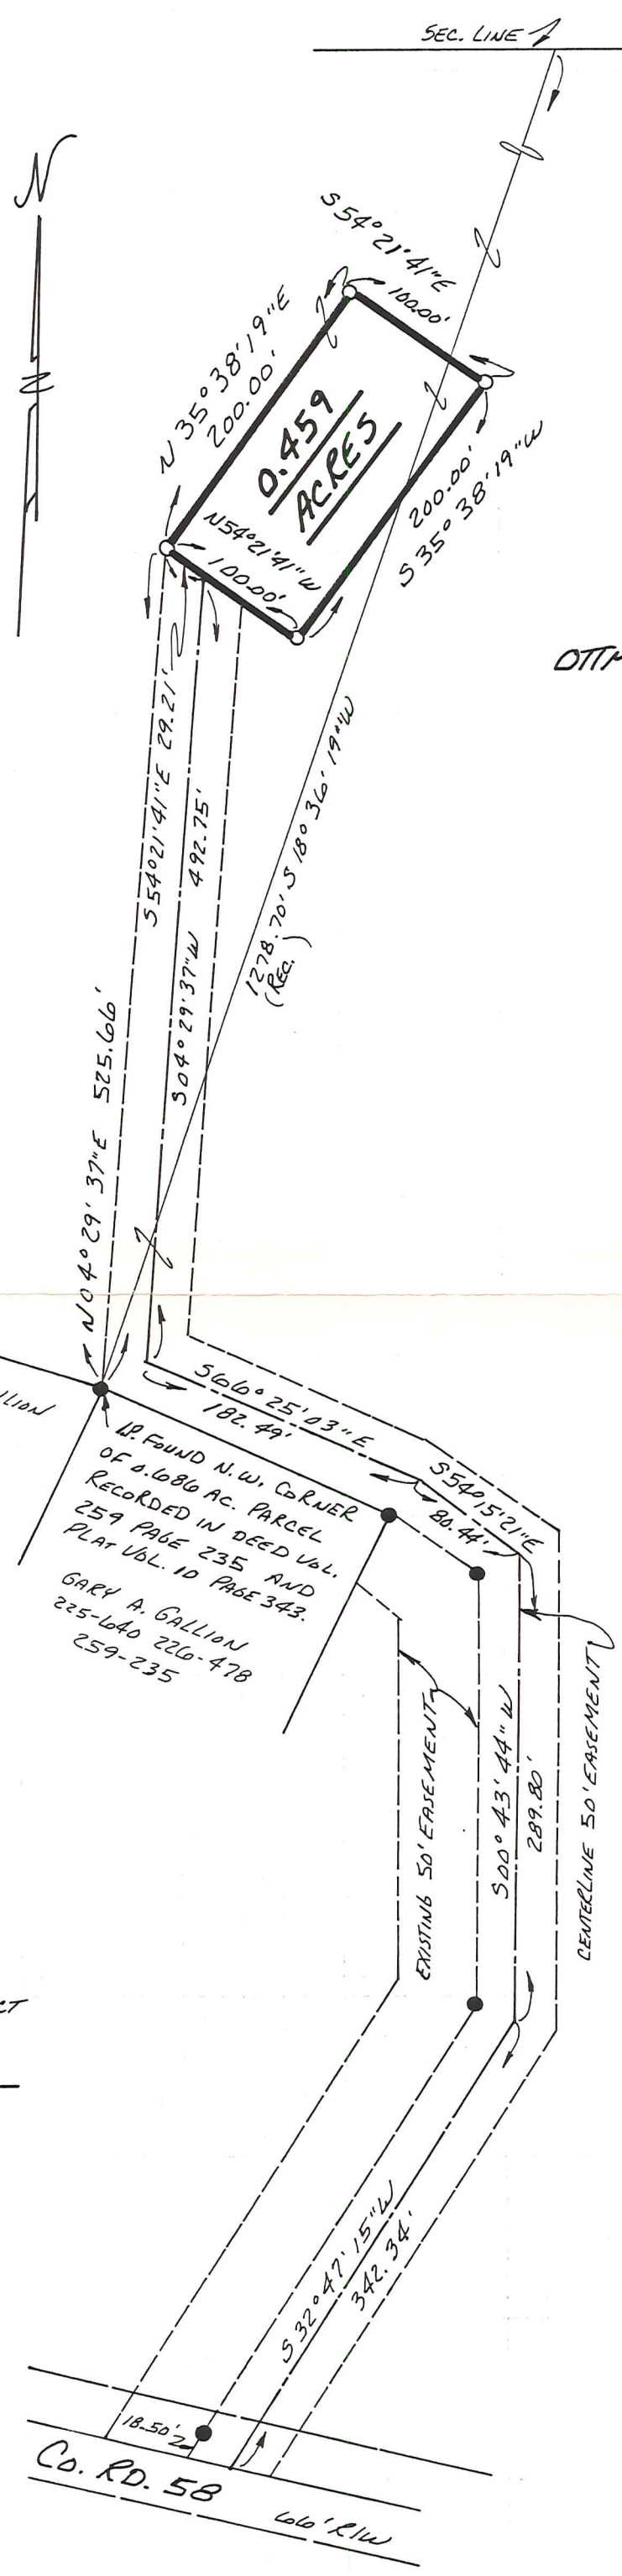

OTTMAR G. & JEAN M.  
 GALLION  
 168-371

IR. FOUND N.W. CORNER  
 OF 0.686 AC. PARCEL  
 RECORDED IN DEED VOL.  
 259 PAGE 235 AND  
 PLAT VOL. 10 PAGE 343.  
 GARY A. GALLION  
 225-640 226-478  
 259-235



I CERTIFY THIS SURVEY TO BE CORRECT  
 TO THE BEST OF MY KNOWLEDGE.

Donald C. Baker  
 DONALD C. BAKER P.S. 6938  
 5958 T.R. 322  
 MILLERSBURG, OHIO 44654  
 PH. (216) 674-4788  
 OCT. 18, 1993

52693-MLS