



HARDY TOWNSHIP
 N.E. QTR. SEC. 22
 TWP. 9N RANGE 7W
 HOLMES COUNTY, OHIO

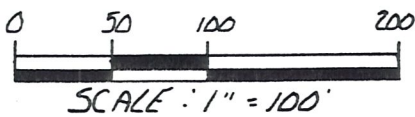

- ▲ R.R. SPIKE FOUND
- IRON PIN FOUND
- △ R.R. SPIKE SET
- 5/8" REBAR WITH I.D. CAP SET
I.D. CAP MARKED "BAKER 6938"
- ⊗ P.K. NAIL SET

REFERENCES:
 PLAT VOL. 10 PAGE 299
 PLAT VOL. 4 PAGE 38
 PLAT VOL. 11 PAGE 41 & 42
 DEED VOL. 223 PAGE 462

BEARINGS FROM PLAT VOL. 2
 PAGE 193

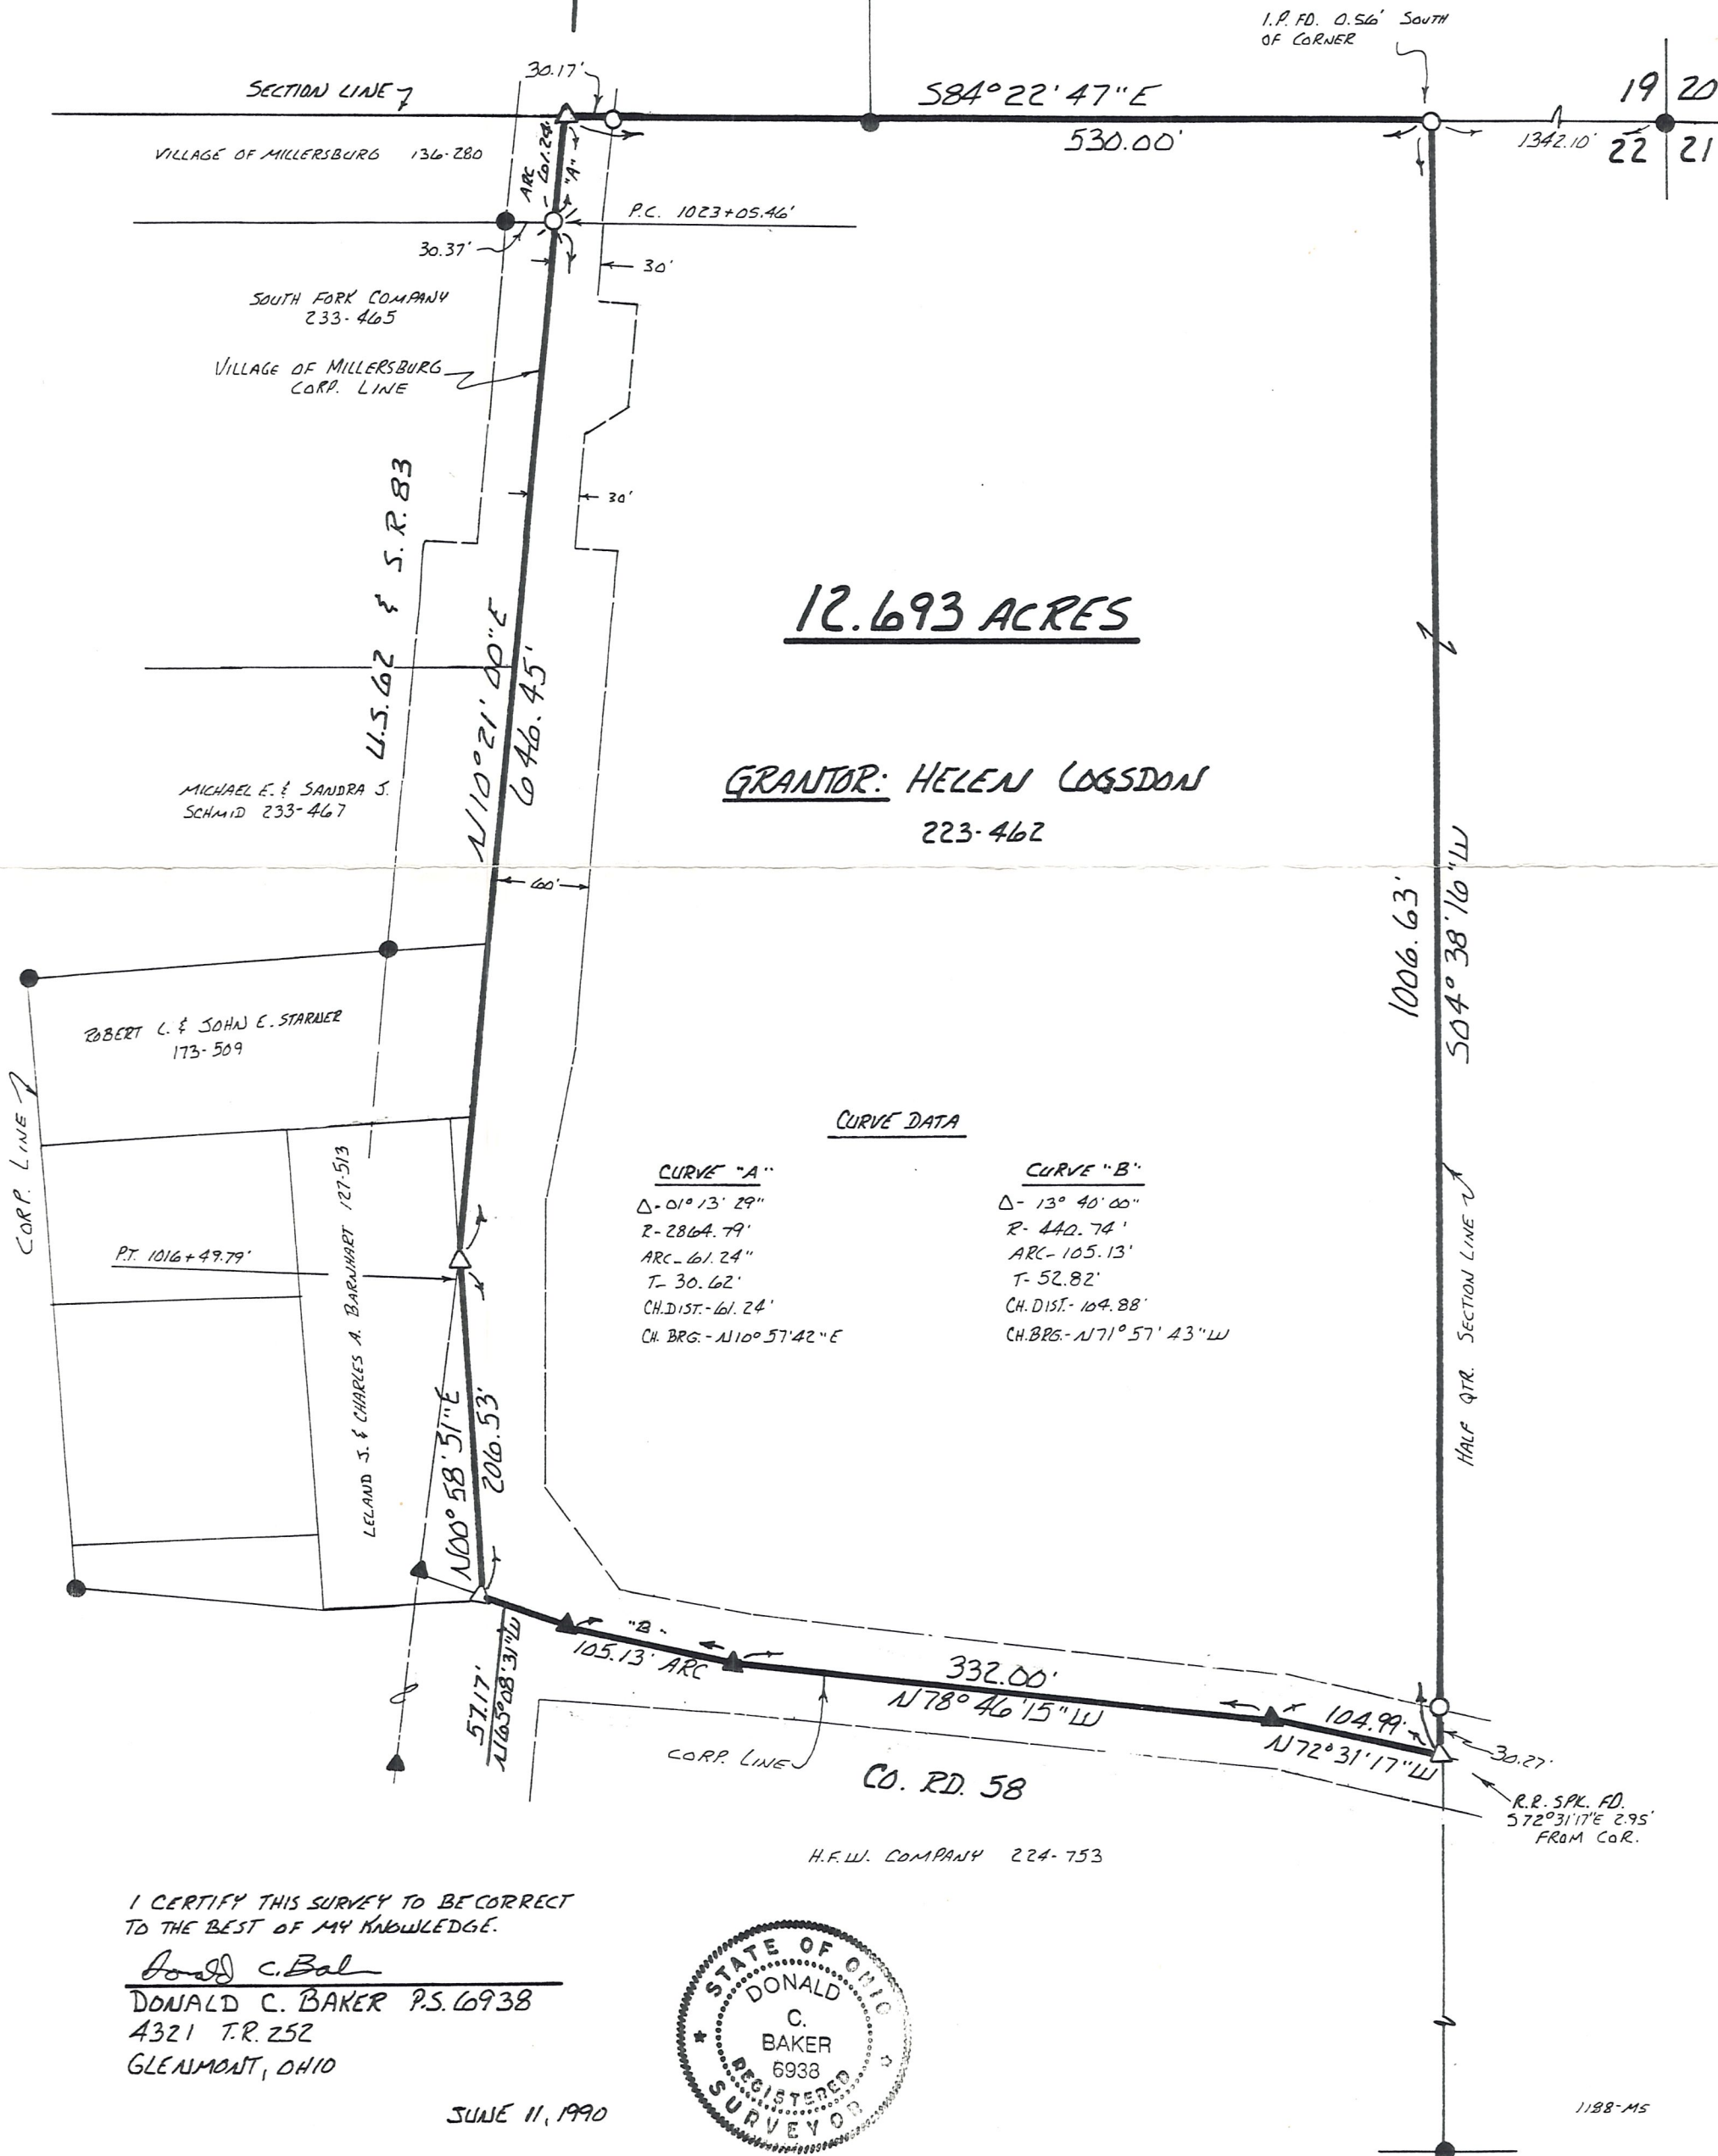

12.693 ACRES

GRANTOR: HELEN COGSDON
 223-462

CURVE DATA

CURVE "A"

Δ - 01° 13' 29"
 R - 2864.79'
 ARC - 61.24"
 T - 30.62'
 CH. DIST. - 61.24'
 CH. BRG. - N110° 57' 42" E

CURVE "B"

Δ - 13° 40' 00"
 R - 442.74'
 ARC - 105.13"
 T - 52.82'
 CH. DIST. - 104.88'
 CH. BRG. - N71° 57' 43" W

I CERTIFY THIS SURVEY TO BE CORRECT
 TO THE BEST OF MY KNOWLEDGE.

Donald C. Baker
 DONALD C. BAKER P.S. 6938
 4321 T.R. 252
 GLENMONT, OHIO

JUNE 11, 1990

