


- SCALE: 1" = 100'
- ▲ R.R. SNAKE FOUND
  - IRON PINT FOUND
  - 5/8" RE BAR WITH I.D. CAP SET
  - I.D. CAP MARKED "BAKER 6938"

HARDY TOWNSHIP  
 N.E. QTR. SECTION 22  
 T. 9 N. R. 7 W  
 HOLMES COUNTY, OHIO  
 (SURVEYED FOR: LARRY LINDER)

REFERENCES:  
 O.R. VOL. 2 PAGE 638  
 O.R. VOL. 12 PAGE 826  
 O.R. VOL. 6 PAGE 730  
 O.R. VOL. 19 PAGE 234  
 DEED VOL. 206 PAGE 798  
 " " 209 " 212  
 " " 201 " 66


PLAT VOL. 2 PAGE 193  
 " " 15 " 41

BEARINGS FROM PLAT VOL. 16 PAGE 900

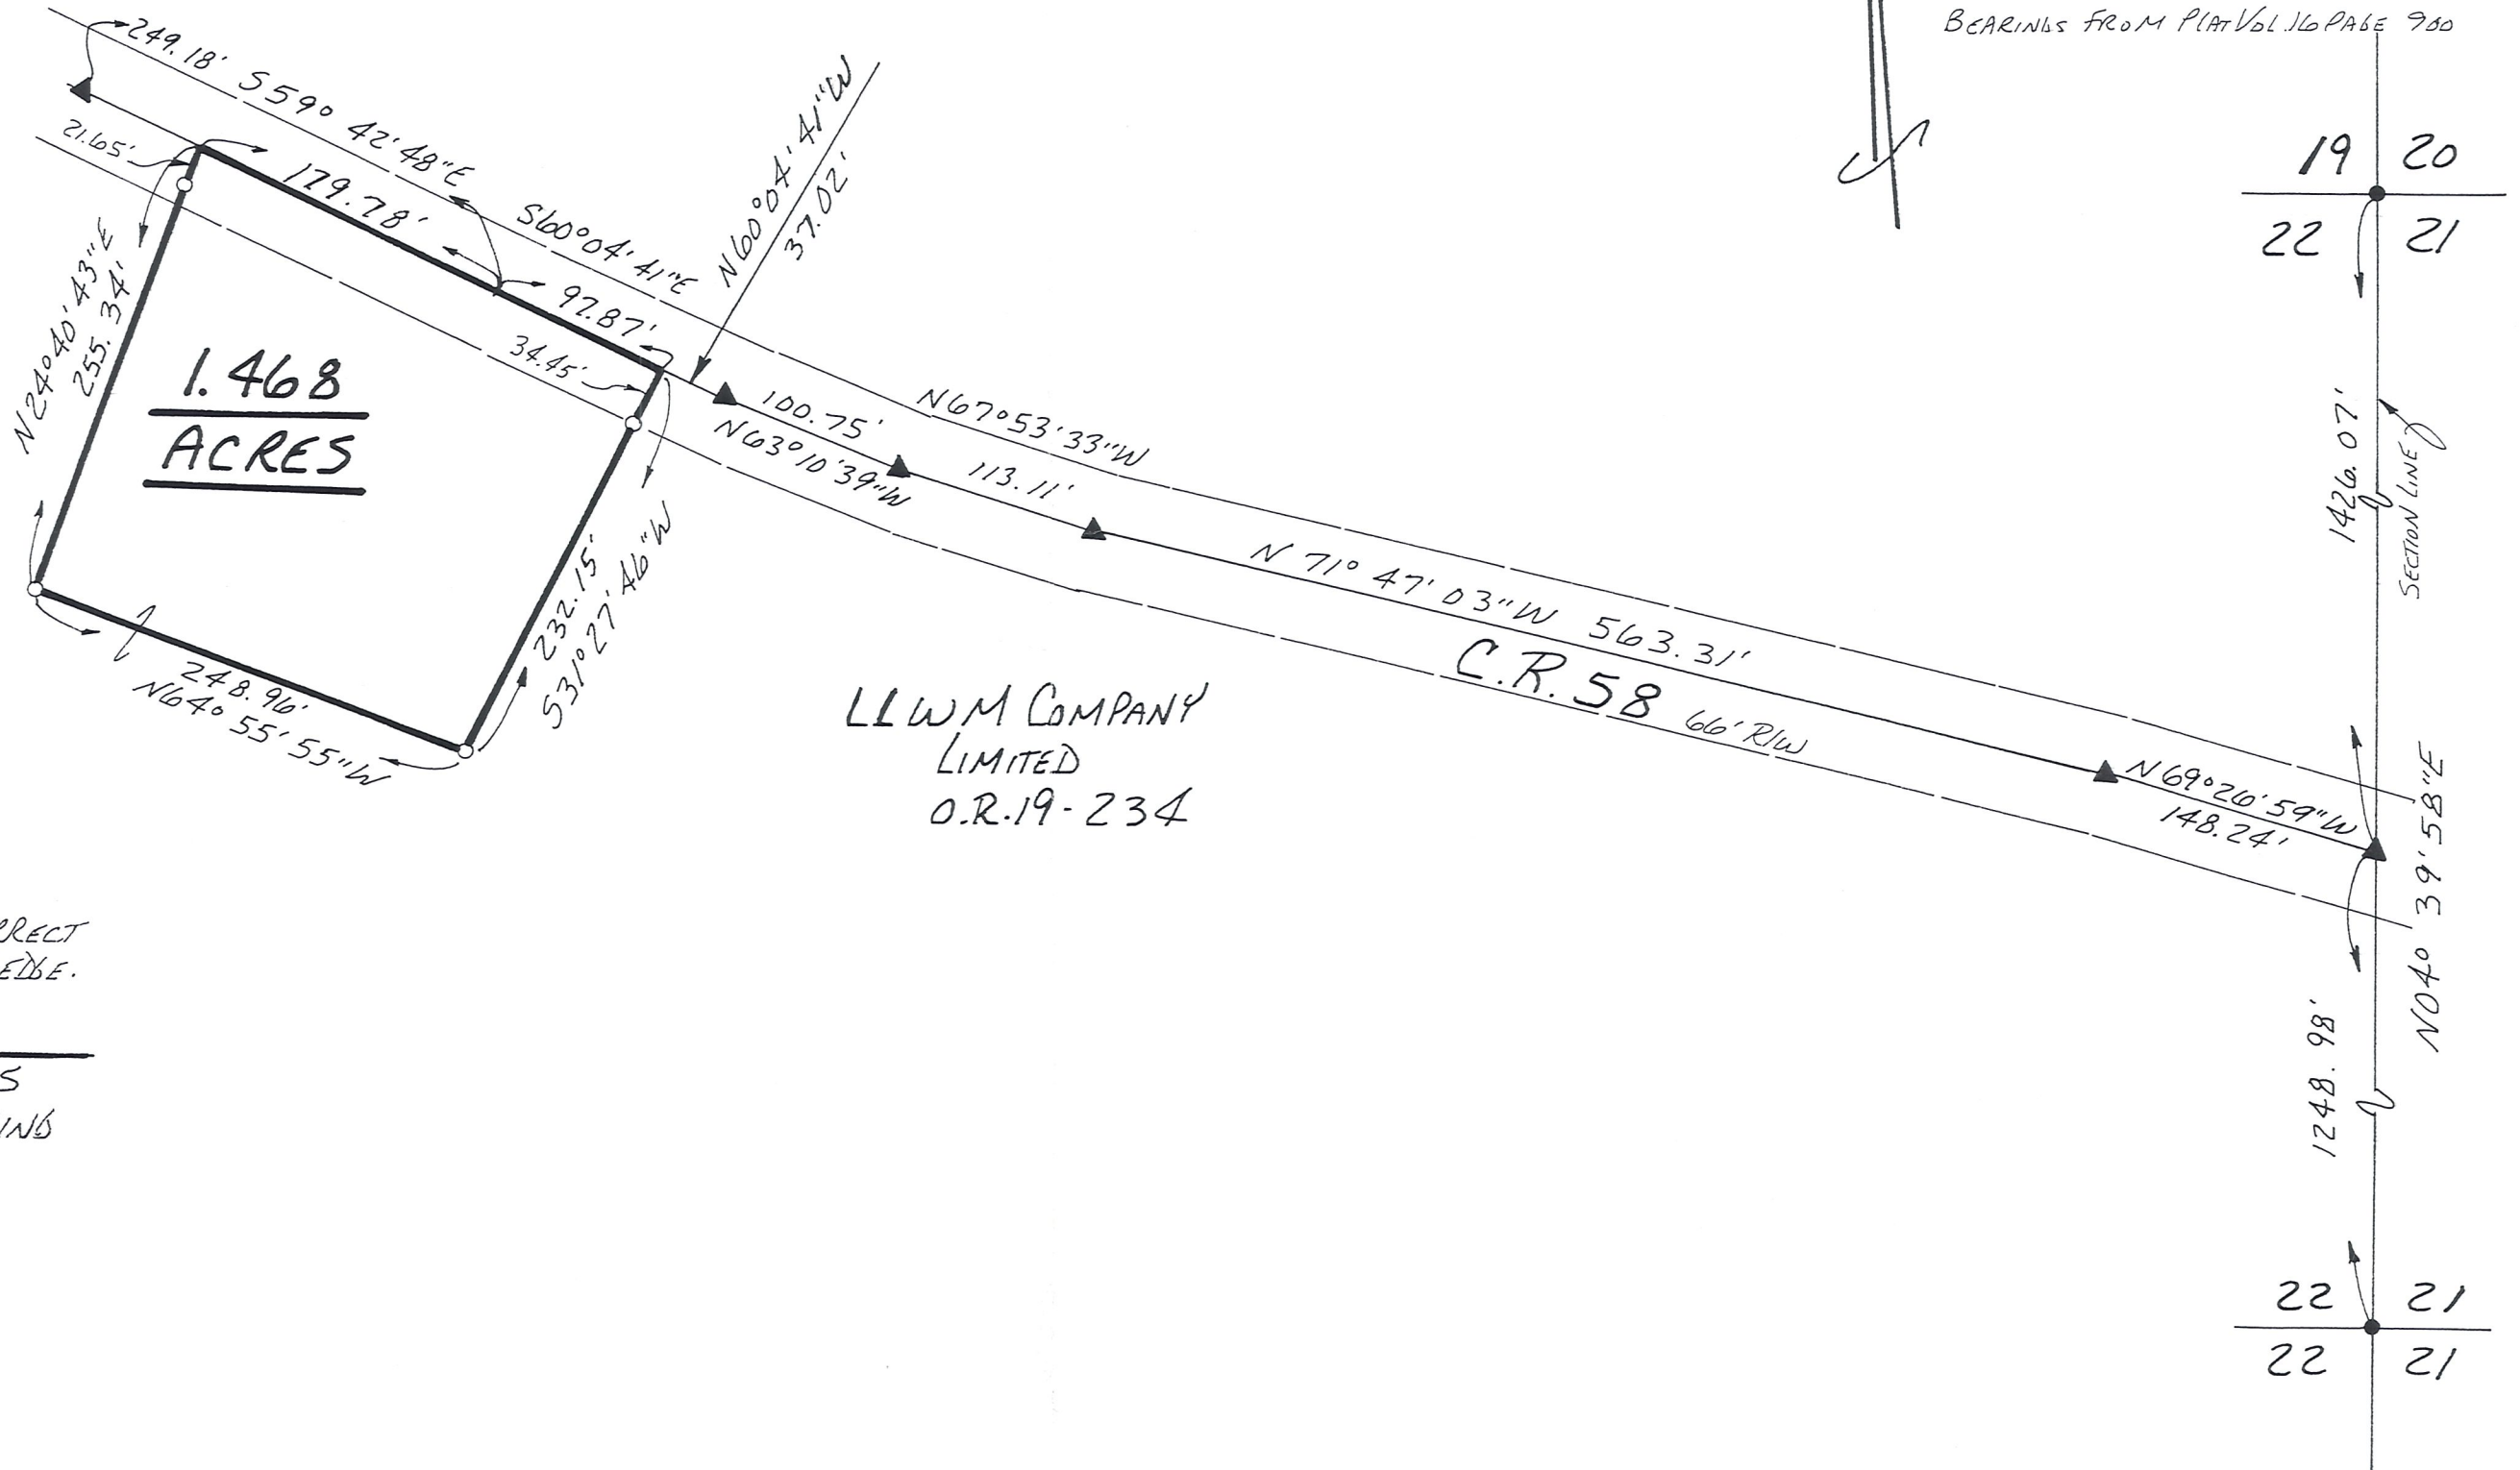

1.468  
ACRES

LLWM COMPANY  
 LIMITED  
 O.R. 19-234

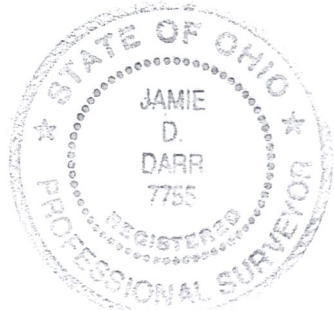

I CERTIFY THIS SURVEY TO BE CORRECT  
 TO THE BEST OF MY KNOWLEDGE.

*Jamie D. Darr*  
 JAMIE D. DARR P.S. 7755  
 DONALD C. BAKER SURVEYING  
 138 N. CLAY ST.  
 MILLERSBURG, OHIO 44654  
 PH. 330-674-4788  
 MARCH 6, 2001  
 # 11601 - M.C. DAVIS  
 F.C.C. - J.D. DARR

