



CARPENTER ST.

50'

VILLAGE OF KILLBUCK
LOT 188, SEC. 15, T-8N; R-7W
HOLMES COUNTY, OHIO

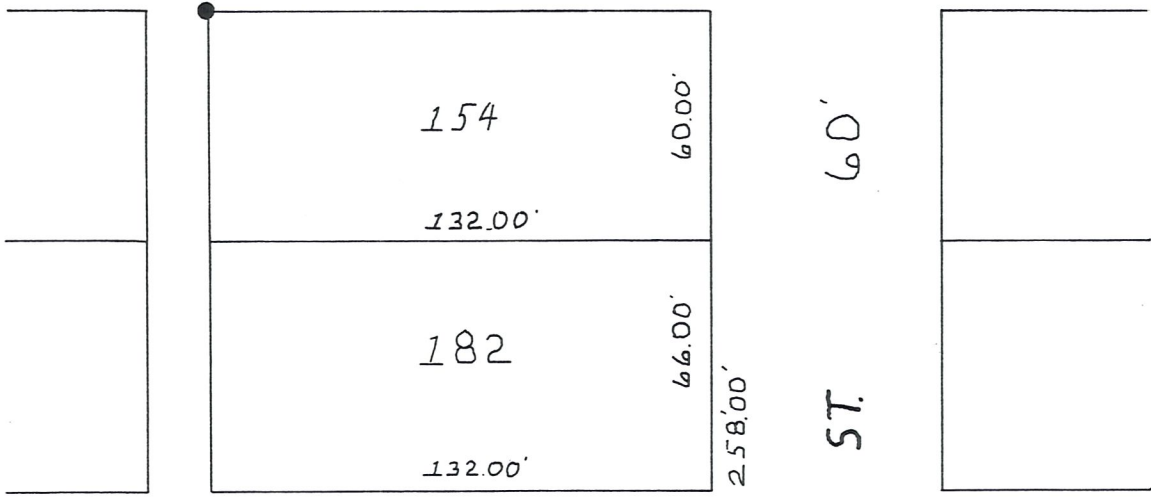


ALLEY 16'

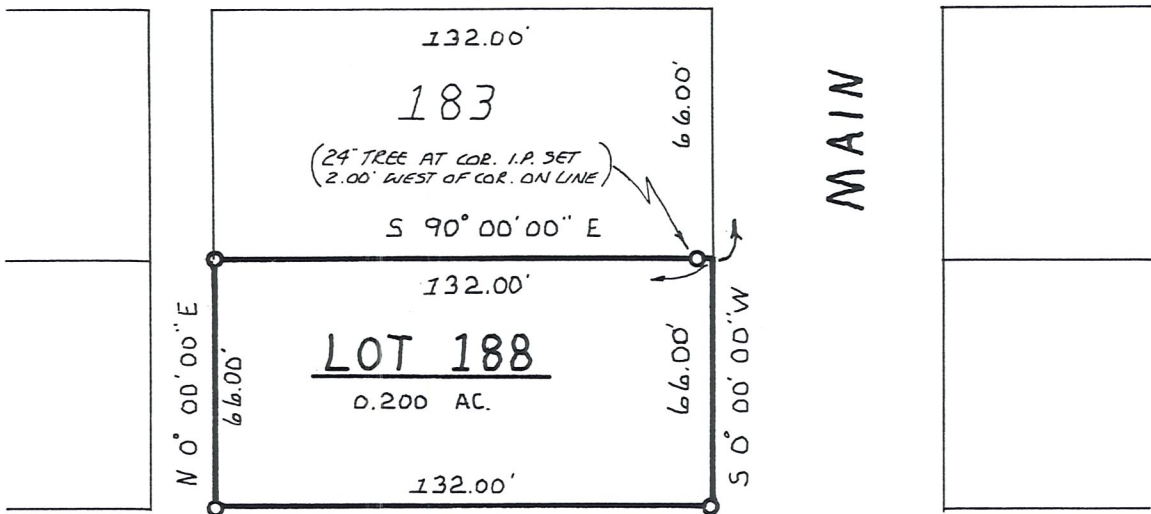


GROVER ST.

40'

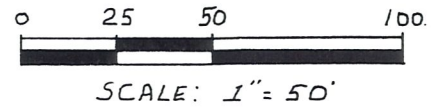

- STONE WITH "X" FD
 - IRON PIN FD
 - 5/8" RE-BAR WITH I.D. CAP SET
- BEARINGS ASSUMED

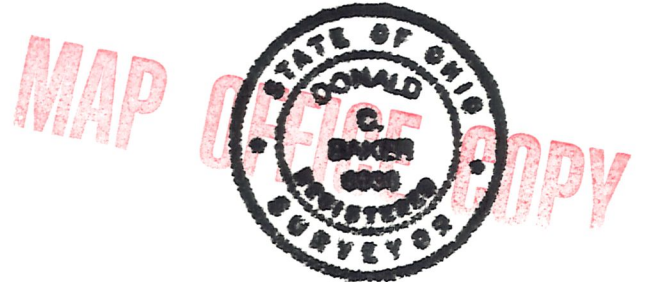

I CERTIFY THIS SURVEY TO BE CORRECT TO THE BEST OF MY KNOWLEDGE.

Donald C. Baker

DONALD C. BAKER P.S. 6938
4321 T.R. 252
GLENMONT OH.

OCT. 8, 1987