


VILLAGE OF KILLBUCK PART OF LOT 189

KILLBUCK TOWNSHIP
N.W. QTR. SEC. 15, T-8N; R-7W
HOLMES COUNTY, OHIO

CARPENTER ST. 50'

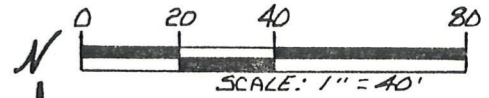

- STONE FOUND
- IRON PIN FOUND
- 5/8" REBAR WITH I.D. CAP SET
I.D. CAP MARKED "BAKER 6938"
- ⊗ HOLE CUT IN CONC. WALK

BEARINGS ASSUMED

NOTE:

* DEED VOL. 84 PAGE 570 CALLS LOTS 187 & 189 AS BEING PART OF CARPENTERS ADDITION TO THE VILLAGE OF KILLBUCK. (NO PLAT FOUND)
SAID DEED CALLS LOT 189 - BEING 154' ON THE NORTH LINE & 160' ON THE SOUTH LINE.

154
182

183

188

193

MAIN ST. 60'

N 00° 00' 00" E

181

16'

186

190

132.00'

ALLEY 16'

180

ALLEY 148.00' DEED *

187

154.00' DEED *
N 89° 53' 20" E
78.00' 76.00'

0.120 ACRES
MICHAEL DAVID
JUDSON
241-242

189

78.00' 82.00'

160.00' DEED *
S 89° 53' 20" W

ST.

RAILROAD

ST. 40'

N 89° 53' 20" E

132.00'
194

195

MAP



COPY

I CERTIFY THIS SURVEY TO BE CORRECT TO THE BEST OF MY KNOWLEDGE

Donald C. Baker
DONALD C. BAKER P.S. 6938
4321 T.R. 252
GLENMONT, OHIO 44628
SEPT. 7, 1990
1307-MS