

VILLAGE OF KILLBUCK  
PART OF LOT 52  
KILLBUCK TOWNSHIP  
HOLMES COUNTY, OHIO

SURVEYED FOR: ACCUTITLE AGENCY



REFERENCES

- O.R. VOL. 39 PAGE 416
- O.R. VOL. 187 PAGE 1143
- O.R. VOL. 193 PAGE 3355
- MISCELLANEOUS REC. VOL. 1 PAGE 143
- PLAT VOL. 1 PAGE 125
- PLAT VOL. 2 PAGE 406
- PLAT VOL. 12 PAGE 511
- PLAT VOL. 19 PAGES 789, 898 & 918
- BEARINGS FROM PLAT VOL. 19 PAGE 789



SCALE: 1"=30'

- DRILL HOLE FOUND
- 5/8" REBAR FOUND UNLESS OTHERWISE NOTED
- DRILL HOLE SET
- 5/8" REBAR SET WITH I.D. CAP I.D. CAP MARKED "BAKER 6938"

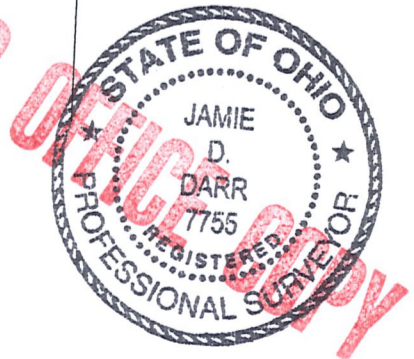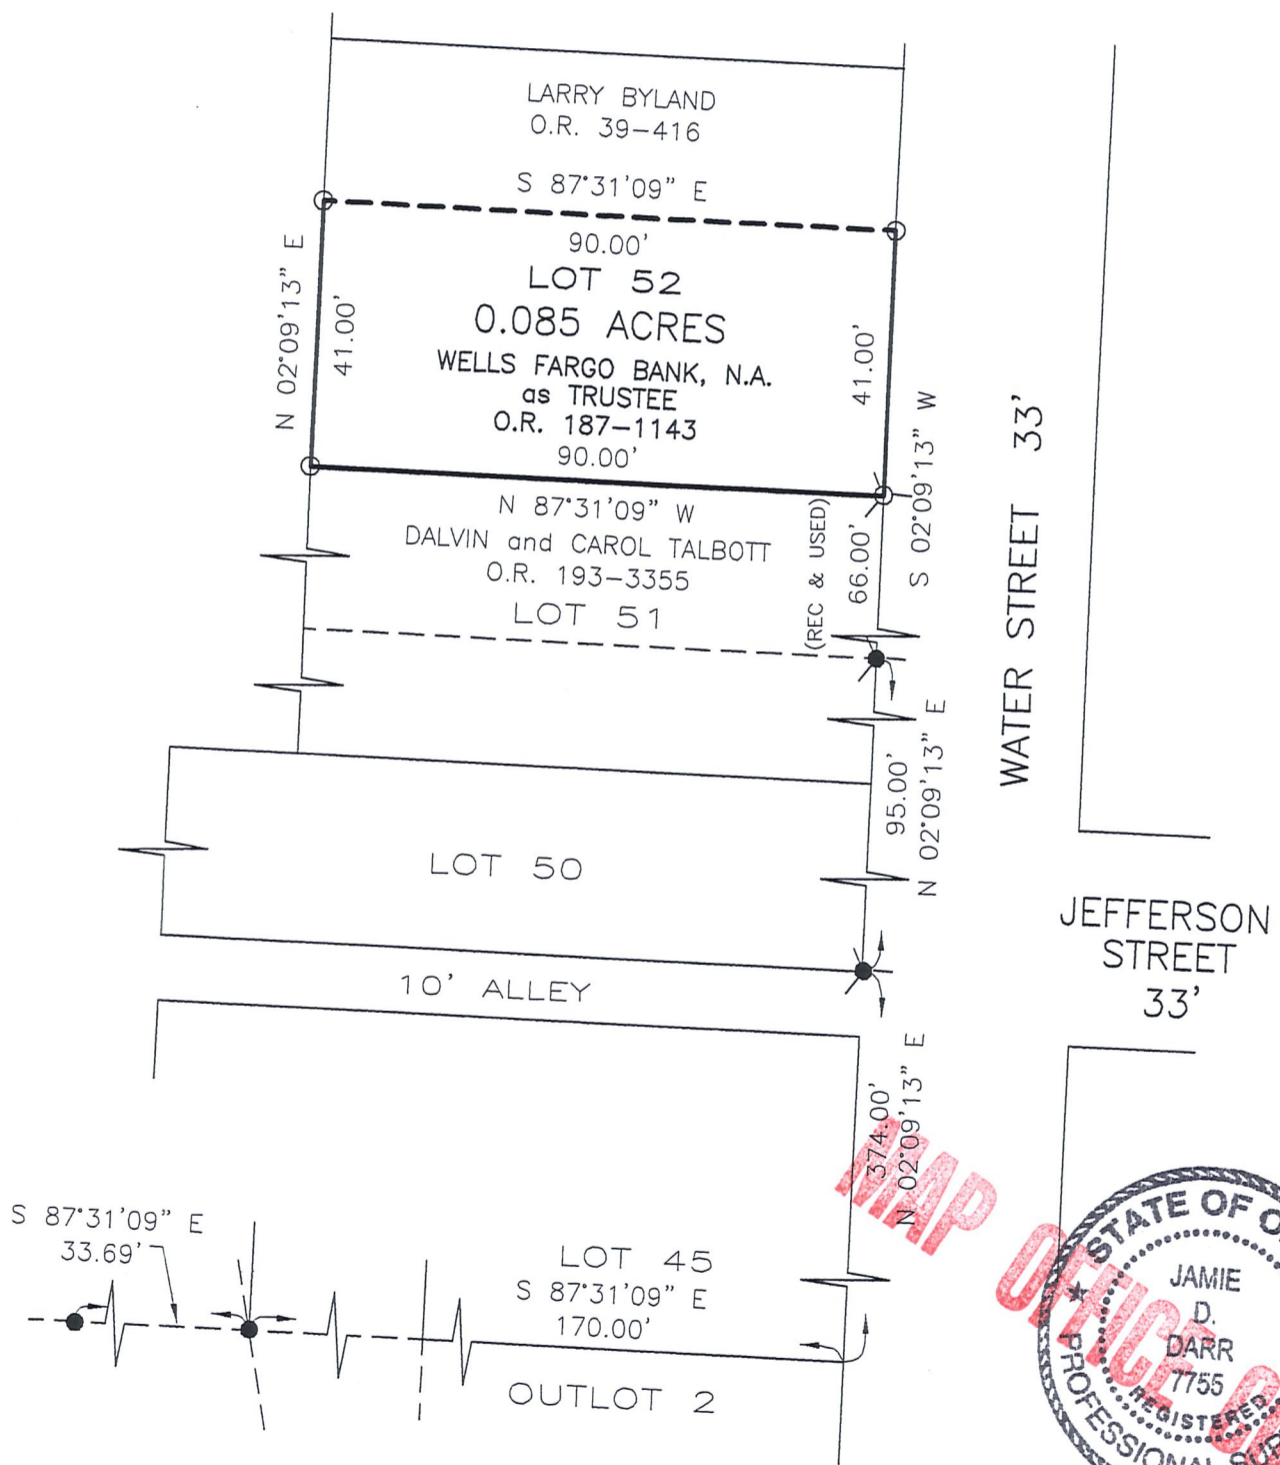

DONALD C. BAKER SURVEYING  
138 N. CLAY STREET  
MILLERSBURG, OHIO 44654  
PH. 330-674-4788  
FAX 330-674-6027

I CERTIFY THIS SURVEY TO BE CORRECT TO THE BEST OF MY KNOWLEDGE.

*(Signature)*  
JAMIE D. DARR P.S. 7755  
DATE: JUNE 19, 2007  
JDD\WMB  
FILE NAME: WORK3\S-384-07\ERZ