
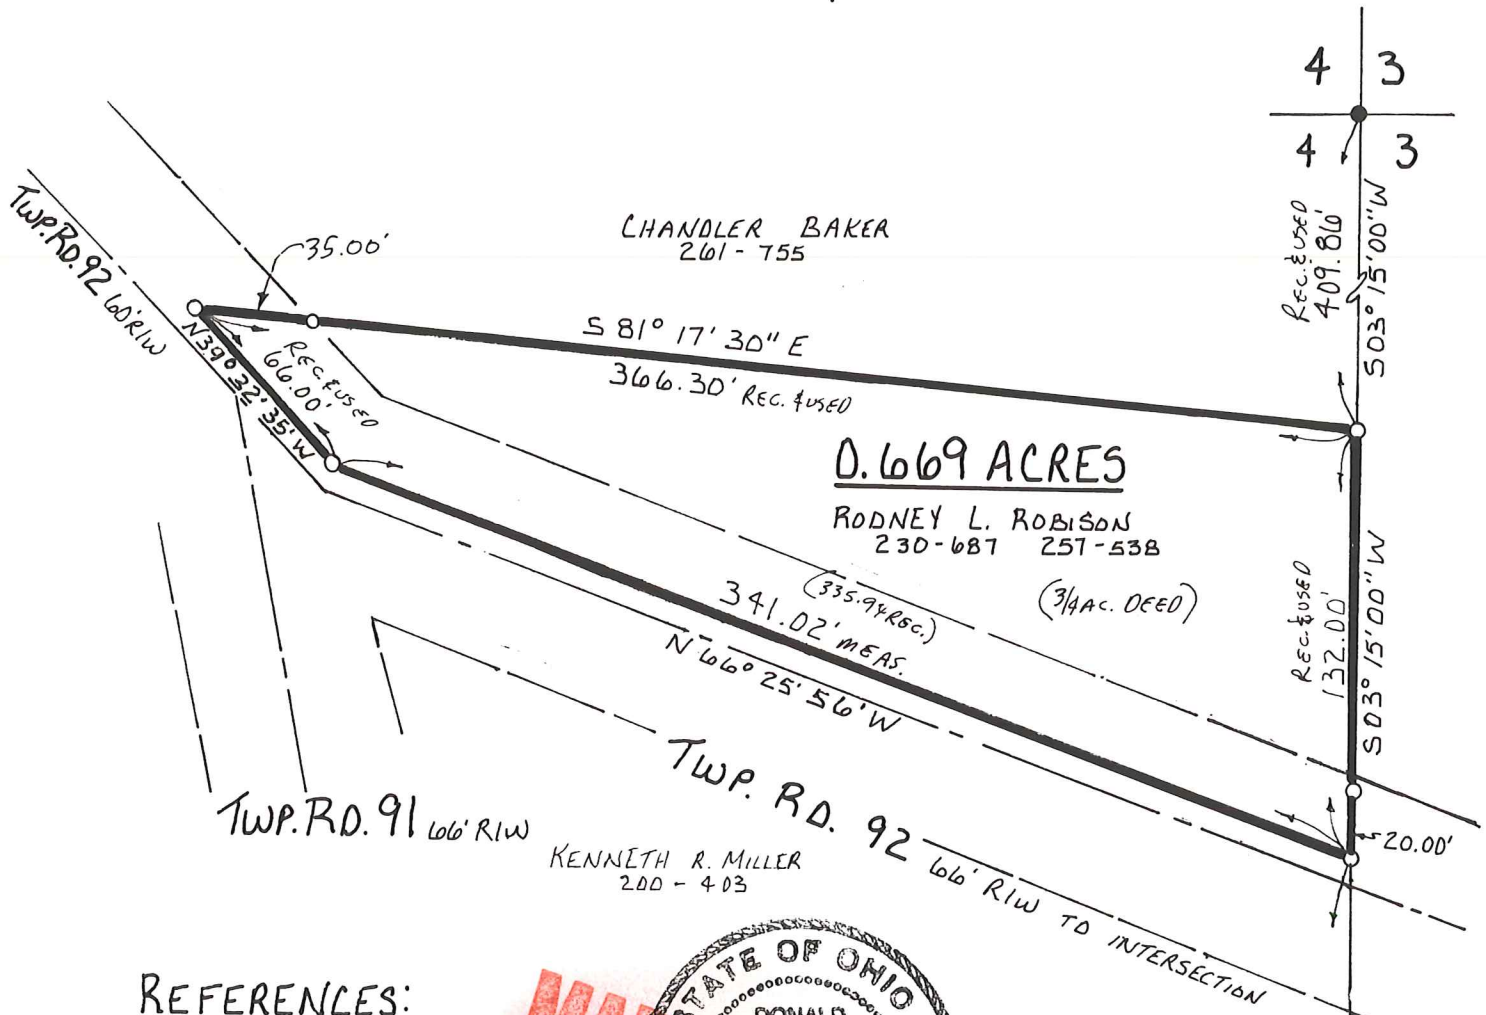


KILLBUCK TOWNSHIP
 S.E. QTR. SECTION 4
 T-8N; R-7W
 HOLMES COUNTY, OHIO


- IRON PIN FOUND
- STONE FOUND
- 5/8" REBAR WITH I.D. CAPSET
- I.D. CAP MARKED "BAKER 6938"

SURVEYED FOR RODNEY L. ROBISON

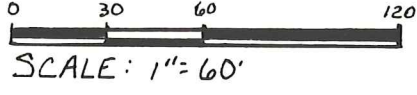

REFERENCES:

- DEED VOL. 200 PAGE 403
- DEED VOL. 230 PAGE 687
- DEED VOL. 257 PAGE 538
- DEED VOL. 261 PAGE 755
- DEED VOL. 162 PAGE 566

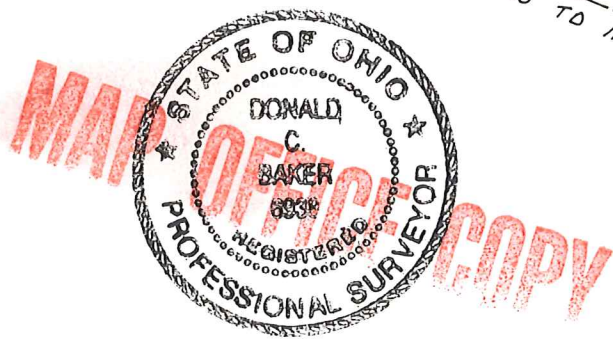

I CERTIFY THIS SURVEY TO BE CORRECT TO THE BEST OF MY KNOWLEDGE.

Donald C. Baker

DONALD C. BAKER P.S. 6938

5958 T.R. 322
 MILLERSBURG, OHIO 44654

PH: (330) 674-4788

JULY 23, 1996

43496 FJM

