


KILLBUCK TOWNSHIP N.W. & S.W. QTRS. SECTION 4 T-8N; R-7W HOLMES COUNTY, OHIO

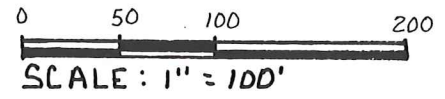


- STONE FOUND
- IRON PIN FOUND
- △ R.R. SPIKE SET
- 5/8" REBAR WITH I.D. CAP SET
- I.D. CAP MARKED "BAKER 6938"

REFERENCES:

DEED	VOL. 231	PAGE 184
::	180	7
::	177	279
::	226	246

RESURVEY OF DEED VOL. 180 PAGE 7
(PLAT VOL. 5 PAGE 131)
SURVEYED FOR WES ROBISON

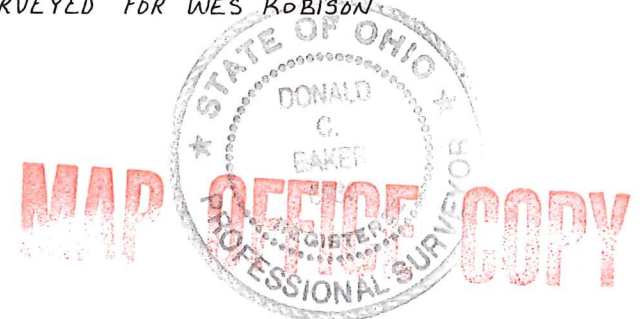


I CERTIFY THIS SURVEY TO BE CORRECT TO THE BEST OF MY KNOWLEDGE.

Donald C. Baker

DONALD C. BAKER P.S. 6938
138 N. CLAY ST
MILLERSBURG, OHIO 44654
PH: (330) 674-4788

MARCH 24, 1997

19696 FJM
F.C.C. - D.C. BAKER

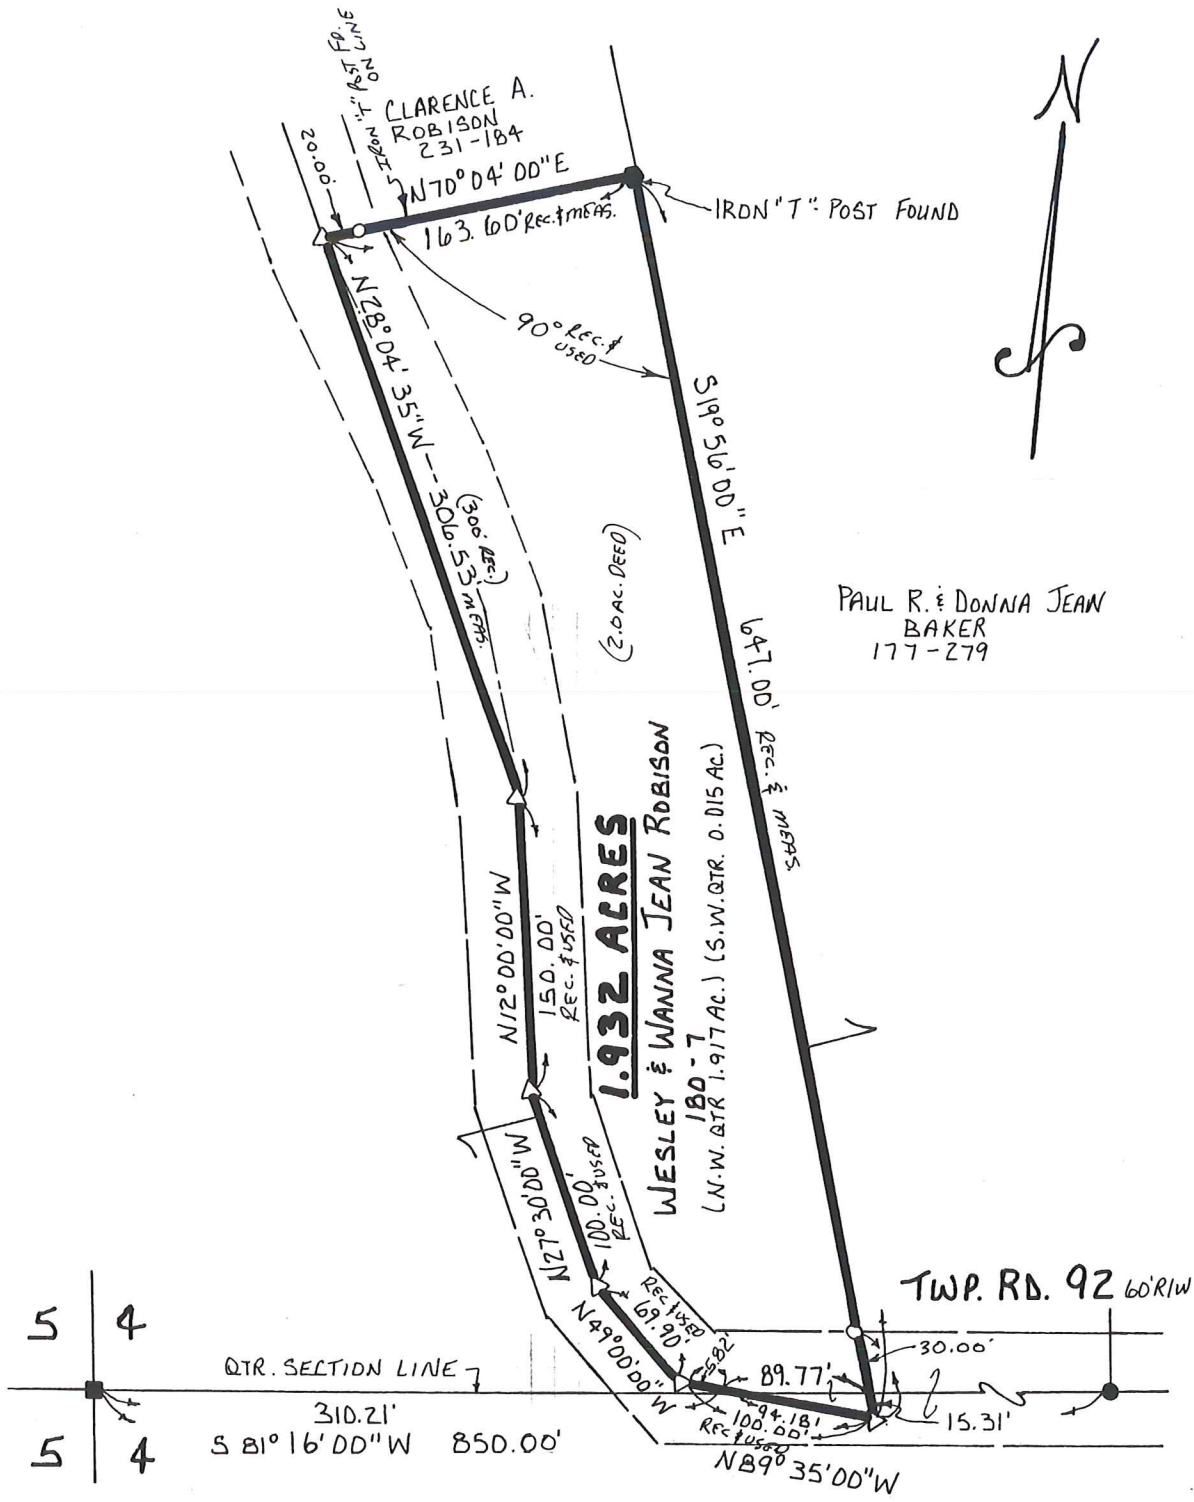

PAUL R. & DONNA JEAN
BAKER
177-279