

SURVEY AND PLAT MADE FOR ANDREW FOY


KILLBUCK TOWNSHIP

N.E. QTR. SEC. 5

T-8N R-7W

HOLMES CO., OHIO

N.W. Cor.
N.E. QTR.
Sec. 5

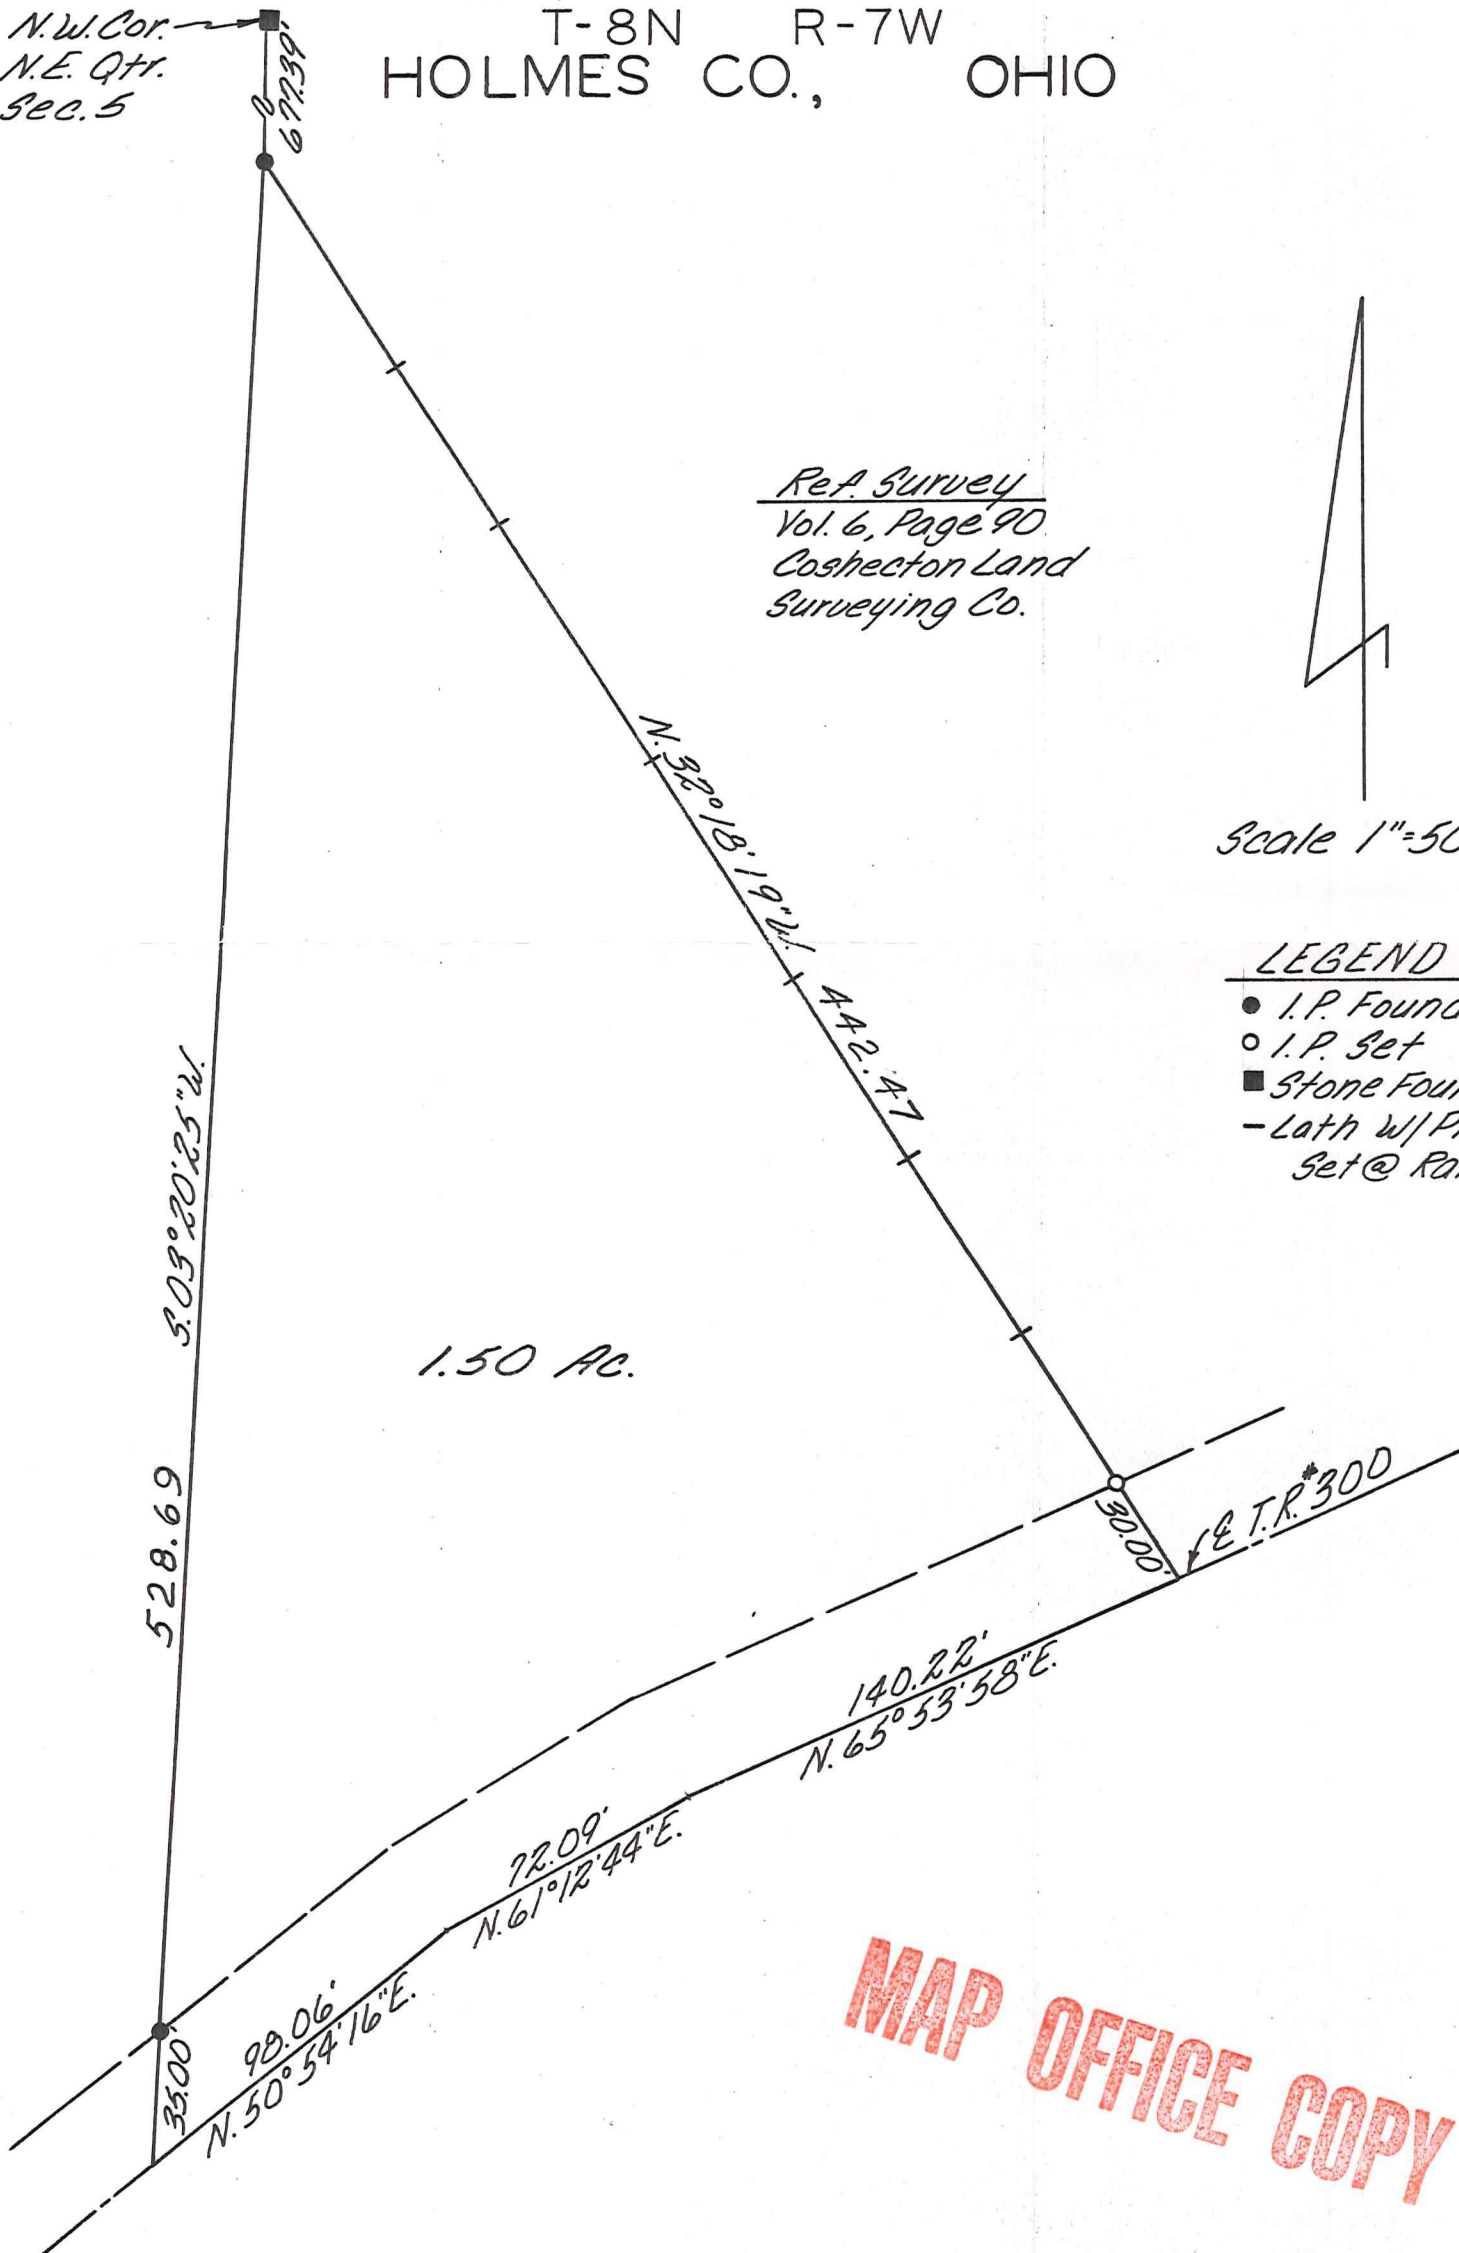

Ref. Survey
Vol. 6, Page 90
Coshecton Land
Surveying Co.



Scale 1"=50'

- LEGEND
- I.P. Found
 - I.P. Set
 - Stone Found
 - Lath w/ Pink Ribbon Set @ Random On R

1.50 AC.

MAP OFFICE COPY

SW-1827

SHAFER JOHNSTON
LICHTENWALTER & ASSOCIATES INC.
WOOSTER OHIO

I CERTIFY THIS SURVEY AND PLAT TO BE
CORRECT TO THE BEST OF MY KNOWLEDGE.
AUGUST 19 77 *Richard J. McDaid*
RICHARD J. McDAID R.S. 5009