
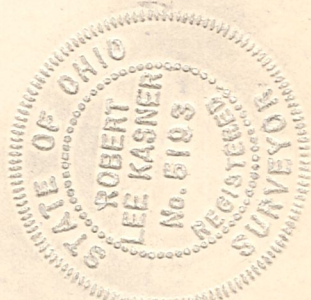


PLAT OF A SURVEY  
 FOR  
 BUCKEYE PIPELINE  
 COMPANY  
 Grantor  
 Known as part of the SW  
 1/4 S6, T8N, 4R7W of Kill-  
 buck Twp., Hol. Co. Ohio.  
 Robert L. Kasner P.S. 5193

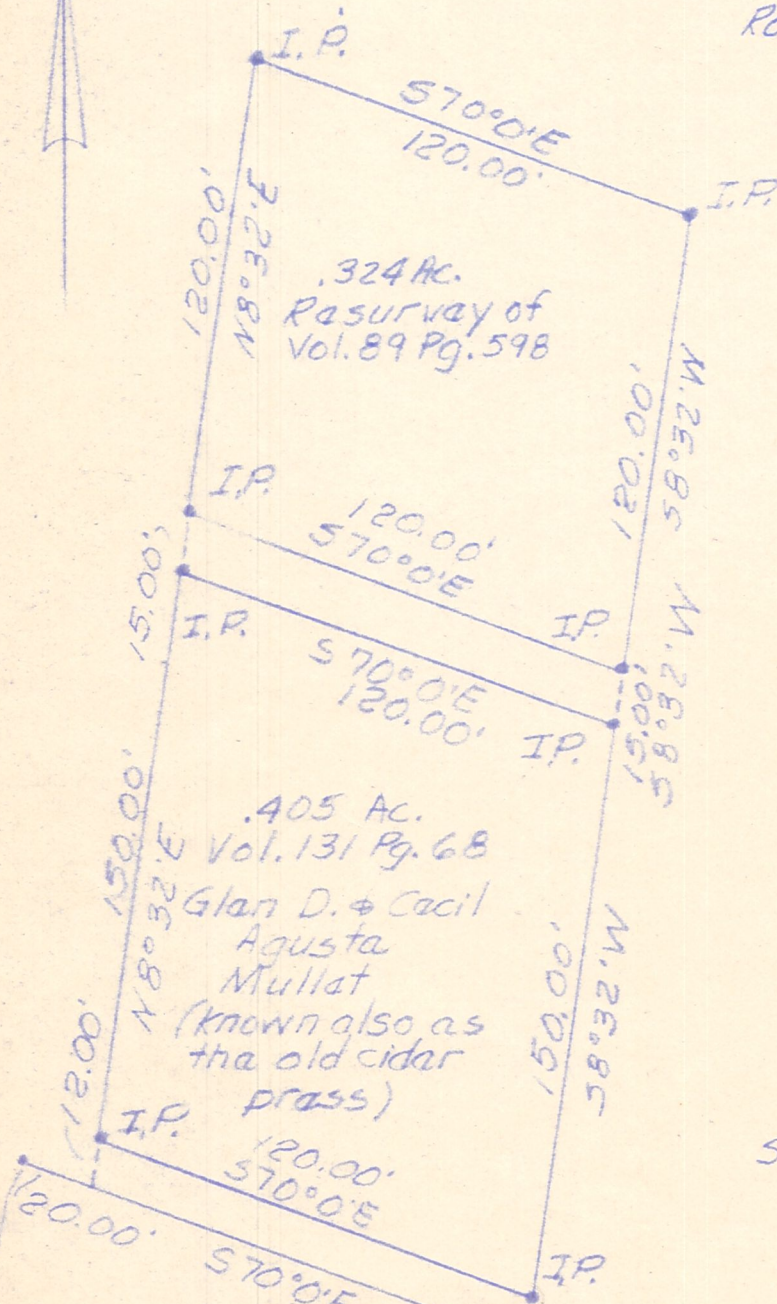

Scale: 1" = 50'

R.S. on corporation  
 line, East line of  
 Drasden Branch of  
 C.A. & C. R.R. and between  
 J.C. & W. Duncan and  
 James E. Duncan, set in 1965.  
 Above brgs. do not agree with dead brgs.

**MAP OFFICE COPY**