

KILLBUCK TOWNSHIP
 S.E. QTR. SECTION 7
 T-8 N R-7 W
 HOLMES COUNTY, OHIO



SCALE: 1" = 100'


- STONE FOUND
- IRON PIN FOUND
- 5/8" RE BAR WITH I.D. CAP SET
I.D. CAP MARKED "BAKER 6938"

(SURVEYED FOR HANK RABER)

REFERENCES:

DEED VOL. 234 PAGE 792
 " " 226 " 808
 " " 204 " 391

PLAT VOL. 8 PAGE 612

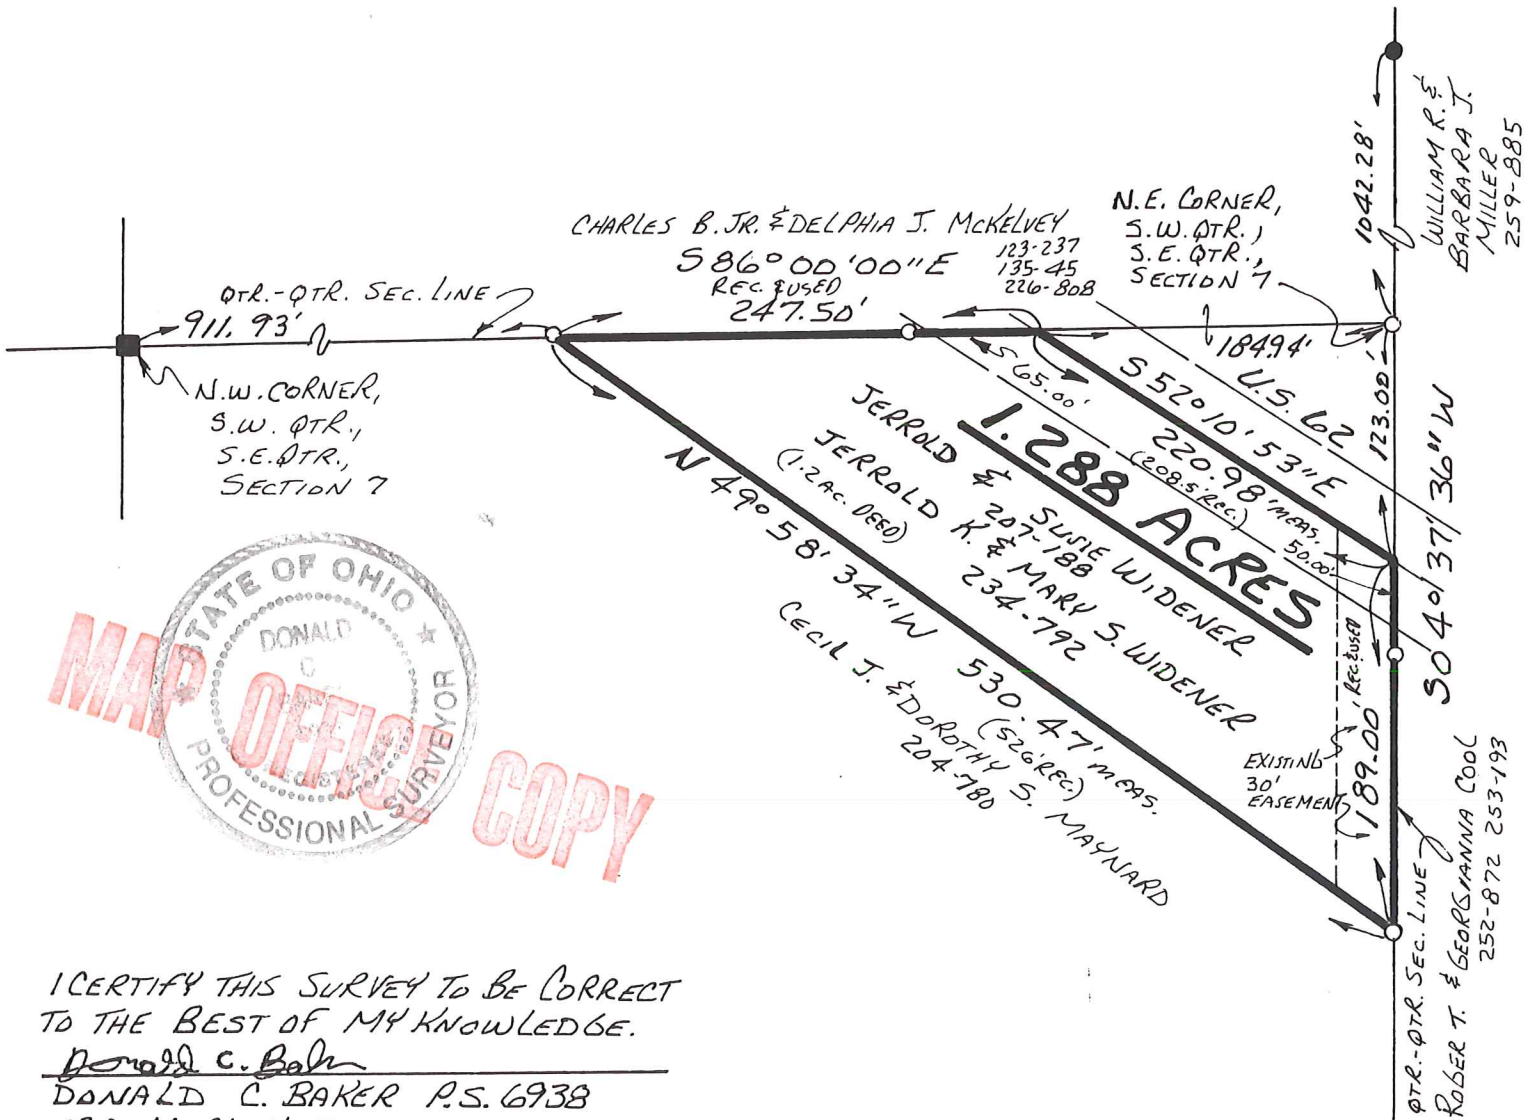

I CERTIFY THIS SURVEY TO BE CORRECT
 TO THE BEST OF MY KNOWLEDGE.

Donald C. Baker
 DONALD C. BAKER P.S. 6938
 138 N. CLAY ST.
 MILLERSBURG, OHIO 44654
 PH. (330) 674-4788
 MAY 13, 1997

#23297 - M.L. DAVIS
 F.C.C. - F.D. BAKER