


- STONE FOUND
- IRON PIN FOUND
- 5/8" RE BAR WITH I.D. CAP SET
I.D. CAP MARKED "BAKER 6938"



KILLBUCK TOWNSHIP
 N.E. QTR. SECTION 13
 T-8N; R-7W
 HOLMES COUNTY, OHIO

REFERENCES:
 DEED VOL. 153 PAGE 41
 DEED VOL. 172 PAGE 543
 DEED VOL. 143 PAGE 527
 PLAT VOL. 3 PAGE 8B
 PLAT VOL. 10 PAGE 399

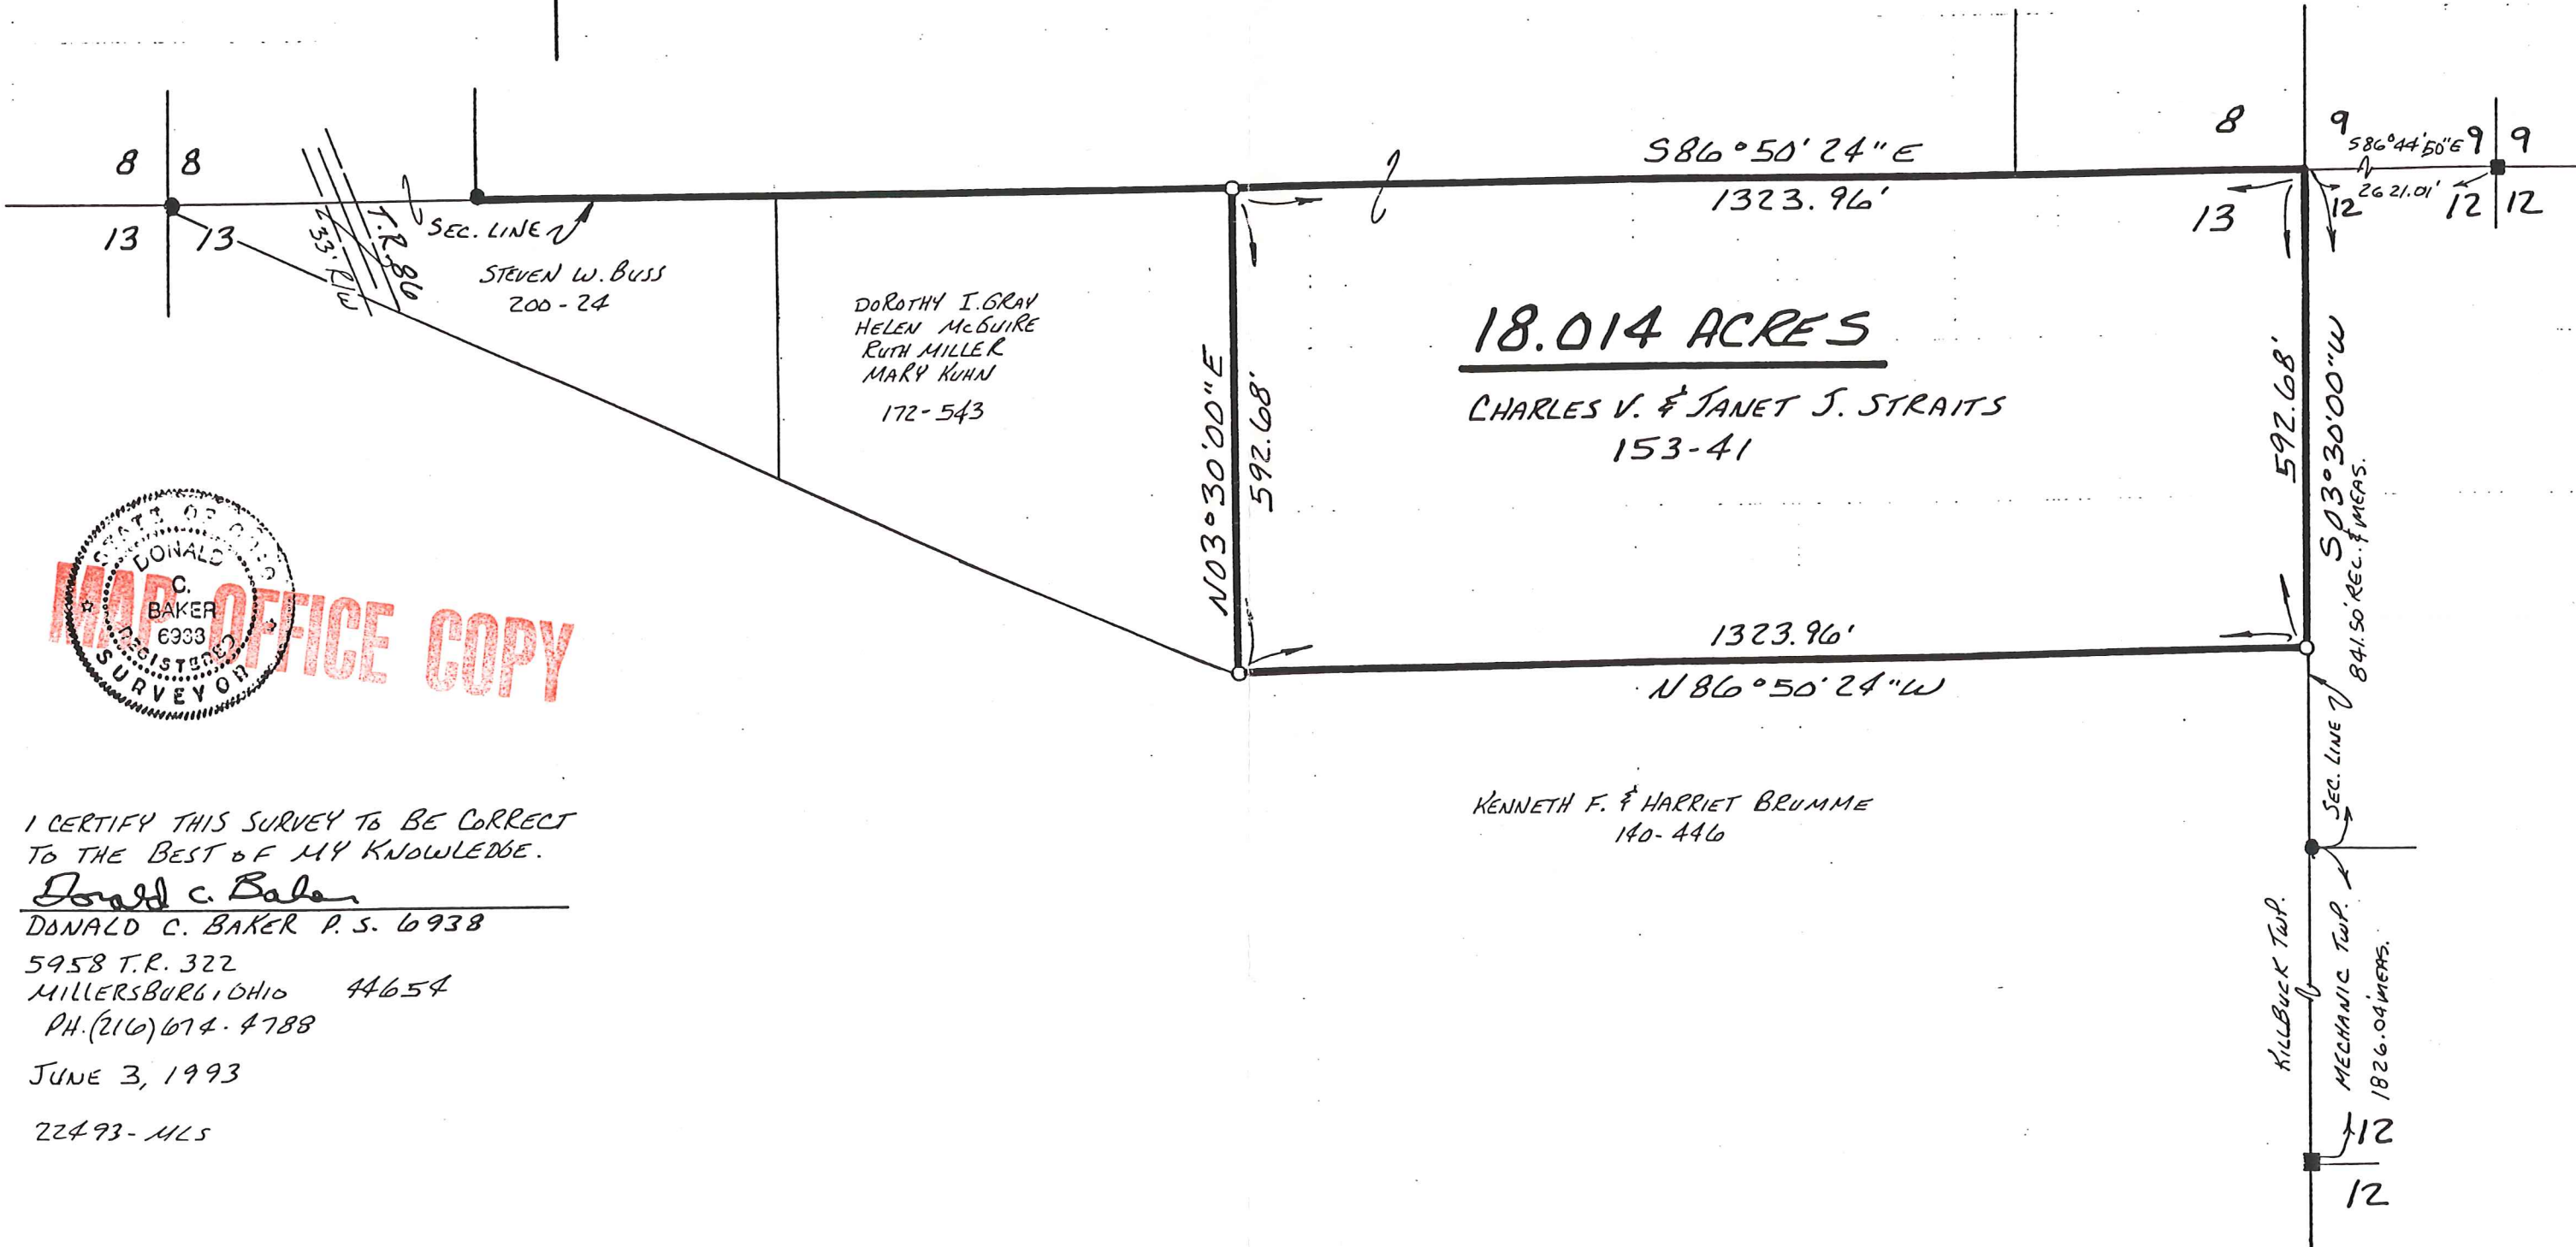

I CERTIFY THIS SURVEY TO BE CORRECT
 TO THE BEST OF MY KNOWLEDGE.

Donald C. Baker

DONALD C. BAKER P. S. 6938

5958 T.R. 322
 MILLERSBURG, OHIO 44654
 PH. (216) 674-4788

JUNE 3, 1993

22493-MLS

KENNETH F. & HARRIET BRUMME
 140-446