

KILLBUCK TOWNSHIP
 N.W. QTR. SECTION 15
 T-8 N; R-7 W
 HOLMES COUNTY, OHIO

SURVEYED FOR: ROD STARR




SCALE: 1"=40'

- 5/8" REBAR FOUND
UNLESS OTHERWISE NOTED
- 5/8" REBAR SET WITH I.D. CAP
I.D. CAP MARKED "BAKER
SURVEYING LLC"

REFERENCES

- DEED VOL. 275 PAGE 5
- O.R. VOL. 260 PAGE 3201
- O.R. VOL. 178 PAGE 294
- O.R. VOL. 259 PAGE 6259
- O.R. VOL. 259 PAGE 3747
- PLAT VOL. 10 PAGE 209
- PLAT VOL. 12 PAGE 280
- PLAT VOL. 16 PAGE 296
- PLAT VOL. 16 PAGE 657
- PLAT VOL. 18 PAGE 550

BASIS OF BEARINGS FROM
 OHIO STATE PLANE COORDINATE
 SYSTEM, NORTH ZONE, N.A.D. 83

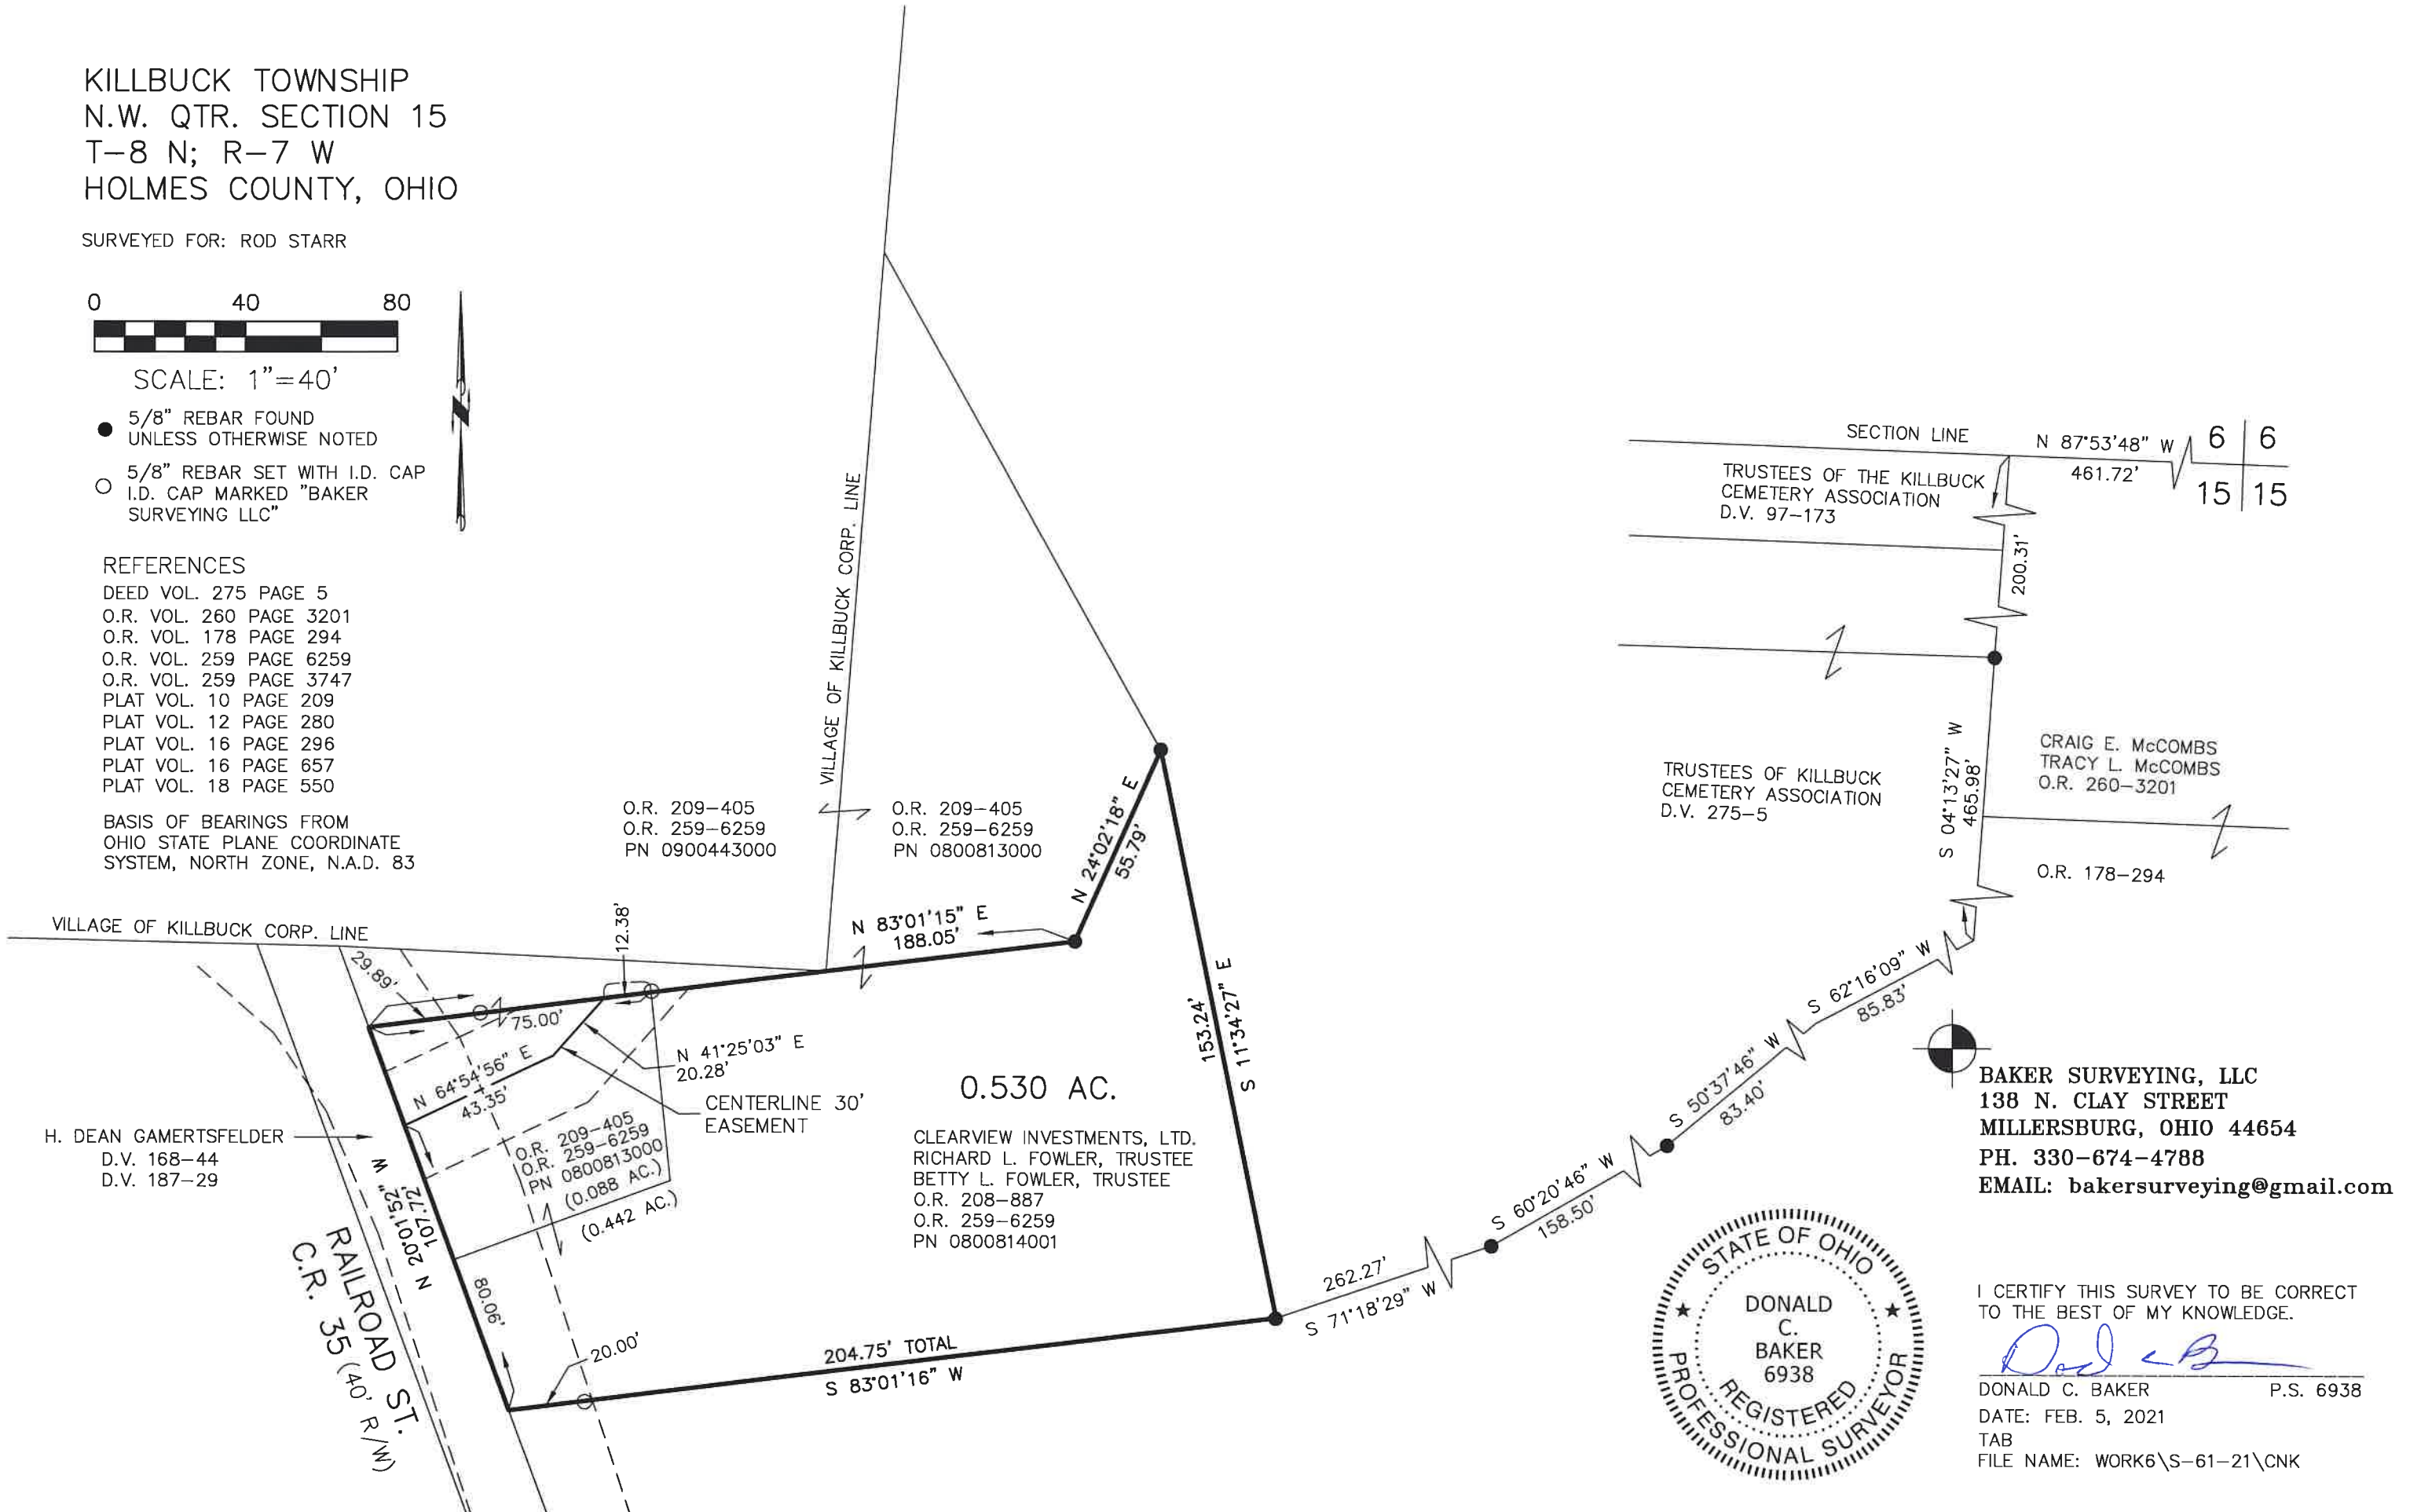

BAKER SURVEYING, LLC
 138 N. CLAY STREET
 MILLERSBURG, OHIO 44654
 PH. 330-674-4788
 EMAIL: bakersurveying@gmail.com



I CERTIFY THIS SURVEY TO BE CORRECT
 TO THE BEST OF MY KNOWLEDGE.

Donald C. Baker
 DONALD C. BAKER P.S. 6938
 DATE: FEB. 5, 2021
 TAB
 FILE NAME: WORK6\S-61-21\CNK