


PROPERTY LINE SURVEY

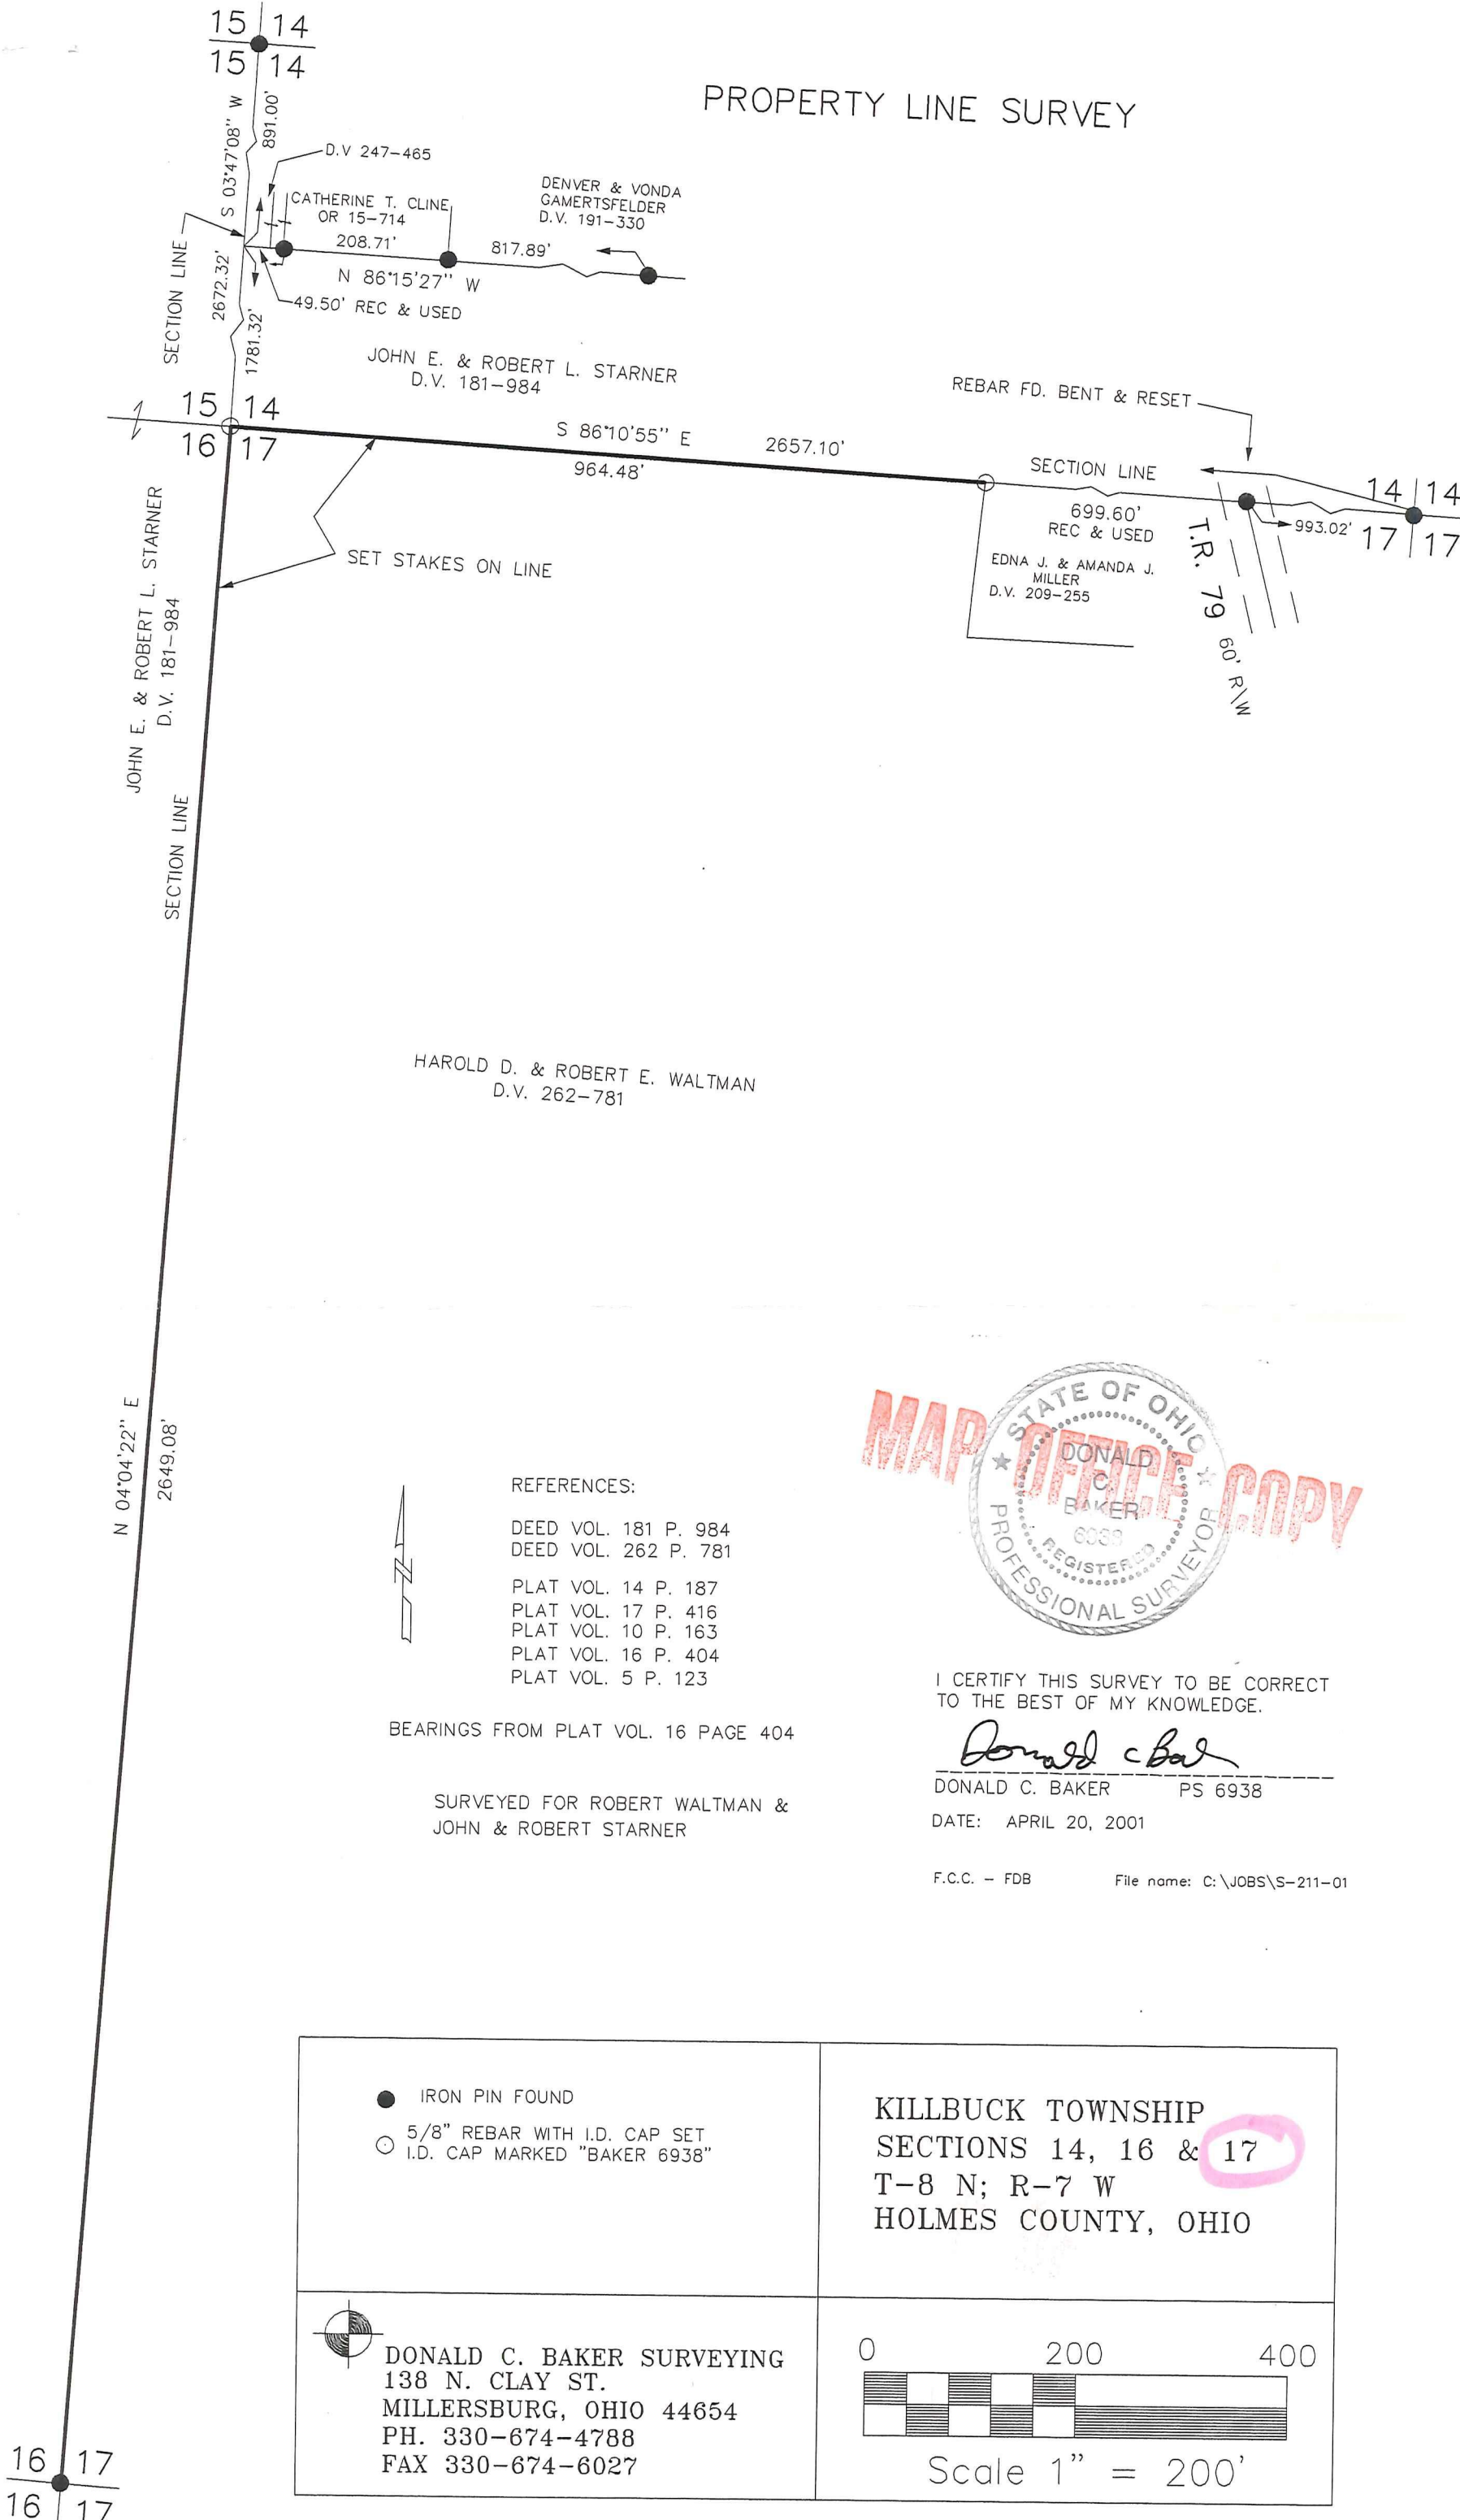

HAROLD D. & ROBERT E. WALTMAN
D.V. 262-781

REFERENCES:

- DEED VOL. 181 P. 984
- DEED VOL. 262 P. 781
- PLAT VOL. 14 P. 187
- PLAT VOL. 17 P. 416
- PLAT VOL. 10 P. 163
- PLAT VOL. 16 P. 404
- PLAT VOL. 5 P. 123

BEARINGS FROM PLAT VOL. 16 PAGE 404

SURVEYED FOR ROBERT WALTMAN &
JOHN & ROBERT STARNER



I CERTIFY THIS SURVEY TO BE CORRECT
TO THE BEST OF MY KNOWLEDGE.

Donald C Baker

DONALD C. BAKER PS 6938

DATE: APRIL 20, 2001

F.C.C. - FDB File name: C:\JOBS\S-211-01

<ul style="list-style-type: none"> ● IRON PIN FOUND ○ 5/8" REBAR WITH I.D. CAP SET I.D. CAP MARKED "BAKER 6938" 	<p>KILLBUCK TOWNSHIP SECTIONS 14, 16 & 17 T-8 N; R-7 W HOLMES COUNTY, OHIO</p>
<p> DONALD C. BAKER SURVEYING 138 N. CLAY ST. MILLERSBURG, OHIO 44654 PH. 330-674-4788 FAX 330-674-6027 </p>	<p>0 200 400</p> <p>Scale 1" = 200'</p>

16 | 17
16 | 17