


- ▲ R.R. SPIKE FOUND
- IRON PIN FOUND
- △ R.R. SPIKE SET
- 5/8" REBAR WITH I.D. CAP SET
- I.D. CAP MARKED "BAKER 6938"
- P.K. NAIL FOUND


REFERENCES:

DEED VOL. 176 PAGE 110
 DEED VOL. 187 PAGE 648
 BEARINGS FROM PLAT VOL. 5
 PAGE 84

KILLBUCK TOWNSHIP
 N.E. QTR. SECTION 1
 T-8N R-8W
 HOLMES COUNTY, OHIO

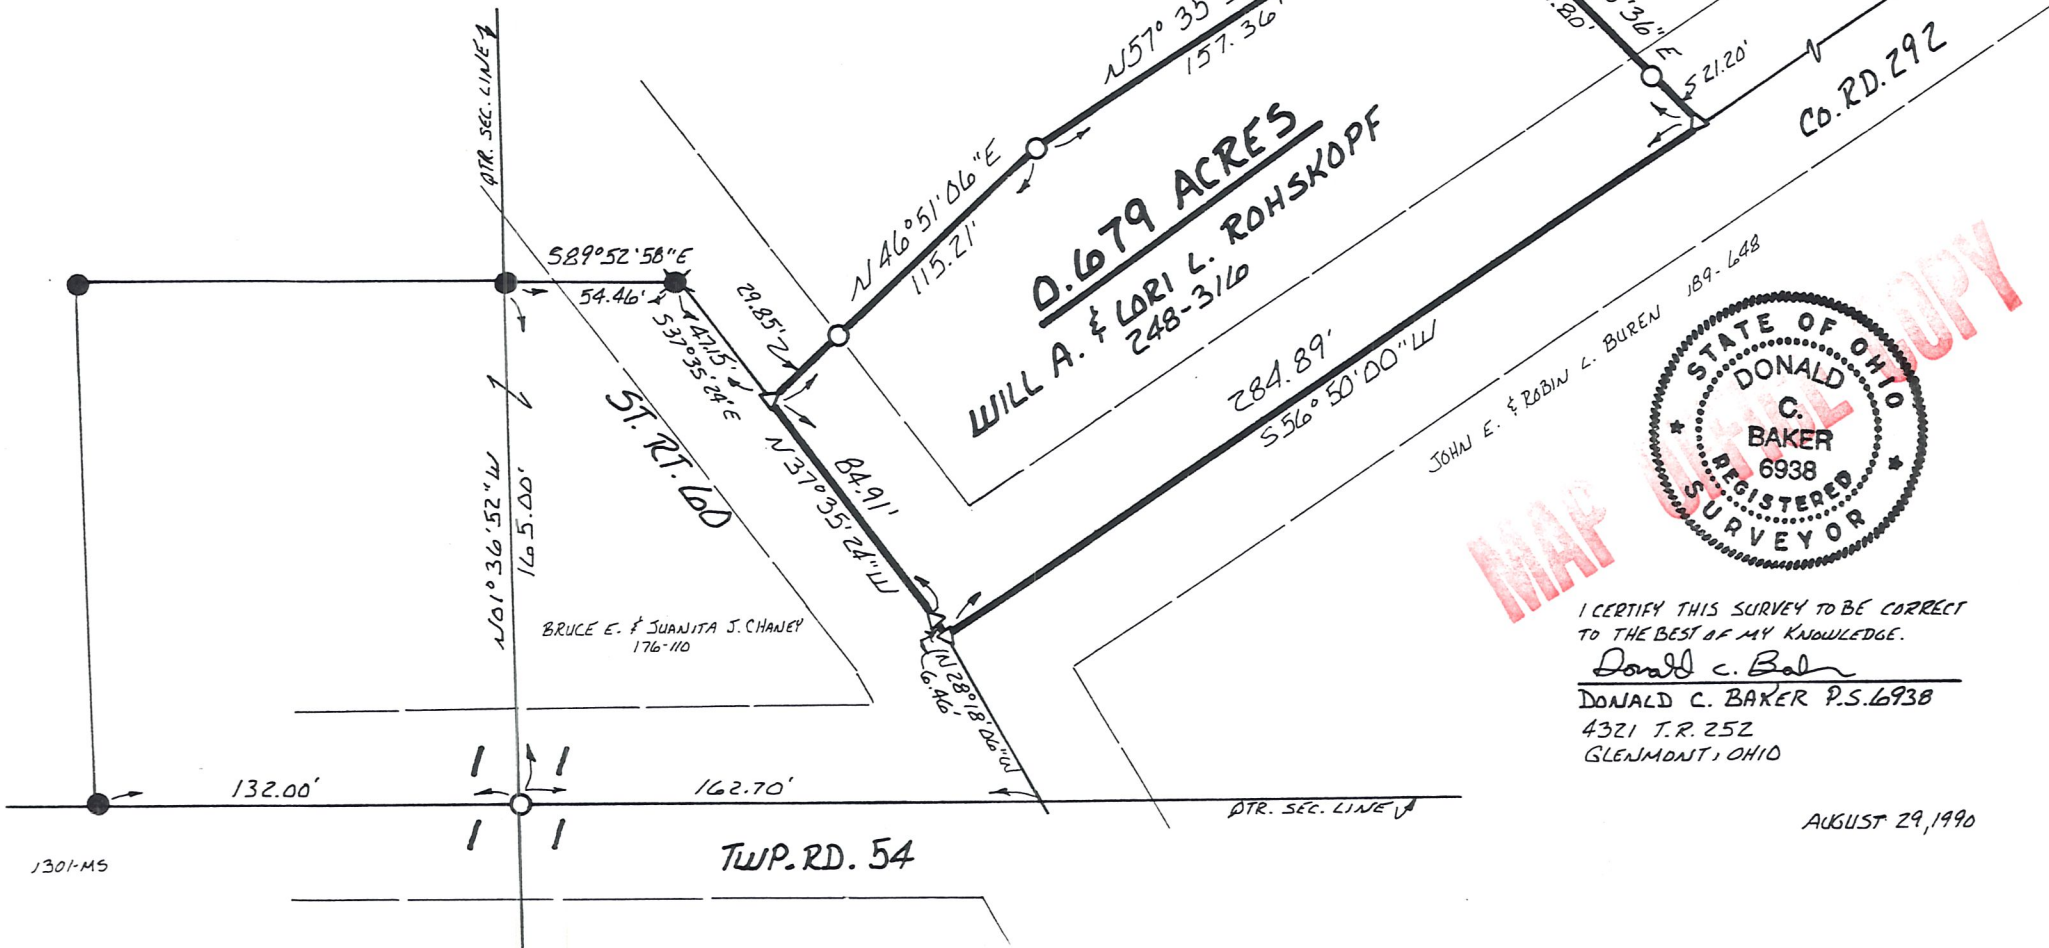

0.679 ACRES
WILL A. & LORI L. ROHSKOPF
 248-316

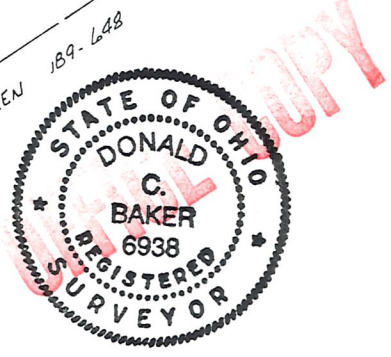

I CERTIFY THIS SURVEY TO BE CORRECT
 TO THE BEST OF MY KNOWLEDGE.
Donald C. Baker
 DONALD C. BAKER P.S. 6938
 4321 T.R. 252
 GLENMONT, OHIO

AUGUST 29, 1990