



4TH QTR.
LOT 23

4TH QTR.
LOT 22
MONROE TWP.

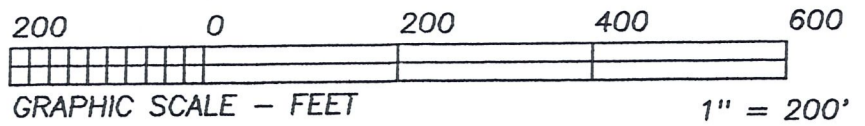

BEARINGS ESTABLISHED
FROM SURVEY 16/997
& ARE TO DENOTE
ANGULAR MEAS. ONLY.

REFERENCE DOCUMENTS:
TAX MAPS
DEEDS AS SHOWN
SURVEY PLATS:
16/997

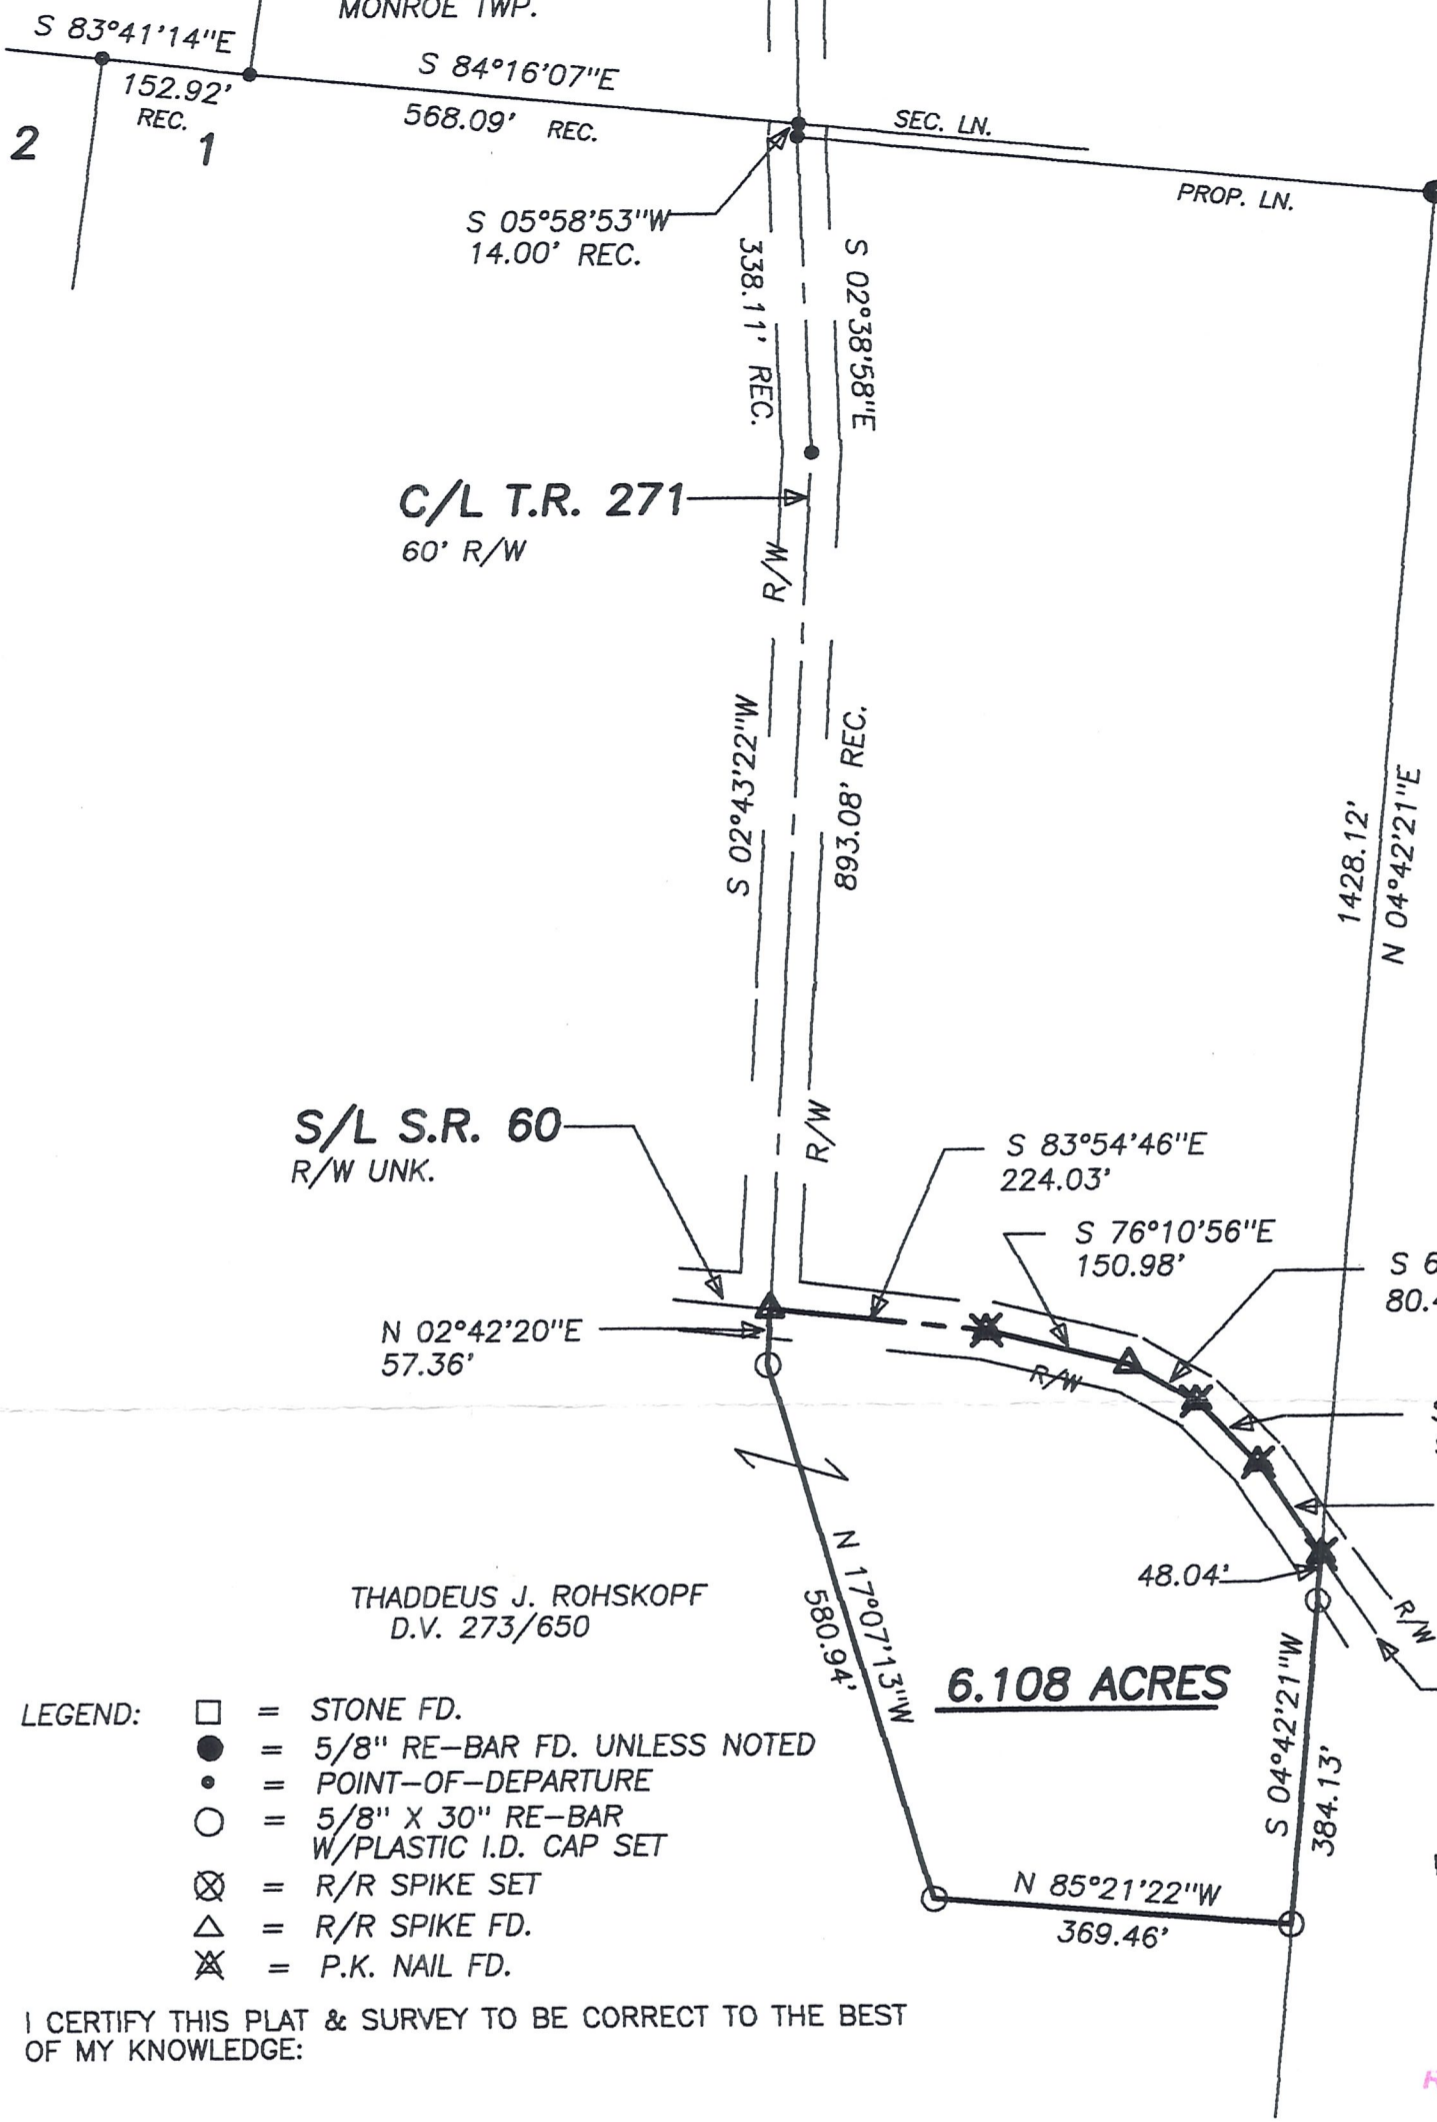

- LEGEND:
- = STONE FD.
 - = 5/8" RE-BAR FD. UNLESS NOTED
 - = POINT-OF-DEPARTURE
 - = 5/8" X 30" RE-BAR W/PLASTIC I.D. CAP SET
 - ⊗ = R/R SPIKE SET
 - △ = R/R SPIKE FD.
 - ⊠ = P.K. NAIL FD.

I CERTIFY THIS PLAT & SURVEY TO BE CORRECT TO THE BEST OF MY KNOWLEDGE:

J. Shamp

APRIL 4, 2000

JIM SHAMP, REG. SUR. NO. S-6088

DATE

RECEIVED
APR 26 2000
Hol. Co. Tax Map Office

HEARTLAND SURVEYING, INC

Jim Shamp

5210 T.R. 257

MILLERSBURG, OH 44654

PH: 330-674-4698

SURVEY		THADDEUS J. ROHSKOPF		STATE		OHIO	
COUNTY	TWP.	RNG.	TWP.				
HOLMES	KILLBUCK	8 W	8 N				
NORTHWEST QUARTER OF SECTION 1				000402			

