


RUBY M. FISHINGER & PATTY L. SNYDER
200-771 208-6089

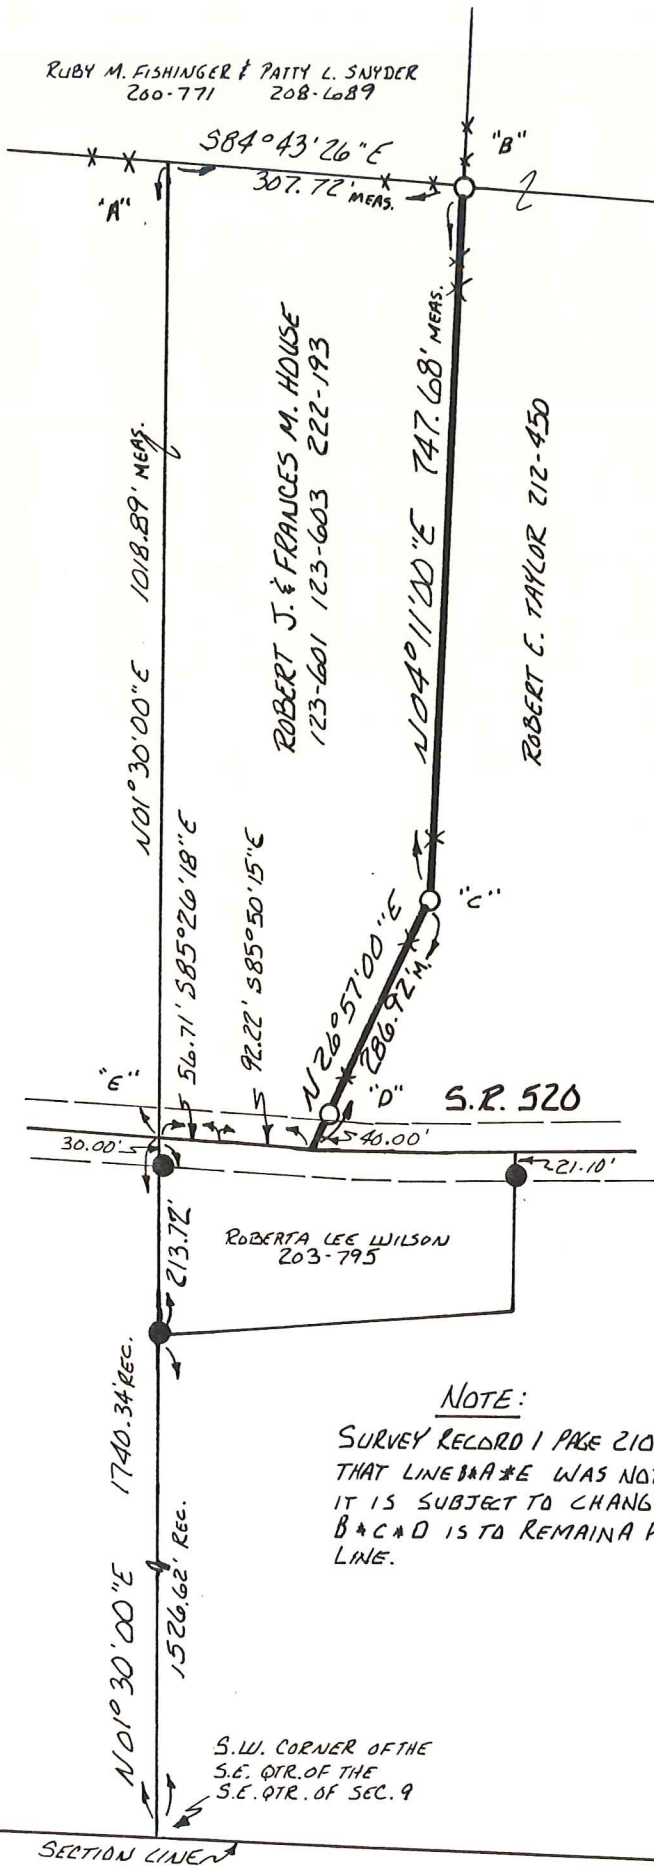

ROBERT J. & FRANCES M. HOUSE
123-601 123-603 222-193


ROBERT E. TAYLOR 212-450

ROBERTA LEE WILSON
203-795

NOTE:
SURVEY RECORD 1 PAGE 210 STATES
THAT LINE B*A*E WAS NOT ESTABLISHED,
IT IS SUBJECT TO CHANGE, AND LINE
B*C*D IS TO REMAIN A PERMANENT
LINE.

S.W. CORNER OF THE
S.E. QTR. OF THE
S.E. QTR. OF SEC. 9

KILLBUCK TOWNSHIP
S.E. QTR. SECTION 9
T-8N R-8W
HOLMES COUNTY, OHIO

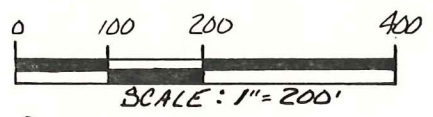

- IRON PIN FOUND
- 5/8" REBAR WITH I.D. CAP SET
I.D. CAP MARKED "BAKER 6938"

REFERENCES:

- DEED VOL. 212 PAGE 450
- DEED VOL. 203 PAGE 795
- DEED VOL. 123 PAGES 601 & 603
- DEED VOL. 222 PAGE 193
- SURVEY RECORD 3 PAGE 15
- BEARINGS FROM PLAT VOL. 8 PAGE 32B

MAP OF OHIO COPY



I CERTIFY THIS SURVEY TO BE CORRECT
TO THE BEST OF MY KNOWLEDGE.

Donald C. Baker
DONALD C. BAKER P.S. 6938
4301 T.R. 252
GLENMONT, OHIO 44628

9	10
12	11

SEPT. 19, 1990