


THE COSHOCTON LAND SURVEYING SERVICE

233 S. FOURTH ST.

COSHOCTON, OHIO 43812

BEING PART OF: LOT ~
 SEC. 9 + 10
 QUAR. 1ST
 T8 N, R8 W, U.S.M.L.
 TOWNSHIP KILLBUCK
 COUNTY HOLMES


SURVEY FOR: Lynn Cline
 DATE: Sept. 1974
 SCALE: 1" = 50'

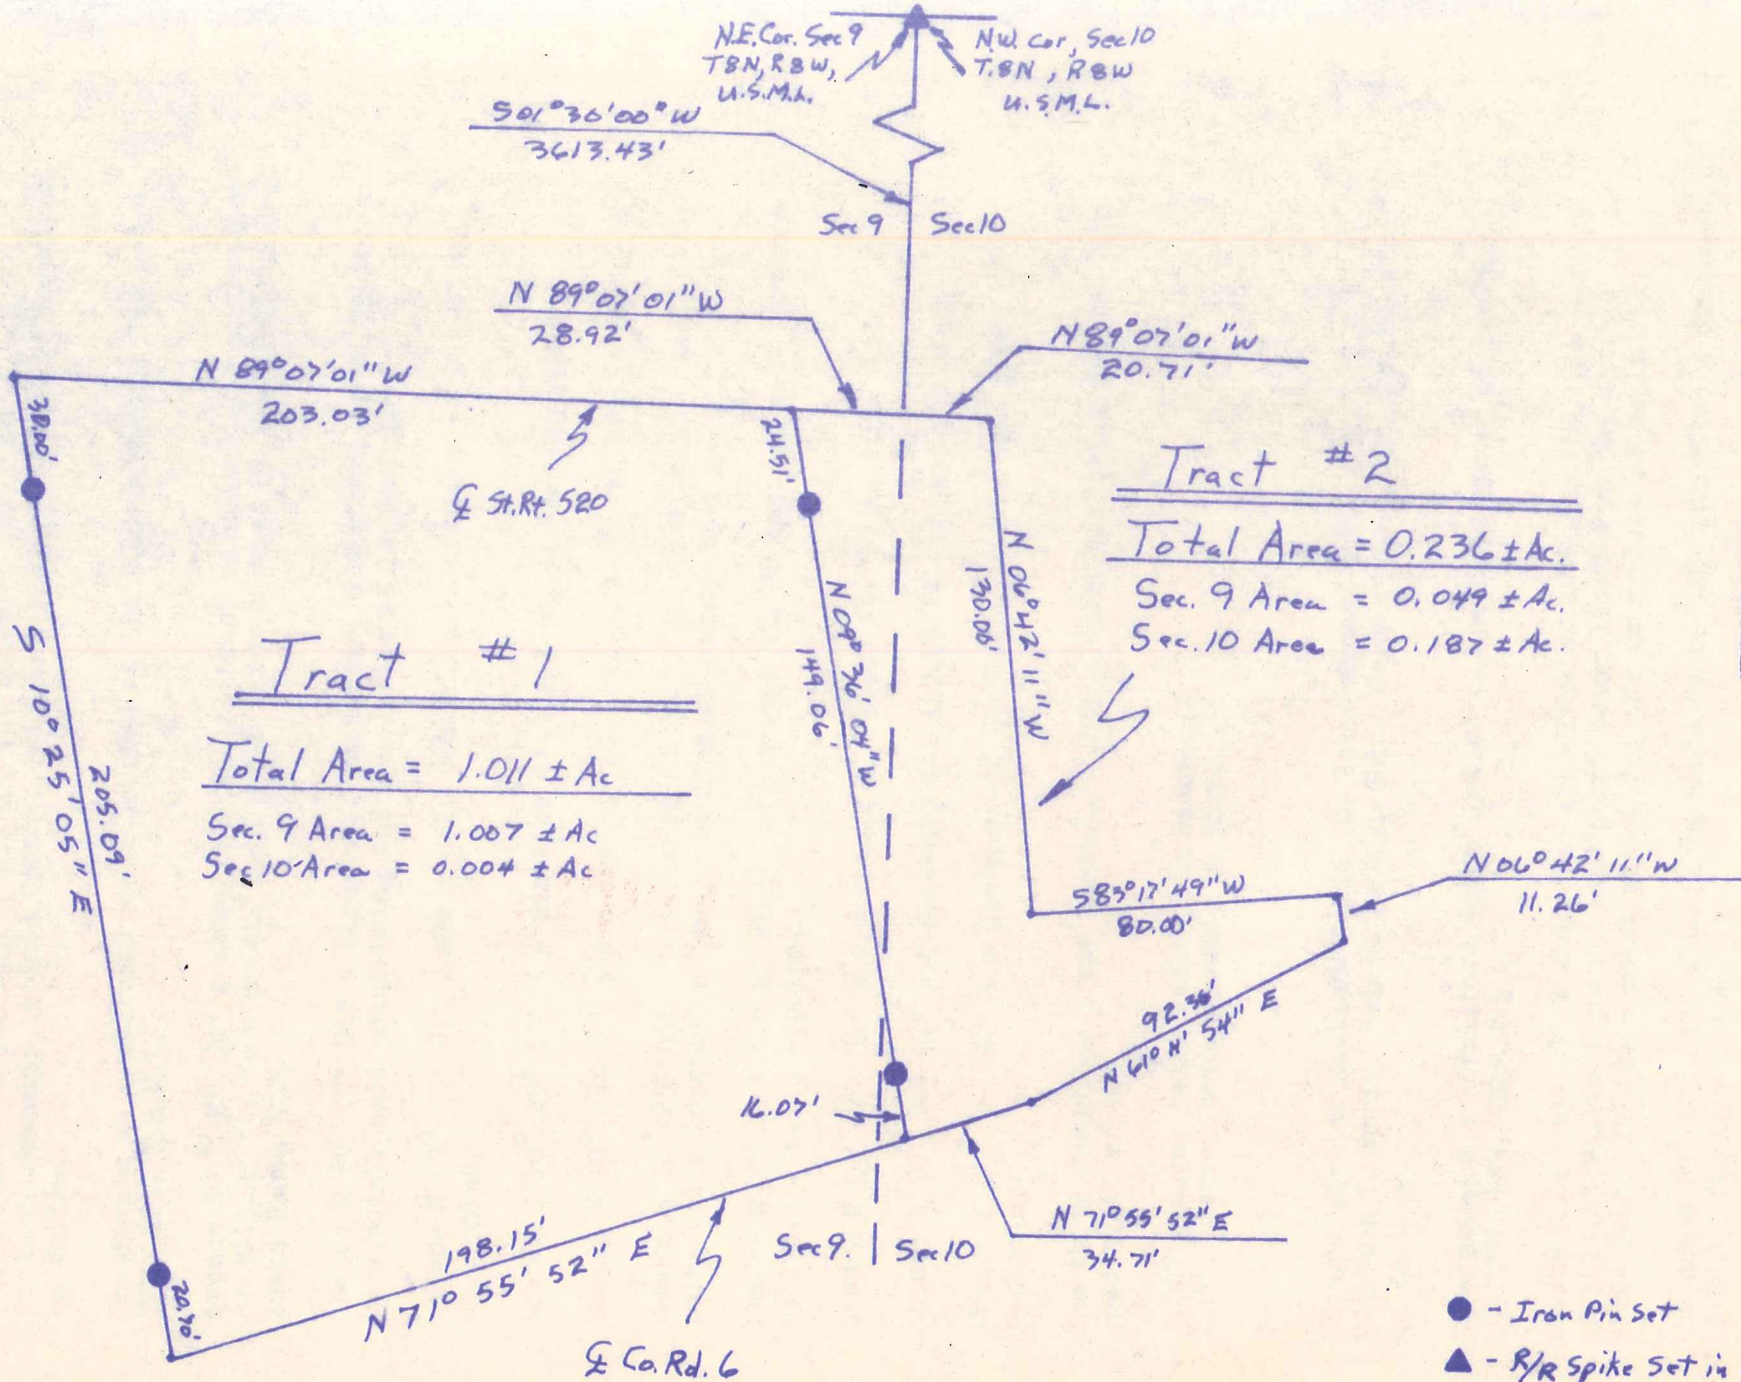

I hereby certify the above plat to be correct to the best of my knowledge and belief.

THE COSHOCTON LAND SURVEYING SERVICE

MAP OFFICE COPY

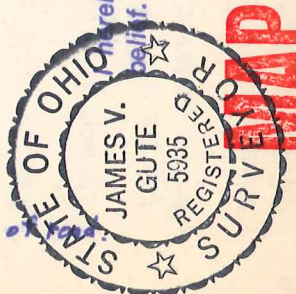

James V. Gute
 REGISTERED SURVEYOR - 5935

- - Iron Pin Set
- ▲ - R/R Spike Set in E of Sec 9