

# HEARTLAND SURVEYING, INC

Jim Shamp  
 5210 T.R. 257 MILLERSBURG, OH 44654  
 PH: 330-674-4698




BEARINGS ARE TO AN ASSUMED MERIDIAN AND ARE USED TO DENOTE ANGULAR MEAS. ONLY.

- LEGEND:
- = STONE FD.
  - = 5/8" RE-BAR FD. UNLESS NOTED
  - = POINT-OF-DEPARTURE
  - = 5/8" X 30" RE-BAR W/PLASTIC I.D. CAP SET
  - ⊗ = R/R SPIKE SET
  - △ = R/R SPIKE FD.
  - \* = 1" PIPE FD.

REFERENCE DOCUMENTS:  
 TAX MAPS  
 DEEDS AS SHOWN  
 SURVEY PLATS: 3/63

|                            |          |             |      |
|----------------------------|----------|-------------|------|
| SURVEY                     |          | STATE       |      |
| CATHERINE T. CLINE         |          | OHIO        |      |
| COUNTY                     | TWP.     | RNG.        | TWP. |
| HOLMES                     | KILLBUCK | 8 W         | 8 N  |
| S.W. QUARTER OF SECTION 10 |          | 4/98 980510 |      |

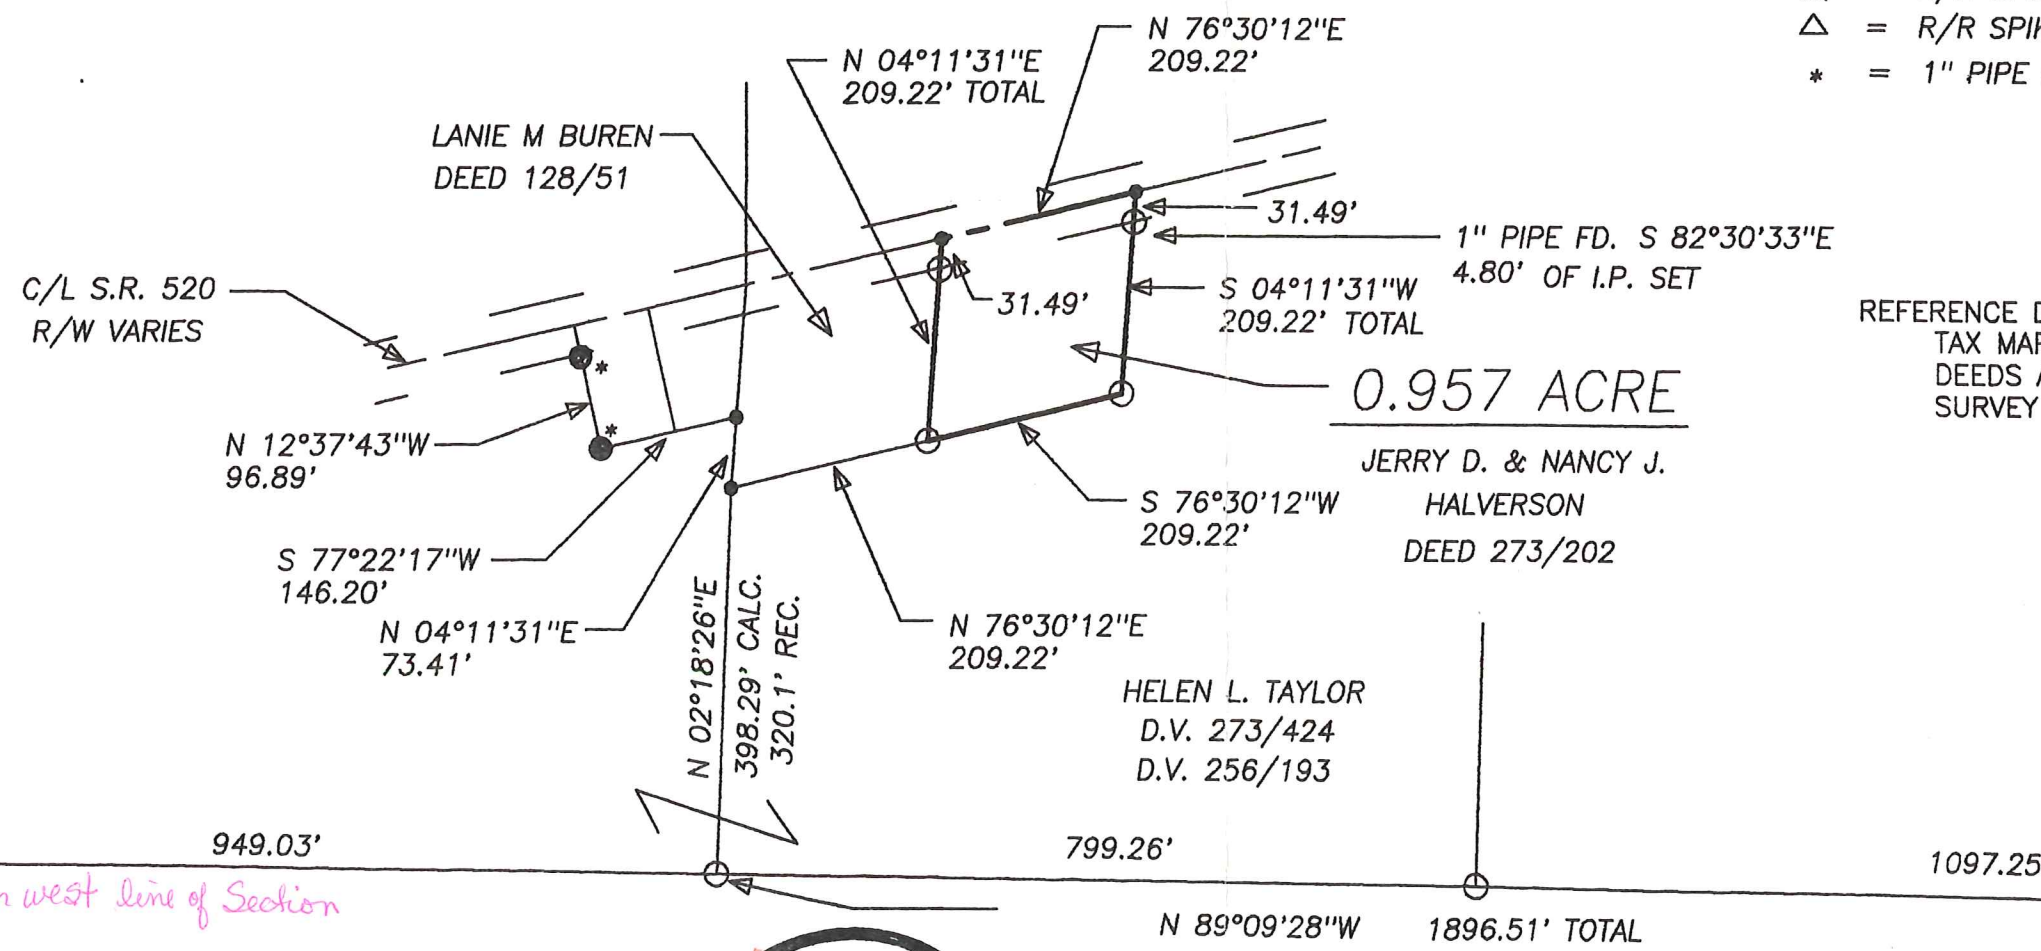

*Resurvey of 273-202  
 1.0 res to .957*

*this should be  
 SE cor NESW*

I CERTIFY THIS PLAT & SURVEY TO BE CORRECT TO THE BEST OF MY KNOWLEDGE:

*[Signature]*


MAY 29, 1998

JIM SHAMP, REG. SUR. NO. S-6088


DATE



**OFFICE COPY**

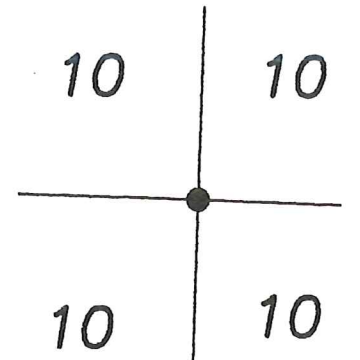

S 01°30'00"W  
 1346.40'

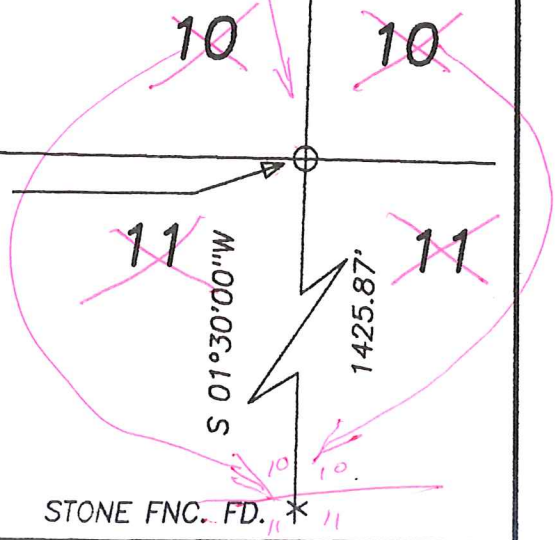

STONE FNC. FD. \*