


REFERENCES:



DEED VOL. 262 PAGE 886
 " " 232 " 842
 " " 232 " 839

BEARINGS FROM PLAT VOL. 14 PAGE 399

KILLBUCK TOWNSHIP
 S.E. QTR. SECTION 12
 N.E. QTR. SECTION 19
 T-8N; R-8W
 HOLMES COUNTY, OHIO
 (SURVEYED FOR: DAVE MASTERS)

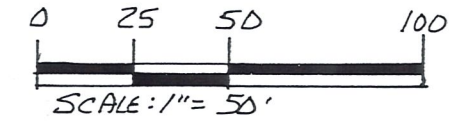

- IRON PIN FOUND
- 5/8" REBAR WITH I.D. CAP SET I.D. CAP MARKED "BAKER693B"

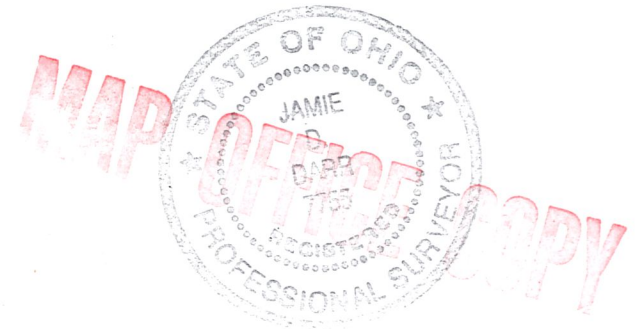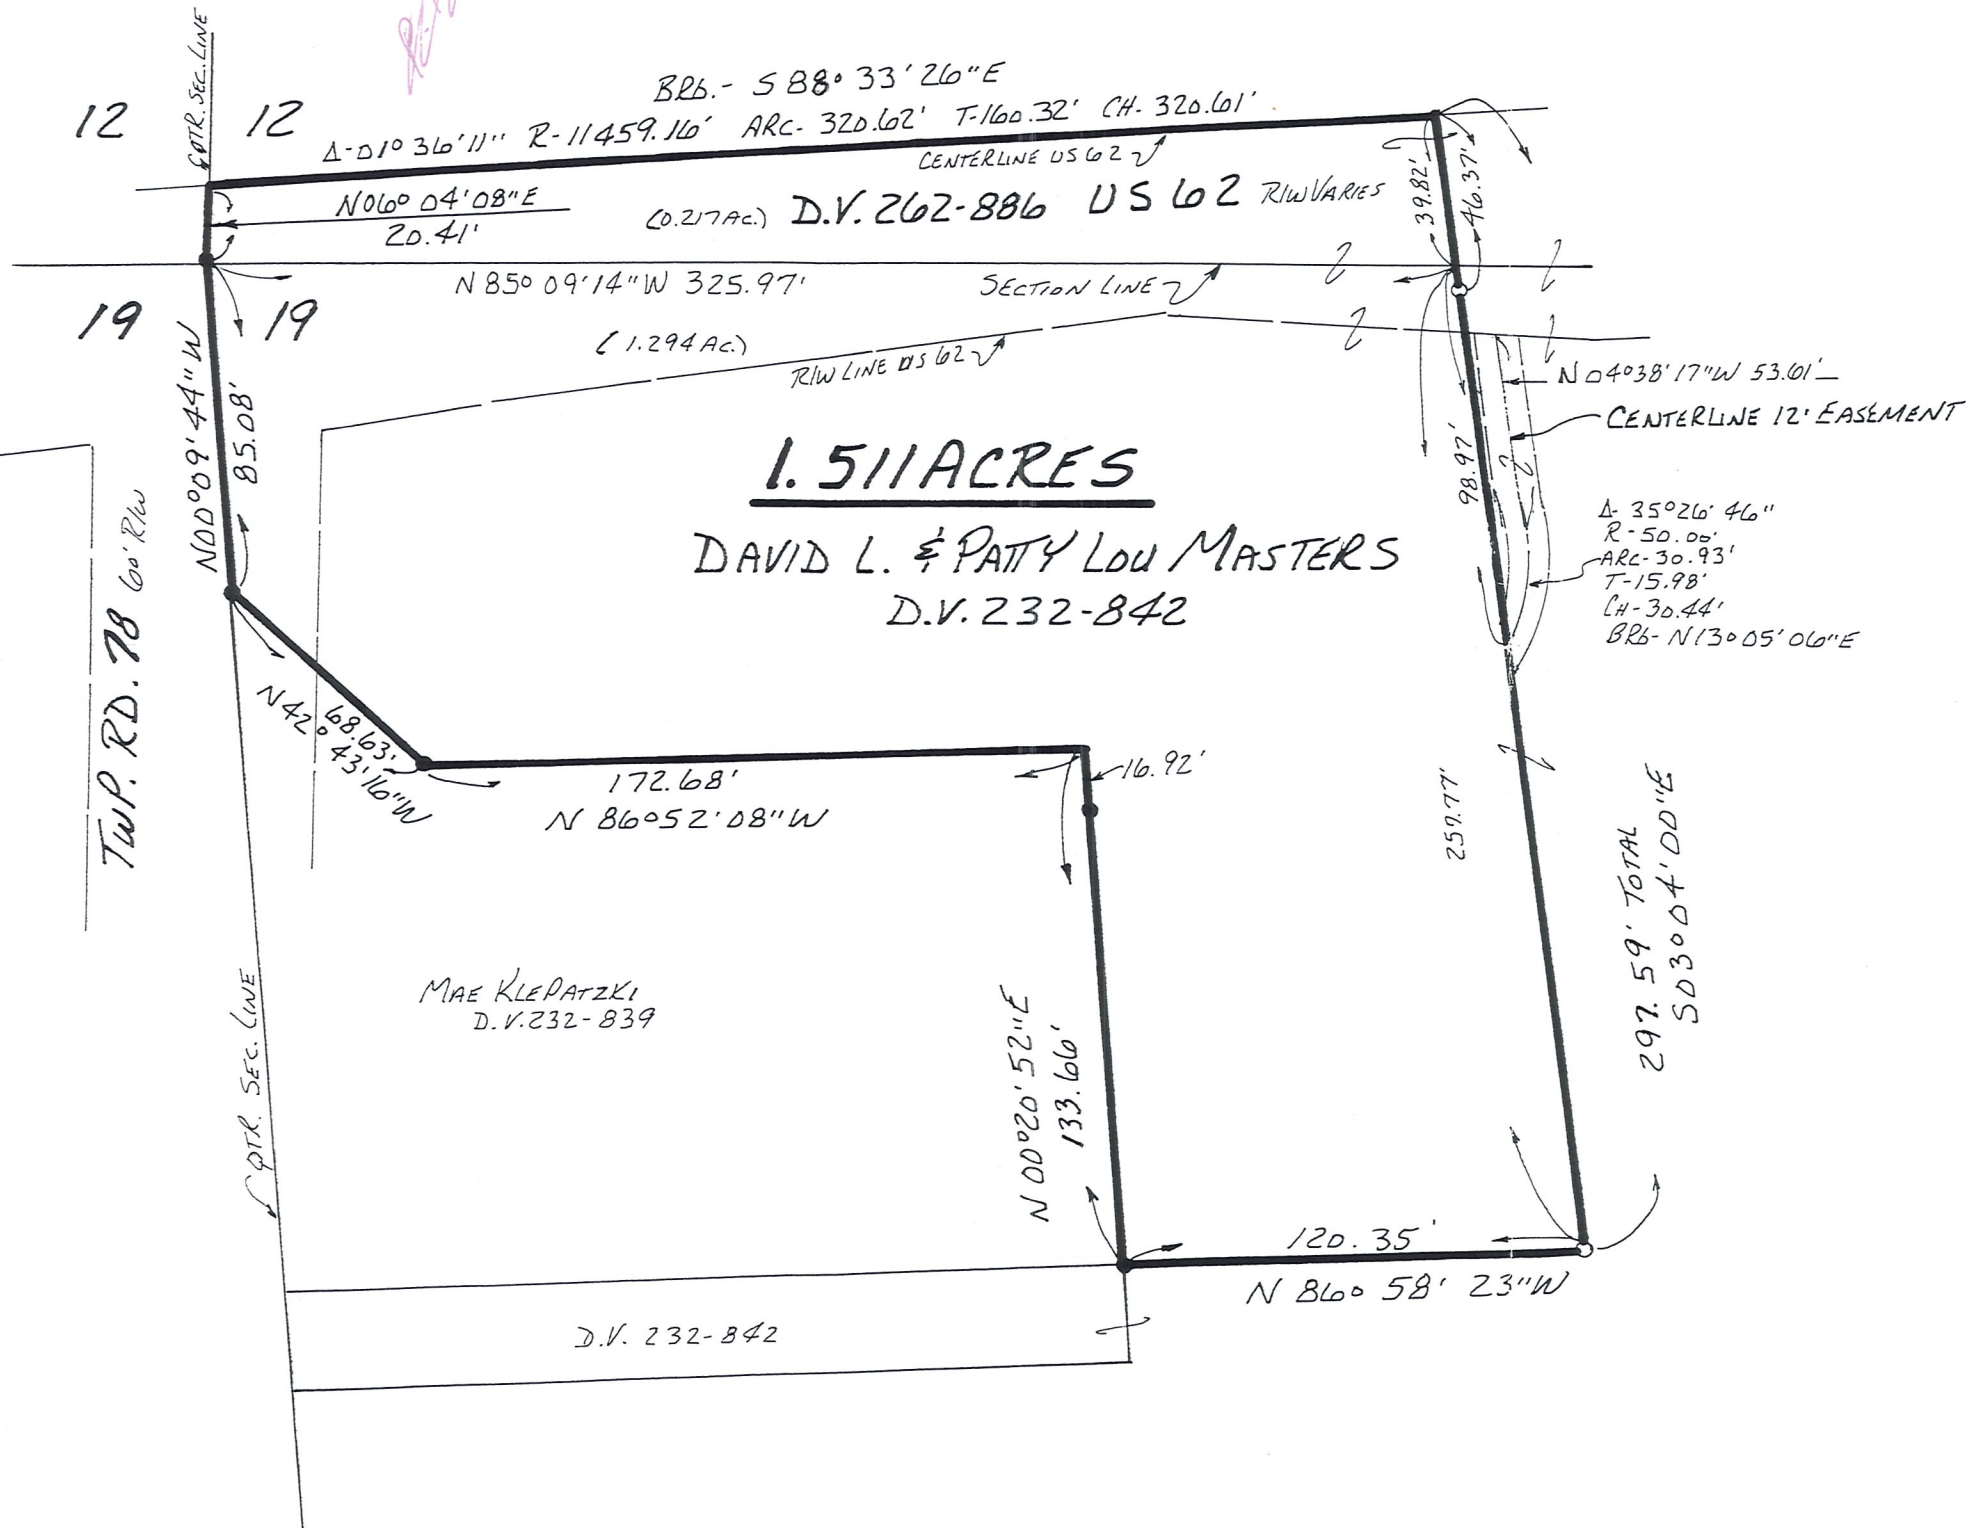

I CERTIFY THIS SURVEY TO BE CORRECT TO THE BEST OF MY KNOWLEDGE.

Jamie D. Darr

JAMIE D. DARR P.S. 7755
 DONALD C. BAKER SURVEYING
 138 N. CLAY ST.
 MILLERSBURG, OHIO 44654
 PH. 330-674-4788

JANUARY 8, 2001

#83600-M.L. DAVIS

F.C.C.-J.D. DARR