


SURVEYED FOR FRANCIS DANNE MILLER


KILLBUCK TOWNSHIP
 N.W. QTR. SECTION 20
 T-8N; R-8W
 HOLMES COUNTY, OHIO

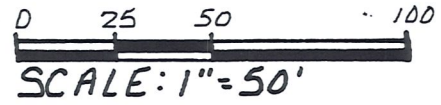

- STONE FOUND
- IRON PIN FOUND
- 5/8" REBAR WITH I.D. CAP SET
- I.D. CAP MARKED "BAKER 6938"

REFERENCES:

DEED Vol. 164 PAGE 227
 " " 205 " 348
 " " 216 " 537

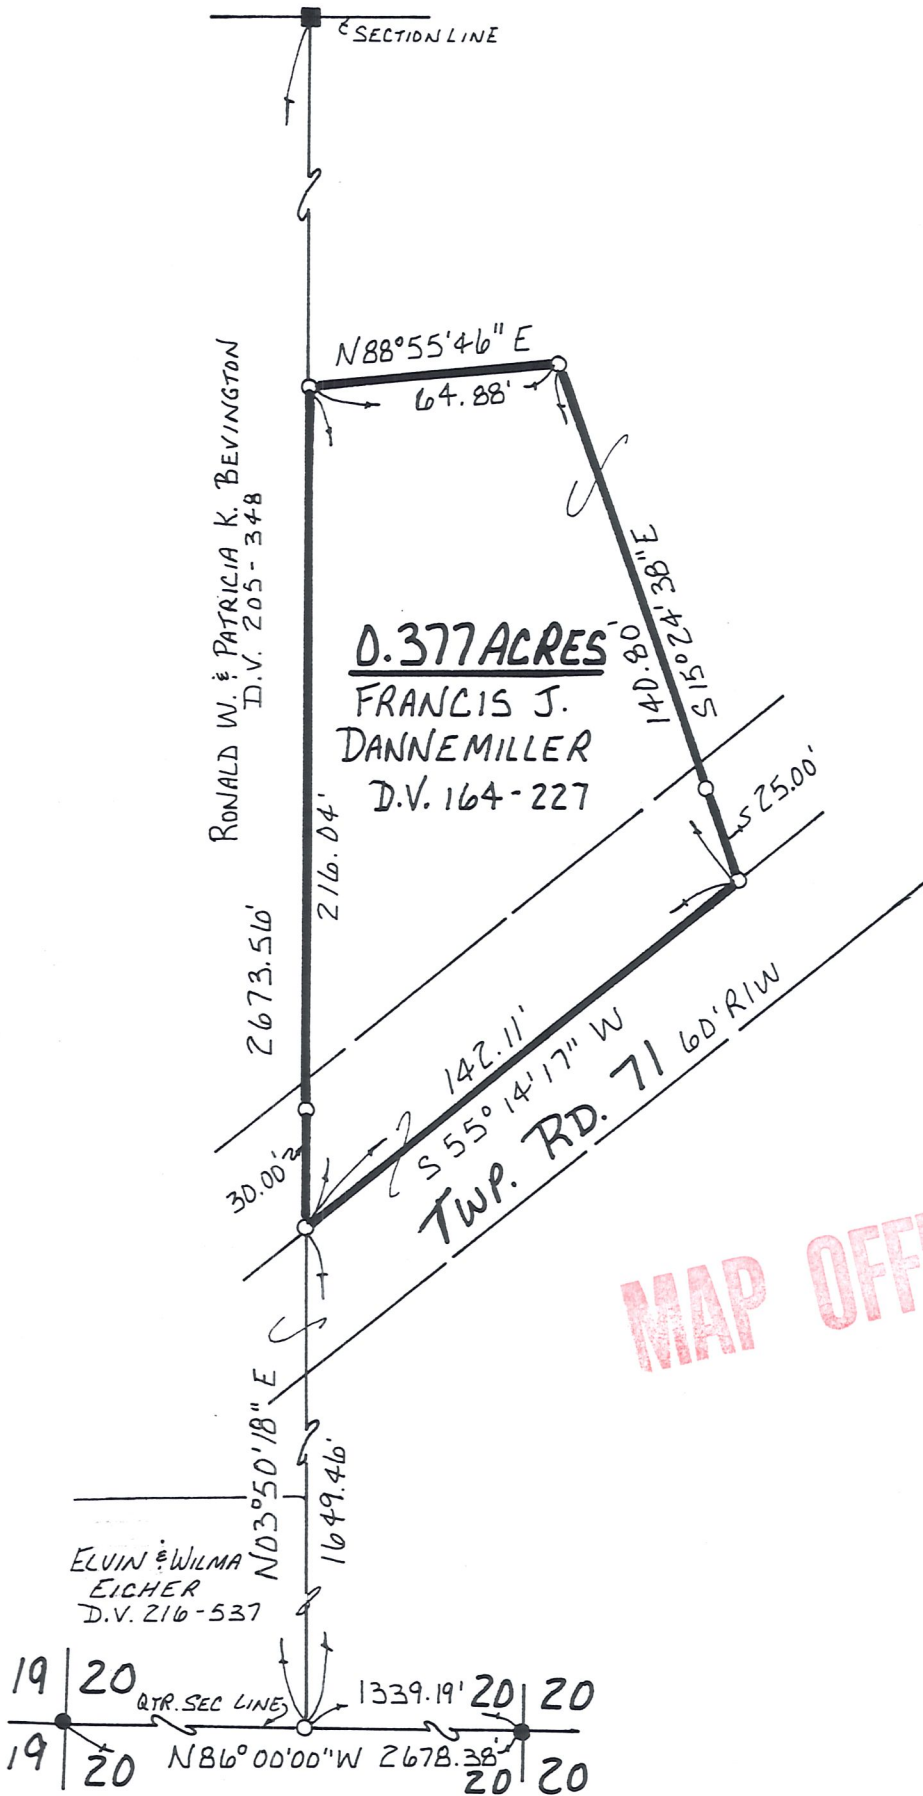

MAP OFFICE COPY



I CERTIFY THIS SURVEY TO BE CORRECT TO THE BEST OF MY KNOWLEDGE.

Donald C. Baker
 DONALD C. BAKER P.S. 6938
 138 N. CLAY ST.
 MILLERSBURG, OHIO 44654
 PH: (330) 674-4788
 JUNE 5, 1998
 #45198 - FJM
 F.C.C. - F.D. BAKER