



KILLBUCK TOWNSHIP
 N.W. QTR. & S.W. QTR. SEC. 20
 T-8N; R-8W
 HOLMES COUNTY, OHIO

PROPERTY LINE SURVEY
 LINE BETWEEN BARBARA M. MEISTER & ELVIN & WILMA EICHER, FRANCIS DANNEMILLER & WILLIAM L. GARNET R. SCHONAUER PROPERTY.

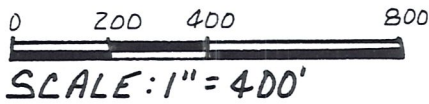

- STONE FOUND
- IRON PIN FOUND
- 5/8" REBAR WITH I.D. CAPSET
- I.D. CAP MARKED "BAKER 6938"

MAP OFFICE COPY

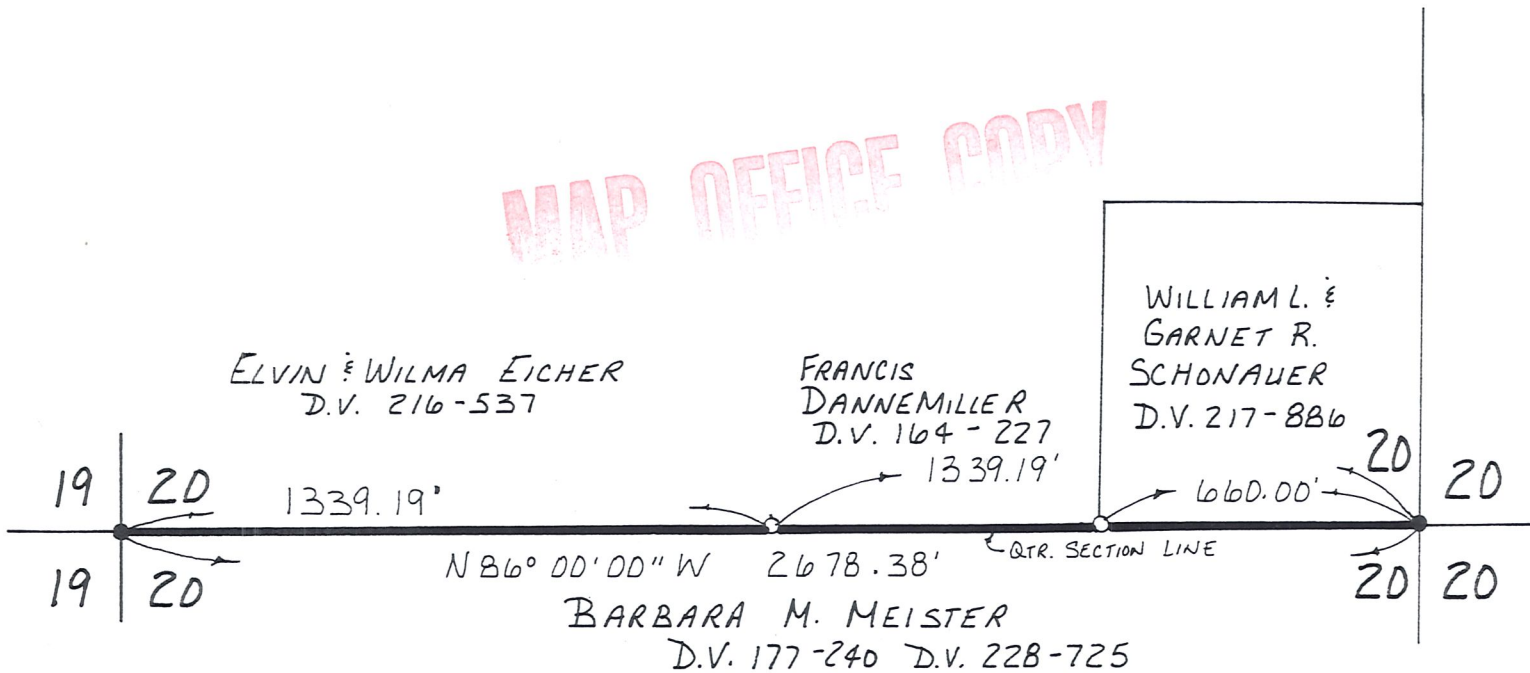

I CERTIFY THIS SURVEY TO BE CORRECT TO THE BEST OF MY KNOWLEDGE.

Donald C. Baker
 DONALD C. BAKER P.S. 6938
 138 N. CLAY ST.
 MILLERSBURG, OHIO 44654
 PH: (330) 674-4788
 JUNE 9, 1998

#42598-FJM
 F.C.C. - F.D. BAKER