S.11E.16

OFFICE COPY

HOLMES CO. TAXMAP OFFICE

KILLBUCK TOWNSHIP
N.W. & S.W. 1/4 SECTION 22
TWP. 8 RANGE 8
HOLMES COUNTY, OHIO

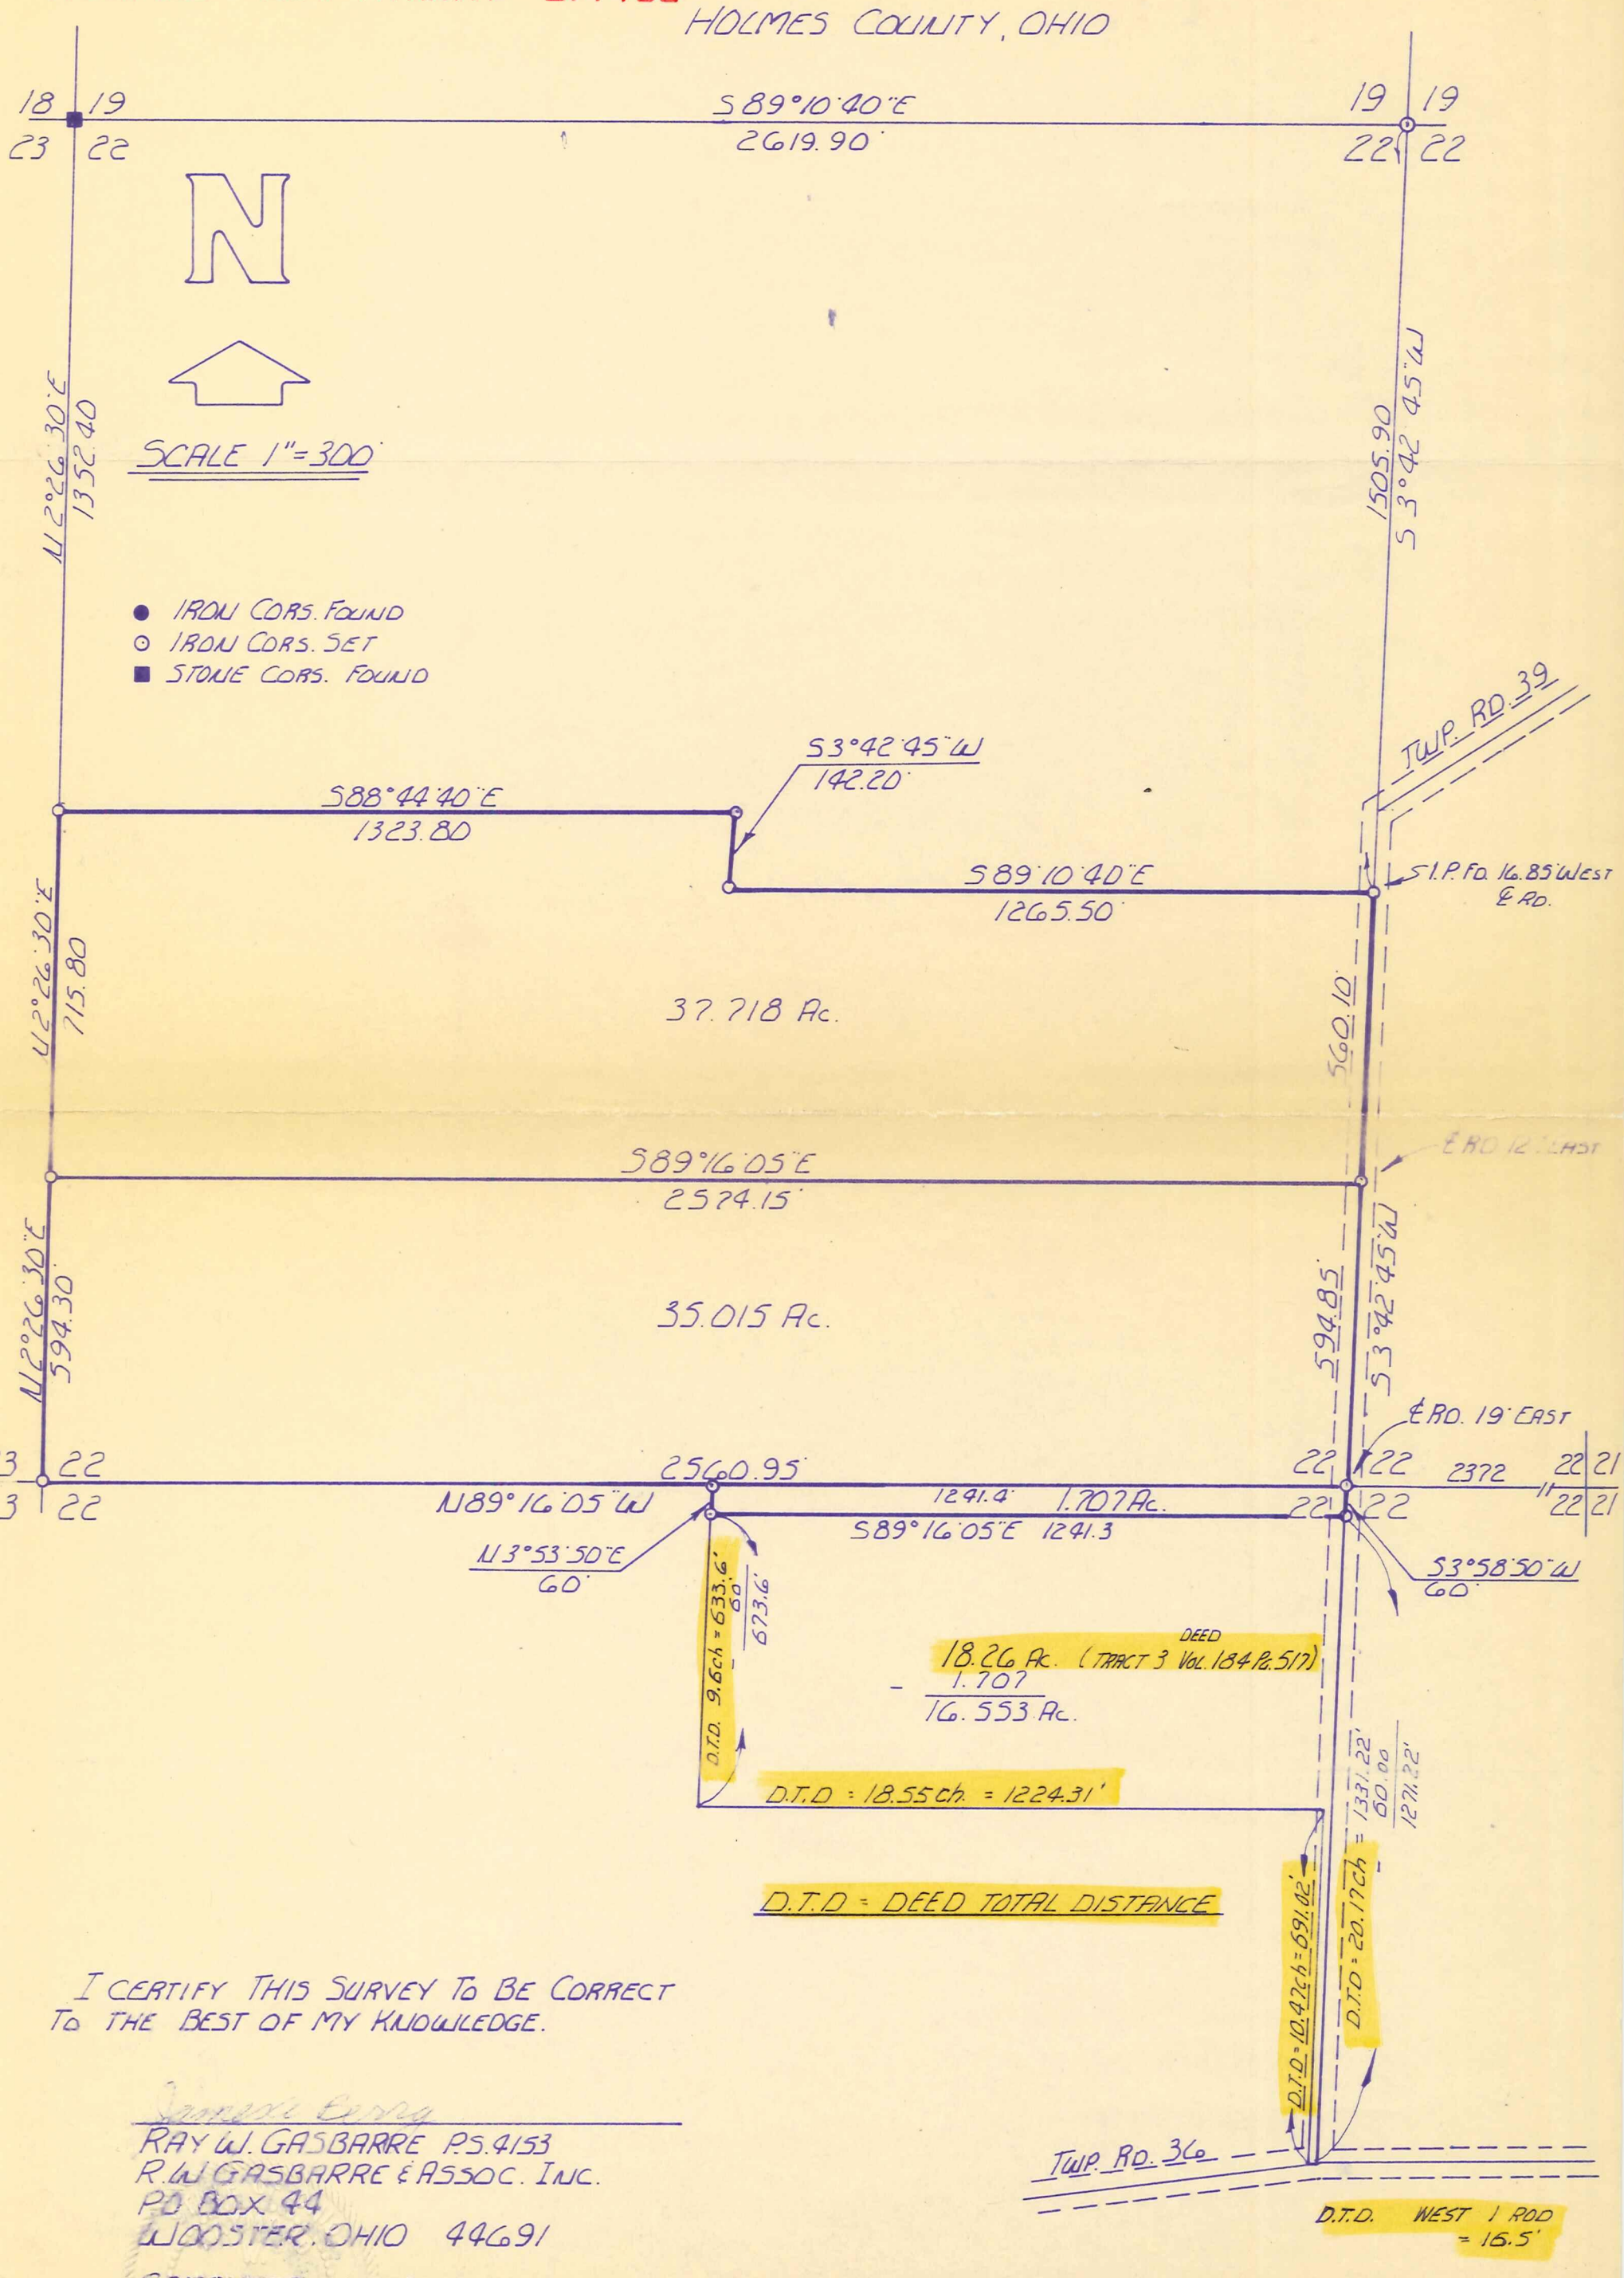

I CERTIFY THIS SURVEY TO BE CORRECT
TO THE BEST OF MY KNOWLEDGE.

RAY W. GASBARRE P.S. 4153
R.W. GASBARRE & ASSOC. INC.
PO BOX 44
WOOSTER, OHIO 44691

COMPLETED 12-27-76
8-17-77 ADDITIONAL INFORMATION ADDED TO 18.26 AC. PARCEL - KNOWN AS TRACT 3 IN DEED VOL. 184 PG. 517