


REFERENCES:

DEED VOL. 227 PAGE 779  
 " " 228 " 725  
 " " 259 " 140  
 O.R. VOL. 10 PAGE 254  
 PLAT VOL. 8 PAGE 42  
 " " 6 " 172  
 " " 9 " 65


KILLBUCK TOWNSHIP  
 N.E. QTR. SECTION 22  
 T-8N;R-8W  
 HOLMES COUNTY, OHIO  
 (SURVEYED FOR: LEVI MILLER)

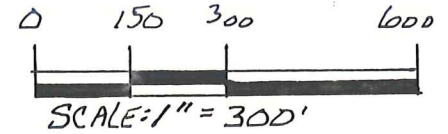

- STONE FOUND
- IRON PIN FOUND
- 5/8" RE BAR WITH I.D. CAP SET  
I.D. CAP MARKED "BAKER 1998"


(A) GARY A. & JANE I. MASTERS  
 1/2 INT. D.V. 259-140  
 ERIC T. & BRENT M. &  
 JOEL C. FIGHTER 1/2 INT.  
 O.R. 10 PAGE 254

BEARINGS FROM PLAT VOL. 8 PG. 42

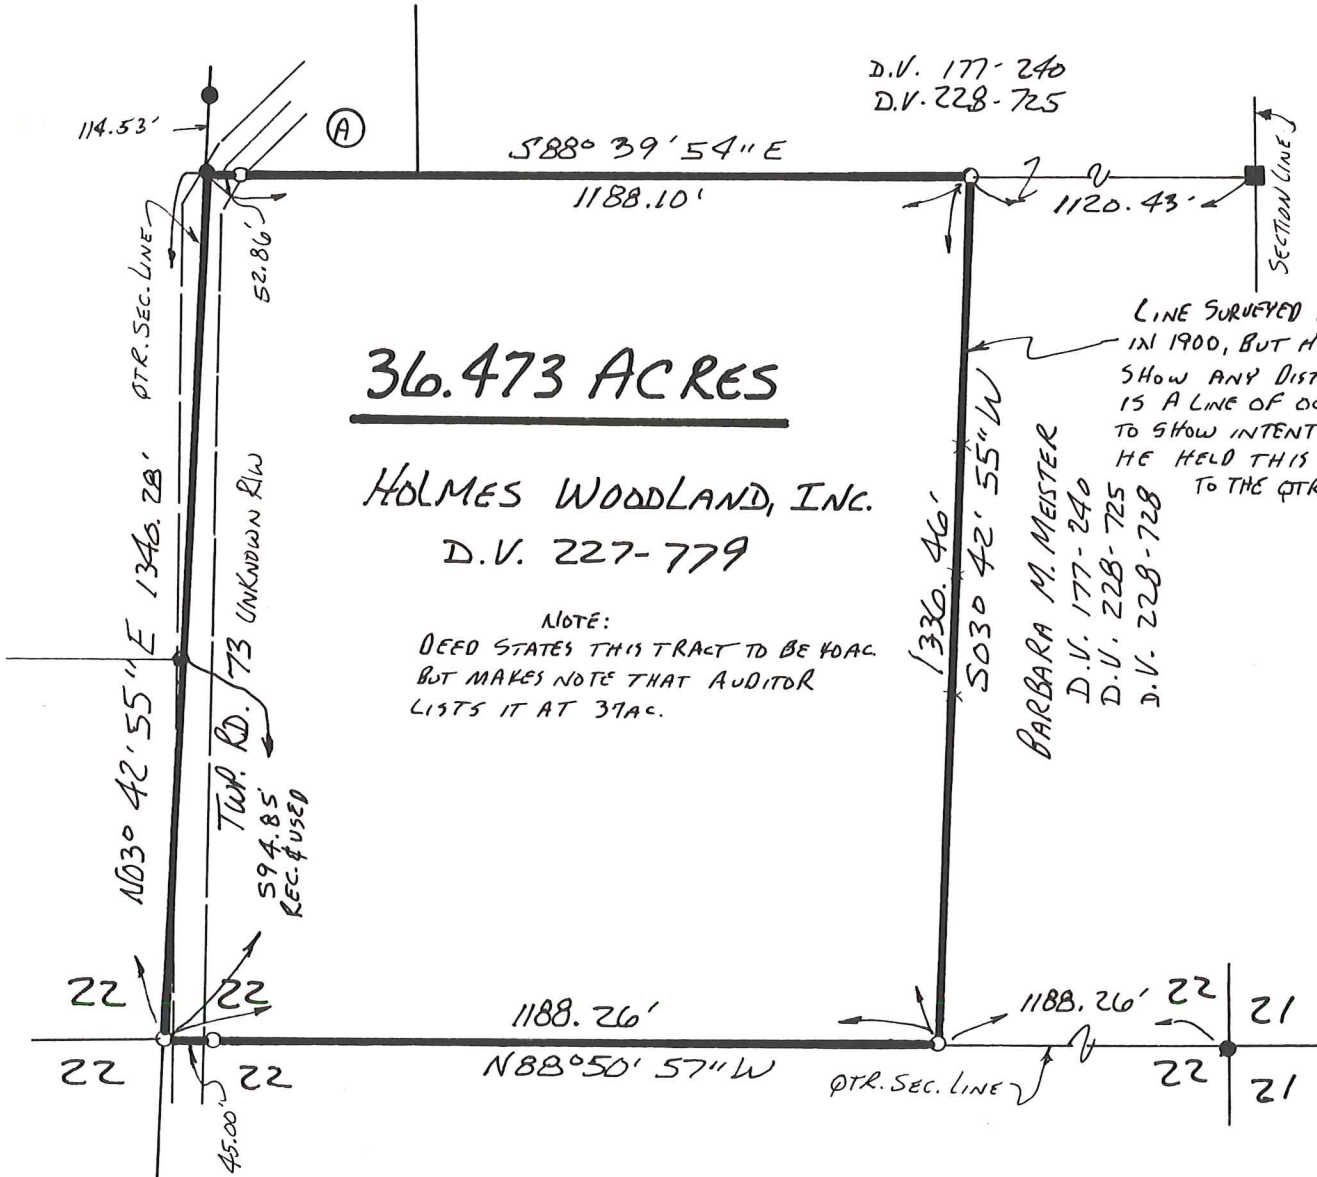

LINE SURVEYED BY ROBISON  
 IN 1900, BUT HE DID NOT  
 SHOW ANY DISTANCES. THERE  
 IS A LINE OF OCCUPATION  
 TO SHOW INTENT IT APPEARS  
 HE HELD THIS LINE PARALLEL  
 TO THE QTR. SECTION LINE

NOTE:  
 DEED STATES THIS TRACT TO BE 40AC  
 BUT MAKES NOTE THAT AUDITOR  

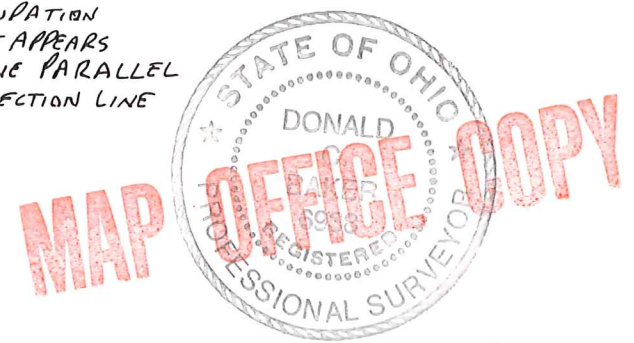

I CERTIFY THIS SURVEY TO BE CORRECT  
 TO THE BEST OF MY KNOWLEDGE.

Donald C. Baker  
 DONALD C. BAKER P.S. 6938  
 138 N. CLAY ST.  
 MILLERSBURG, OHIO 44654  
 PH. (330) 674-4788  
 DECEMBER 24, 1998

#91898-ML DAVIS  
 F.C.C. - F.D. BAKER