

APR 22 '08 AM 10:38


VILLAGE OF NASHVILLE
LOT 123
HOLMES COUNTY, OHIO

SURVEYED FOR: KENNETH & MARY MILLER

REFERENCES

- DEED VOL. 270 PAGE 762
- O.R. VOL. 171 PAGE 395
- PLAT VOL. 1 PAGE 259
- SURVEY BY RAY GASBARRE OF LOTS 127-130 DATED SEPT. 1958
- SURVEY BY EDGAR JOHNSTON OF LOT 120 DATED APRIL 1973
- BEARINGS FROM PLAT VOL. 1 PAGE 259

NOTE: PLAT VOL. 8 PG. 533 SHOWS A 5' ALLEY ALONG THE NORTH LINE OF LOT 129 AND ALSO SHOWS THIS LINE AS THE SECTION LINE. WE DID NOT SURVEY SECTION LINE.

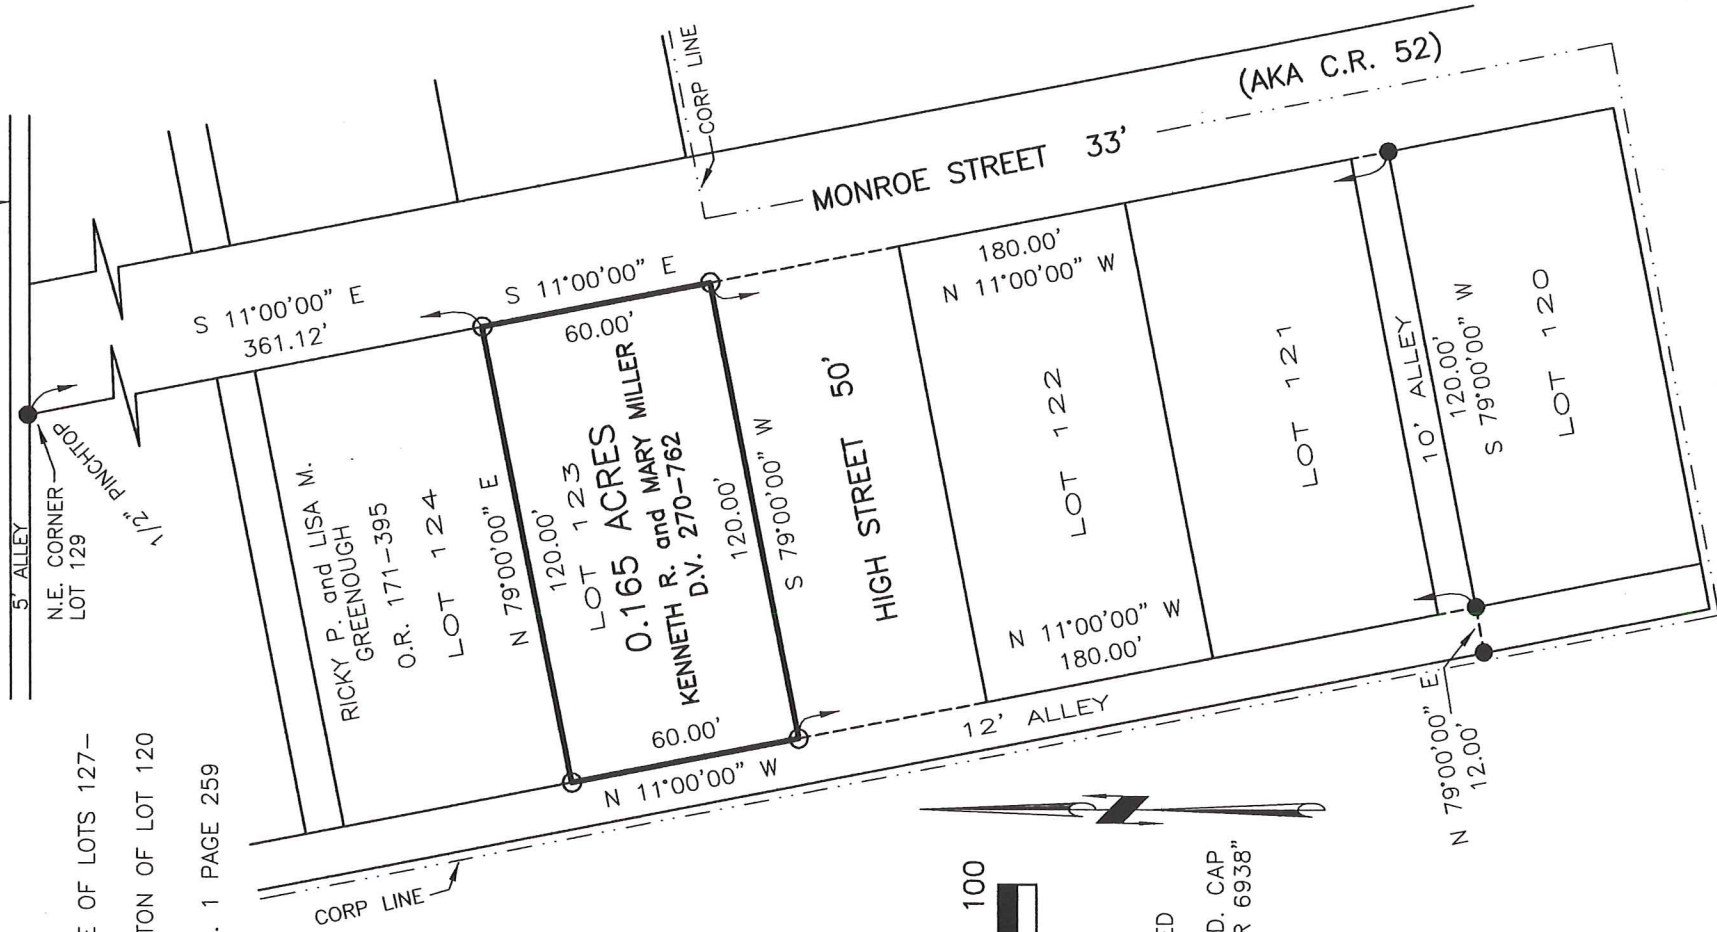

SCALE: 1"=50'

- 1/2" ID PIPE FOUND UNLESS OTHERWISE NOTED
- 5/8" REBAR SET WITH I.D. CAP. I.D. CAP MARKED "BAKER 6938"



I CERTIFY THIS SURVEY TO BE CORRECT TO THE BEST OF MY KNOWLEDGE

PRELIMINARY FOR REVIEW ONLY

JAMIE R. DARR
DATE: APRIL 16, 2008
JDD/DB P.S. 7755
FILE NAME: WORK3\S-160-08\ERZ

DONALD C. BAKER SURVEYING
138 N. CLAY STREET
MILLERSBURG, OHIO 44654
PH. 330-674-4788
FAX 330-674-6027