

HEARTLAND Surveying
 Jim Shamp
 5210 Twp. Rd. 257 Millersburg, OH 44654
 Phone: 216-674-4698

SURVEY		DATE	
HAYWARD / ADAMS		JULY 7, 1992	
STATE	COUNTY	TOWNSHIP	RANGE
OHIO	HOLMES	KNOX	14 WEST
TOWNSHIP		S.E. QUARTER	
17 NORTH		SECTION 19	

CHRISTINE ANN HAYWARD
 8
 SARAH LOUISE ADAMS
 V. 216, P. 969

QTR. SEC. LN.

LEGEND:


- = I.P. FOUND
- = I.P. SET (5/8" X 30" RE-BAR W/ PLASTIC CAP MARKED "JIM SHAMP - 6088")

* BEARINGS ESTABLISHED FROM PLAT VOL. 9, PG. 127

~~35.000 ACRES~~
~~-5.000 ACRES~~
~~30.000 ACRES~~
 REMAINING

5.000 ACRES

GEORGE WILLARD FRITZ
 V. 130, P. 291

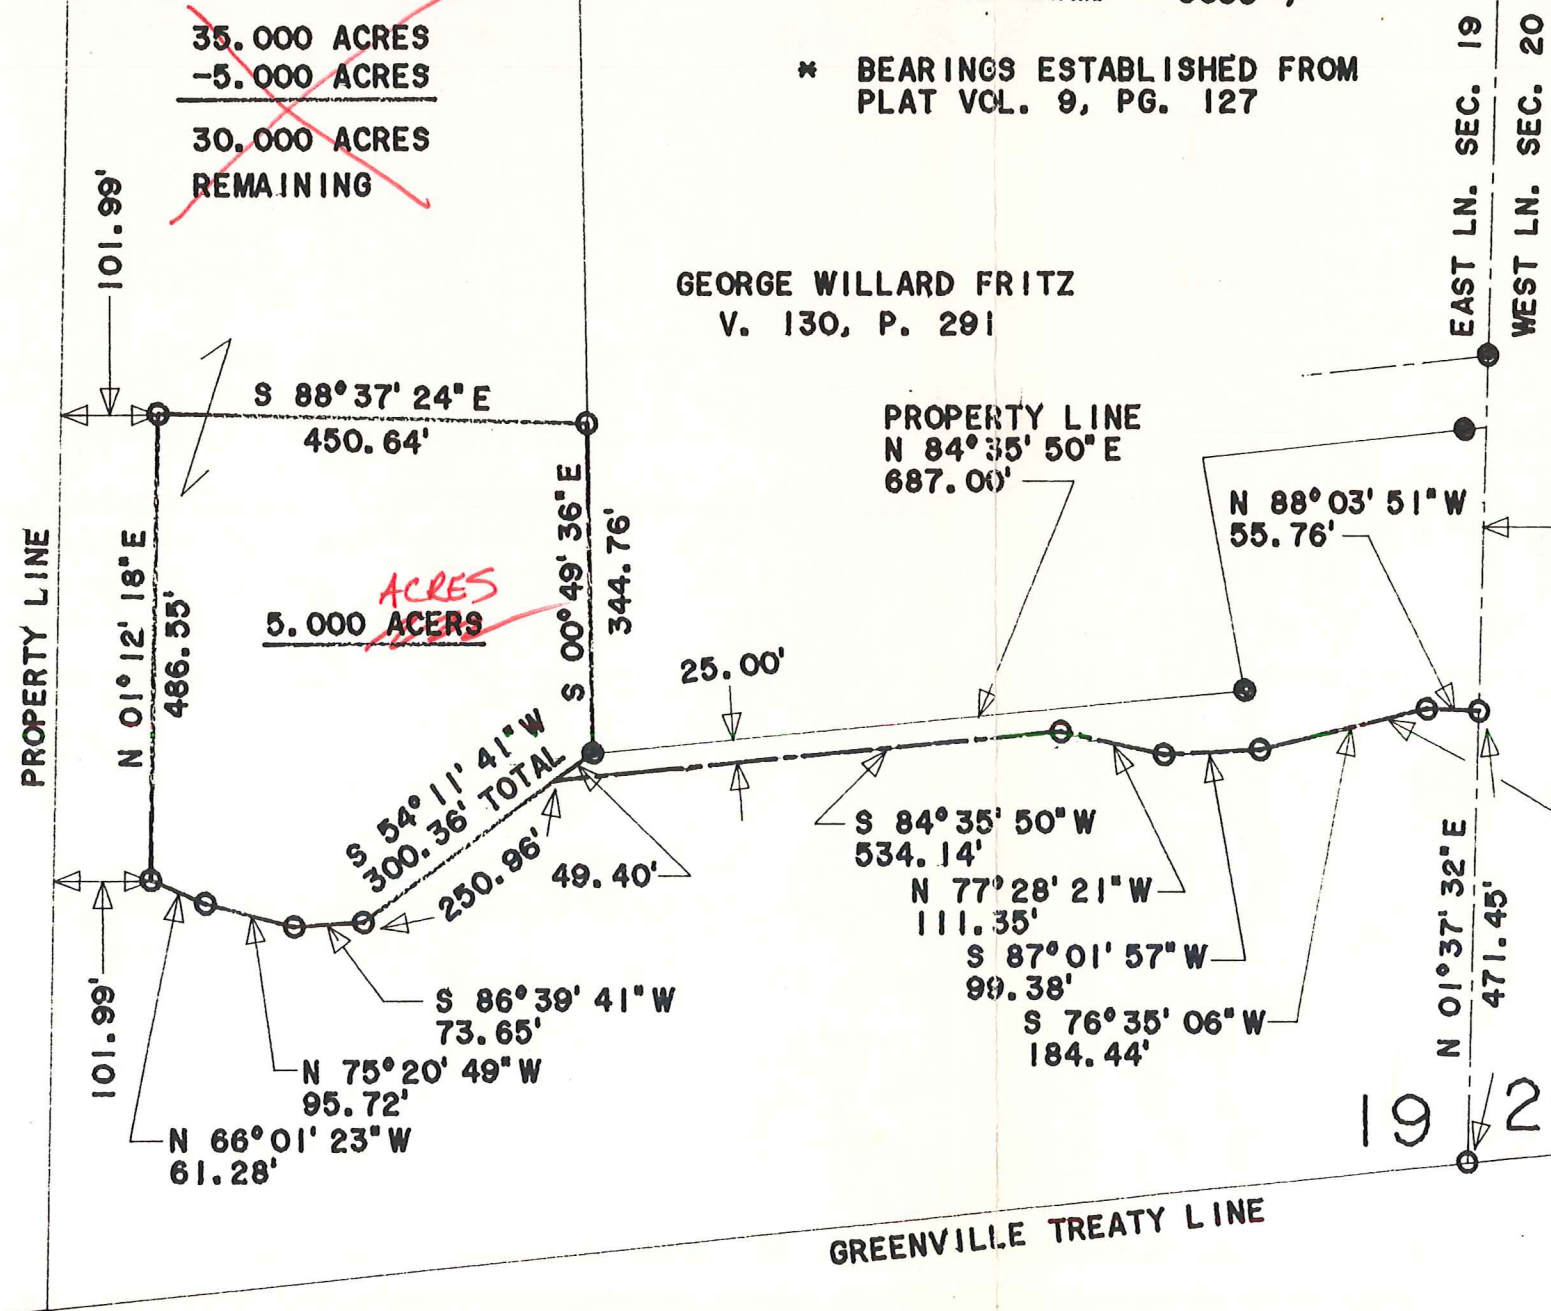

I CERTIFY THIS TO BE A TRUE PLAT OF A FIELD SURVEY COMPLETED ON JUNE 19, 1992:

J. Shamp
 JIM SHAMP, REG. SUR. NO. S-6088

MAP OFFICE



C/L T.R. 501
 60' R/W

C/L 50' R/W (25' EACH SIDE) FROM C/L T.R. 501 TO A 5.000 ACRE PARCEL

DOCUMENTS:

- DEEDS AS SHOWN
- TAX MAP
- PLAT V. 9, P. 127

19 20