

0 50 100 200  
 SCALE: 1" = 100'  
 ▲ R.R. SPIKE FOUND  
 ● IRON PIN FOUND  
 ○ 5/8" RE BAR WITH I.D. CAP SET  
 I.D. CAP MARKED "BAKER 6938"




KNOX TOWNSHIP WASHINGTON TOWNSHIP  
 N.E. QTR. SECTION 19 S.E. QTR. SECTION 18  
 T-19N; R-15W, HOLMES COUNTY, OHIO  
 (SURVEYED FOR: NICK CHILDS)

REFERENCES:  
 DEED VOL. 278 PAGE 119  
 " " 268 " 350  
 " " 113 " 507

PLAT OF CORRECTION OF PLAT VOL. 8 PAGE 256

BEARINGS FROM PLAT VOL. 8 PAGE 256.

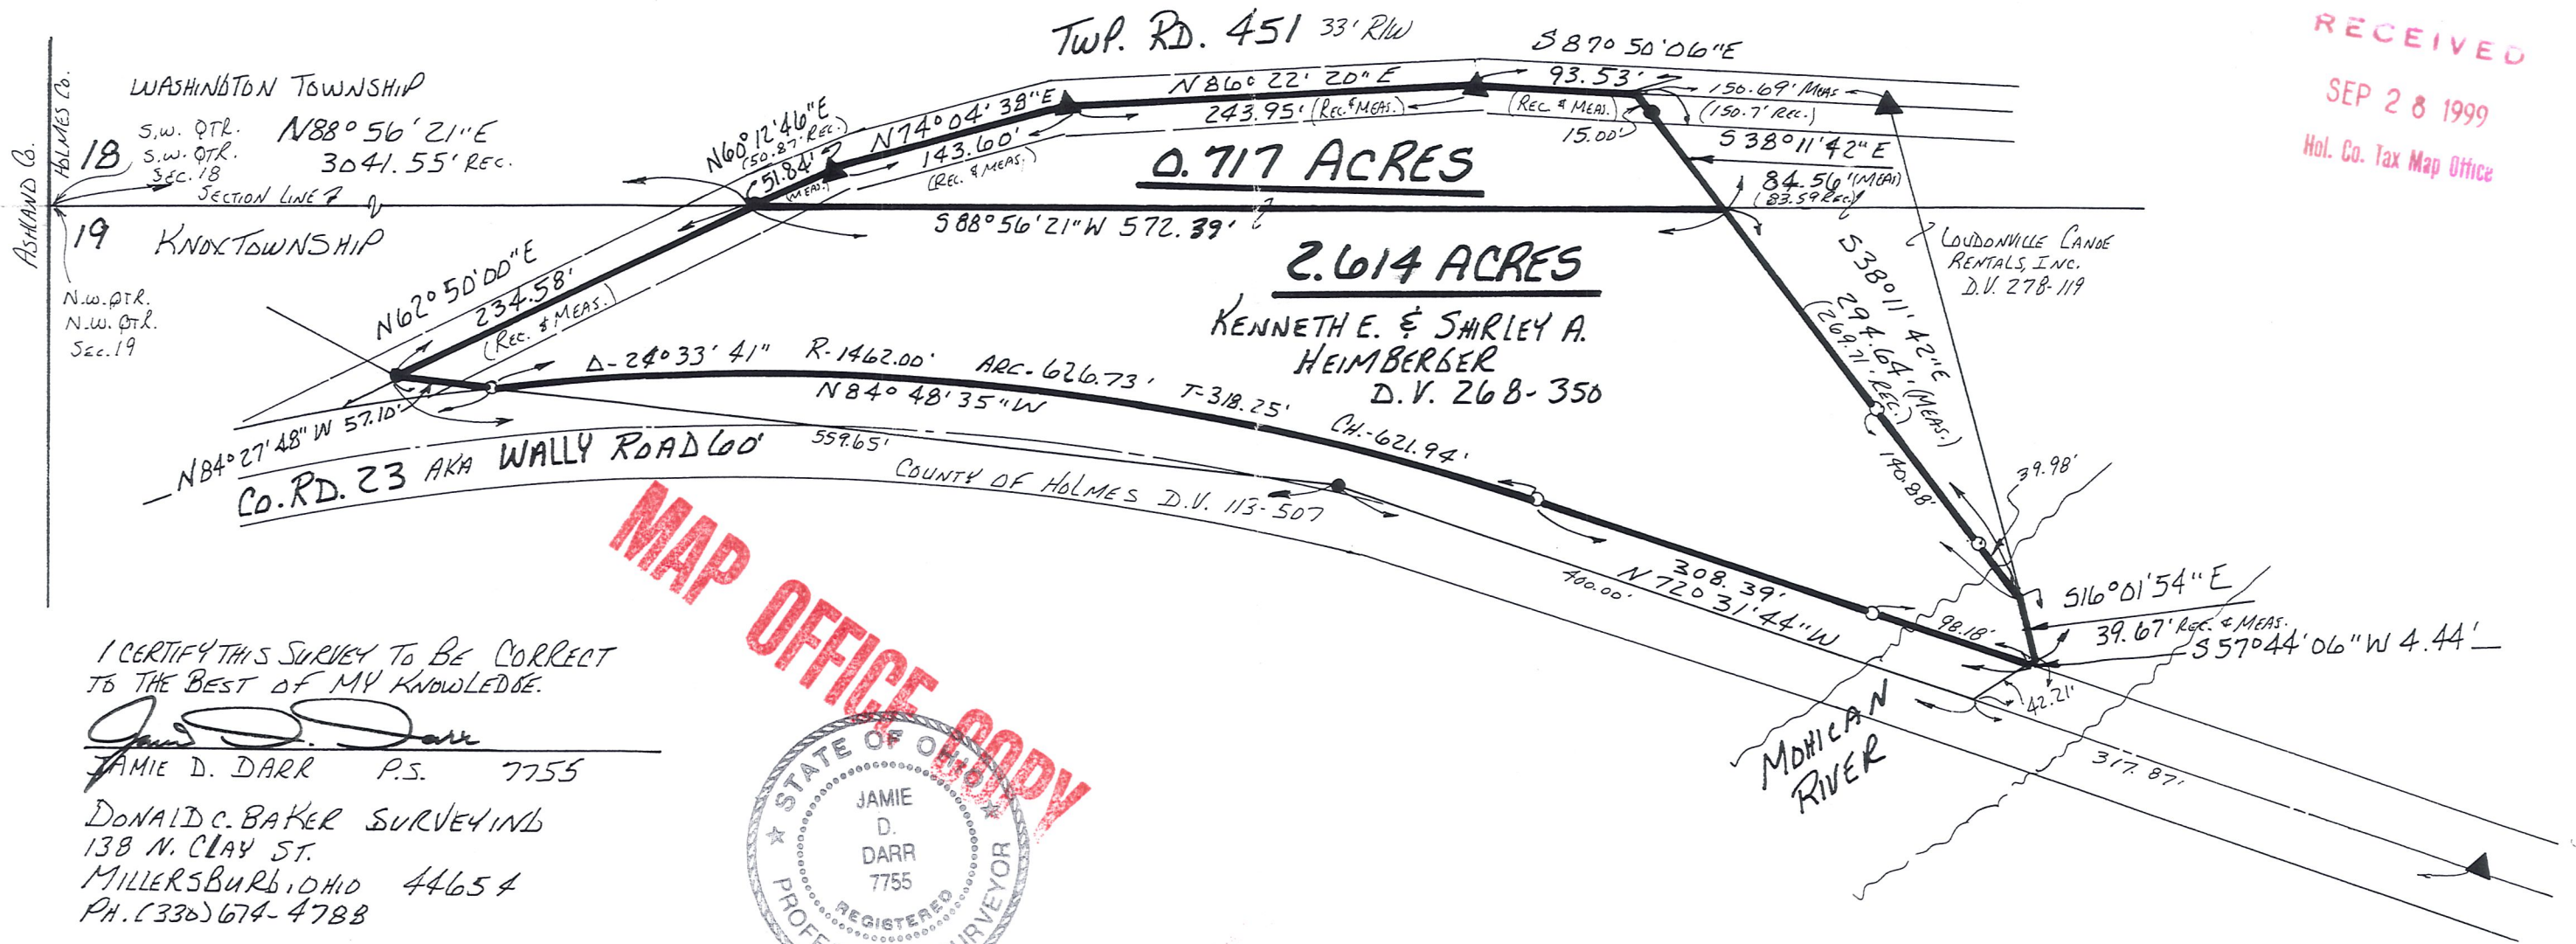

RECEIVED  
 SEP 28 1999  
 Hol. Co. Tax Map Office

MAP OFFICE COPY  
 STATE OF OHIO  
 JAMIE D. DARR  
 7755  
 REGISTERED PROFESSIONAL SURVEYOR

I CERTIFY THIS SURVEY TO BE CORRECT  
 TO THE BEST OF MY KNOWLEDGE.  
 JAMIE D. DARR P.S. 7755  
 DONALD C. BAKER SURVEYING  
 138 N. CLAY ST.  
 MILLERSBURG, OHIO 44654  
 PH. (330) 674-4788  
 SEPTEMBER 24, 1999  
 # 58199 - M.L. DAVIS  
 F.C.C. - J.D. DARR