

Bearings Assumed

- I.P. Found
- Stone Found
- I.P. Set - 5/8" Bar With Yellow Cap Marked "LONG-6505"

References:  
 Curry's Add'n-Deed Vol 7, Pg 306  
 My Survey Of Lot 66 Dated 10-2-82  
 Plat Vol 8, Pg 265  
 Village Map Dated 1925  
 Other Deeds As Shown

MAP OFFICE COPY

Ref. To Stone

♂ SW 10.2  
 Guy NW. 9.5'  
 I.P. E 20.0

Acreage Breakdown:

Washington Twp	
Lot 2	0.038
Lot 1	0.142
Lot 117	0.143
} (In Village)	
Knox Twp	
O.L. 158	0.584 (In Village)
Sec. 24	0.310 (Outside Village)
<b>Total</b>	<b>1.218 Ac. (Small Var. Due To Rounding)</b>


I Certify This Survey To Be Correct To The Best Of My Knowledge.  
William H. Long May 3, 1985  
 William H. Long R.S. 6505  
 13301 T.R. 503  
 Big Prairie, Ohio 44611

WASHINGTON TOWNSHIP  
 LOTS 1, 2, 417 VILLAGE OF NASHVILLE  
 SE QTR. SEC 13, T-19N, R-15W

KNOX TOWNSHIP  
 O.L. 158 VILLAGE OF NASHVILLE  
 NE QTR. SEC. 24, T-19N, R-15W

A Survey Of Land Owned By Jack M. Carpenter  
 Deed Vol. 218, Pg. 288  
 Deed Vol. 218, Pg. 177

Note: What Is Now Known As Lot 117 Was Never Platted. Vol 61, Pg 299 Starnes To T. Crum Says: "Bounded On North By The State Road" Which Had A 60' R/W According To A 1924 Set Of State Plans. Therefore I Am Using 30' Em &.

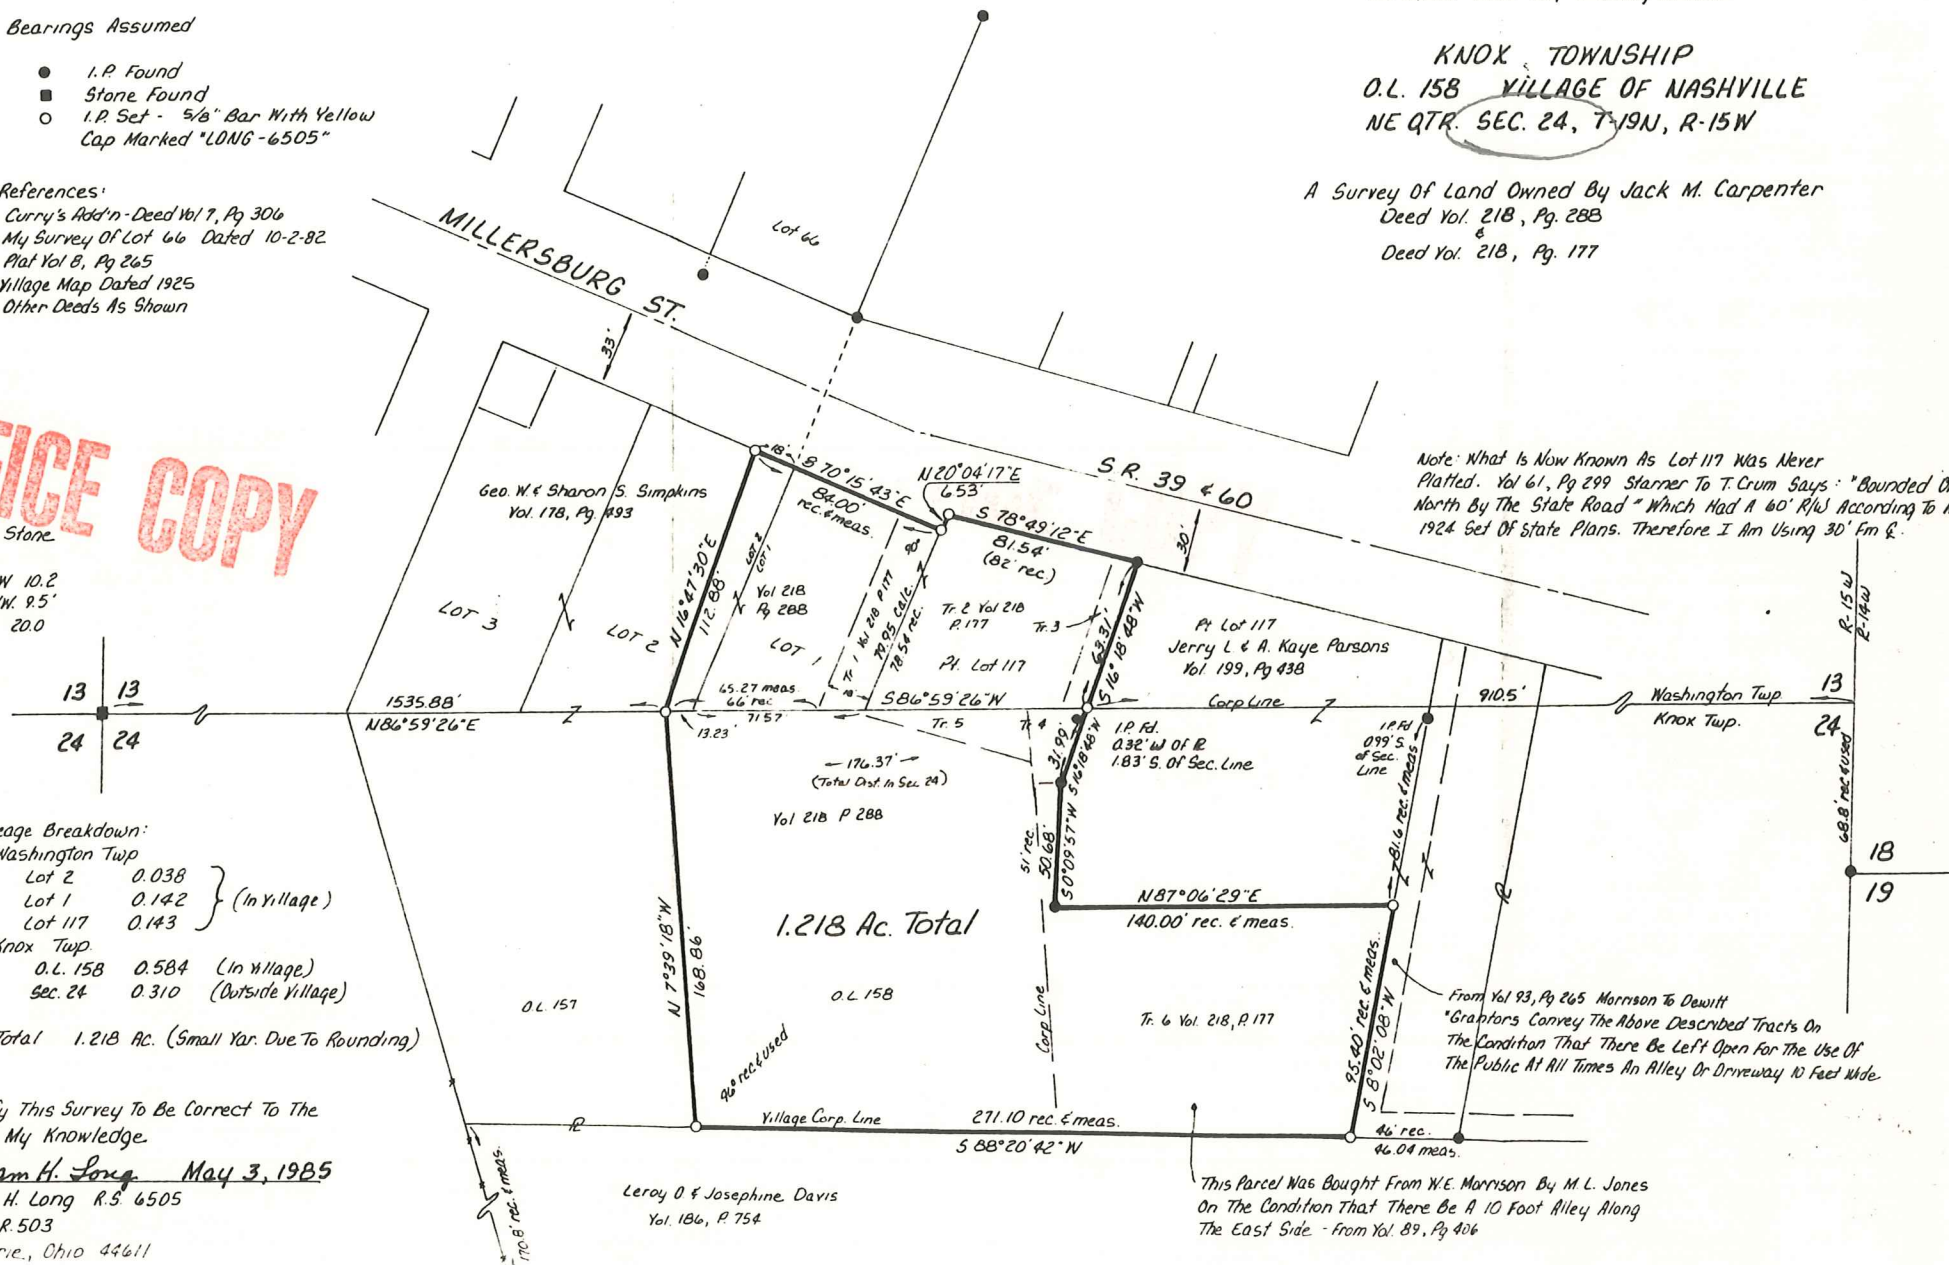

Leroy O & Josephine Davis  
 Vol. 186, P. 754

This Parcel Was Bought From W.E. Morrison By M.L. Jones On The Condition That There Be A 10 Foot Alley Along The East Side - From Vol. 89, Pg 406

From Vol 93, Pg 265 Morrison To Dewitt "Graptors Convey The Above Described Tracts On The Condition That There Be Left Open For The Use Of The Public At All Times An Alley Or Driveway 10 Feet Wide